
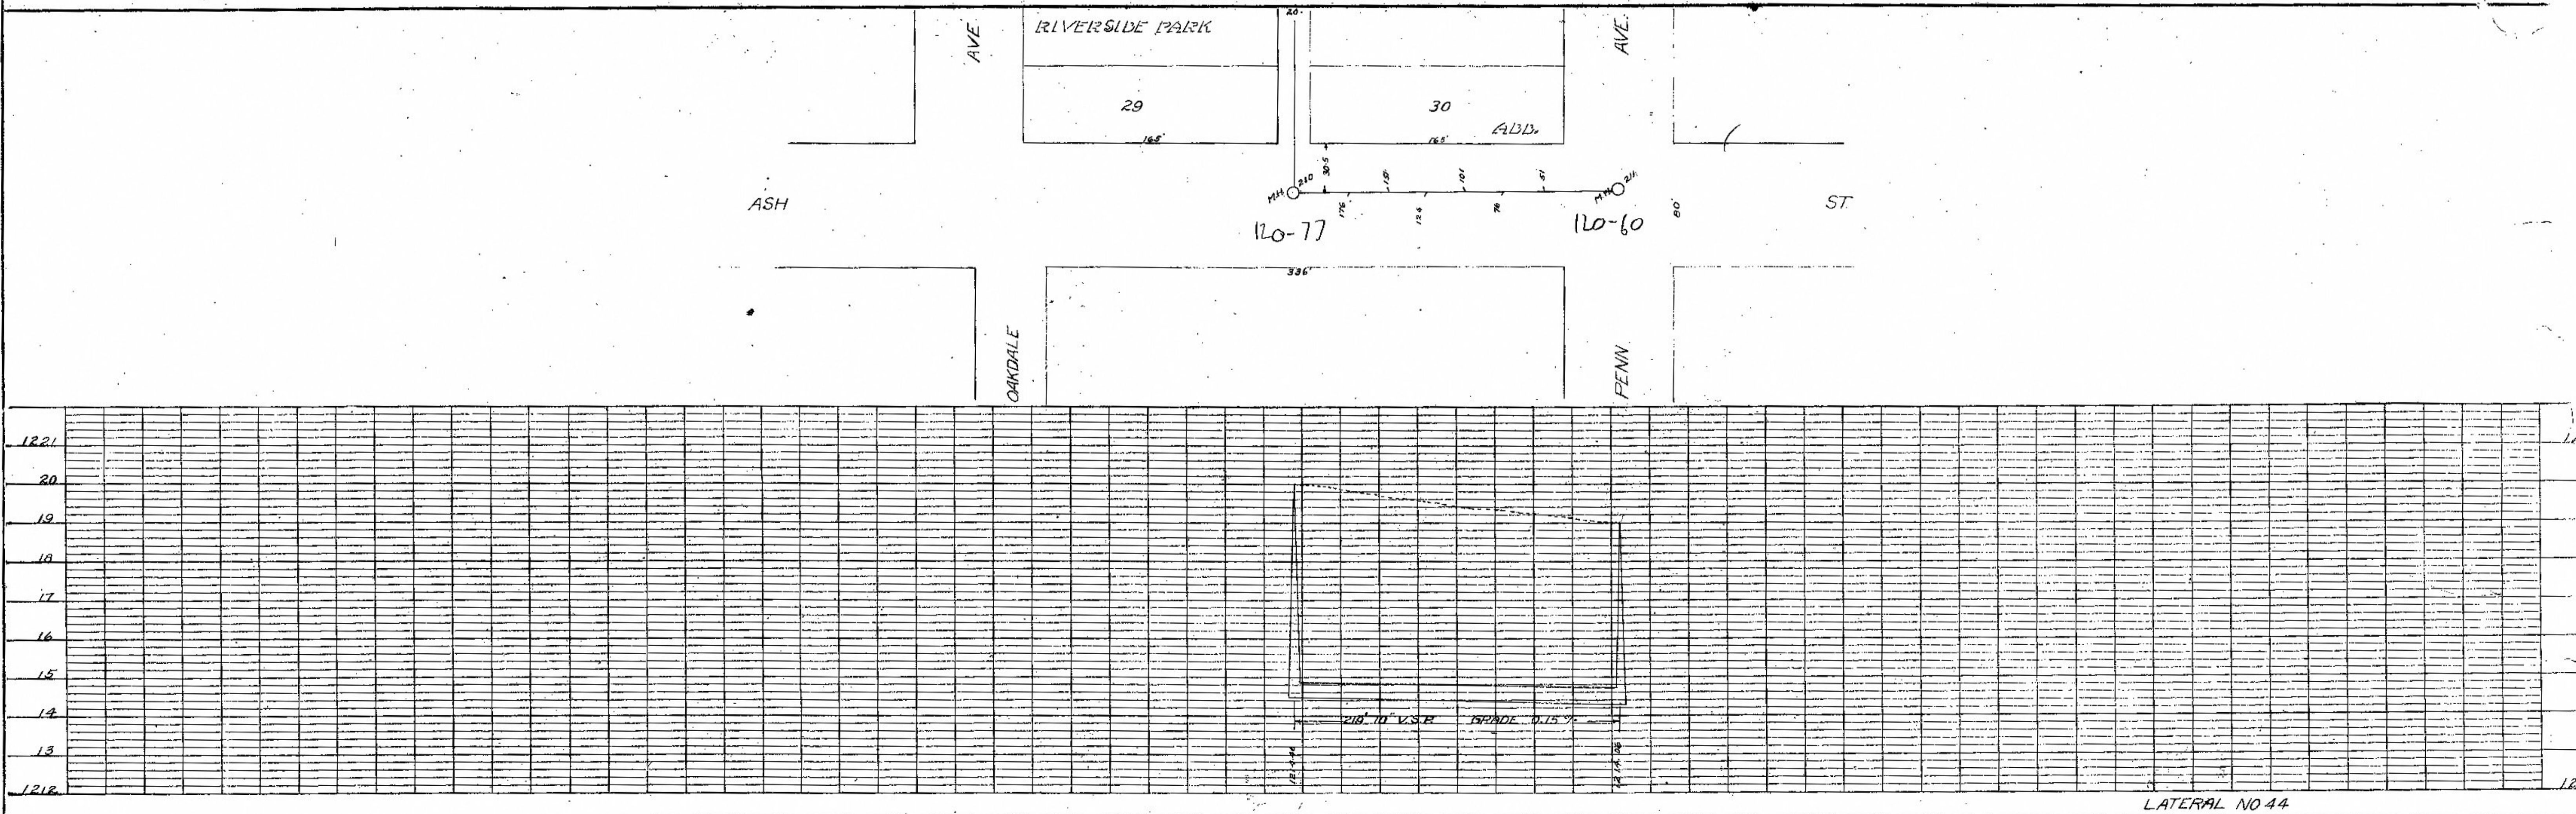


DATE \_\_\_\_\_ BY \_\_\_\_\_  
 PLAN SURVEYED \_\_\_\_\_  
 FLOTTED \_\_\_\_\_  
 NOTE BOOK \_\_\_\_\_  
 NO. \_\_\_\_\_  
 STRUCTURE NOTES CRIC

DATE \_\_\_\_\_ BY \_\_\_\_\_  
 PROFILE SURVEYED \_\_\_\_\_  
 FLOTTED \_\_\_\_\_  
 NOTE BOOK \_\_\_\_\_  
 NO. \_\_\_\_\_  
 STRUCTURE NOTES CRIC

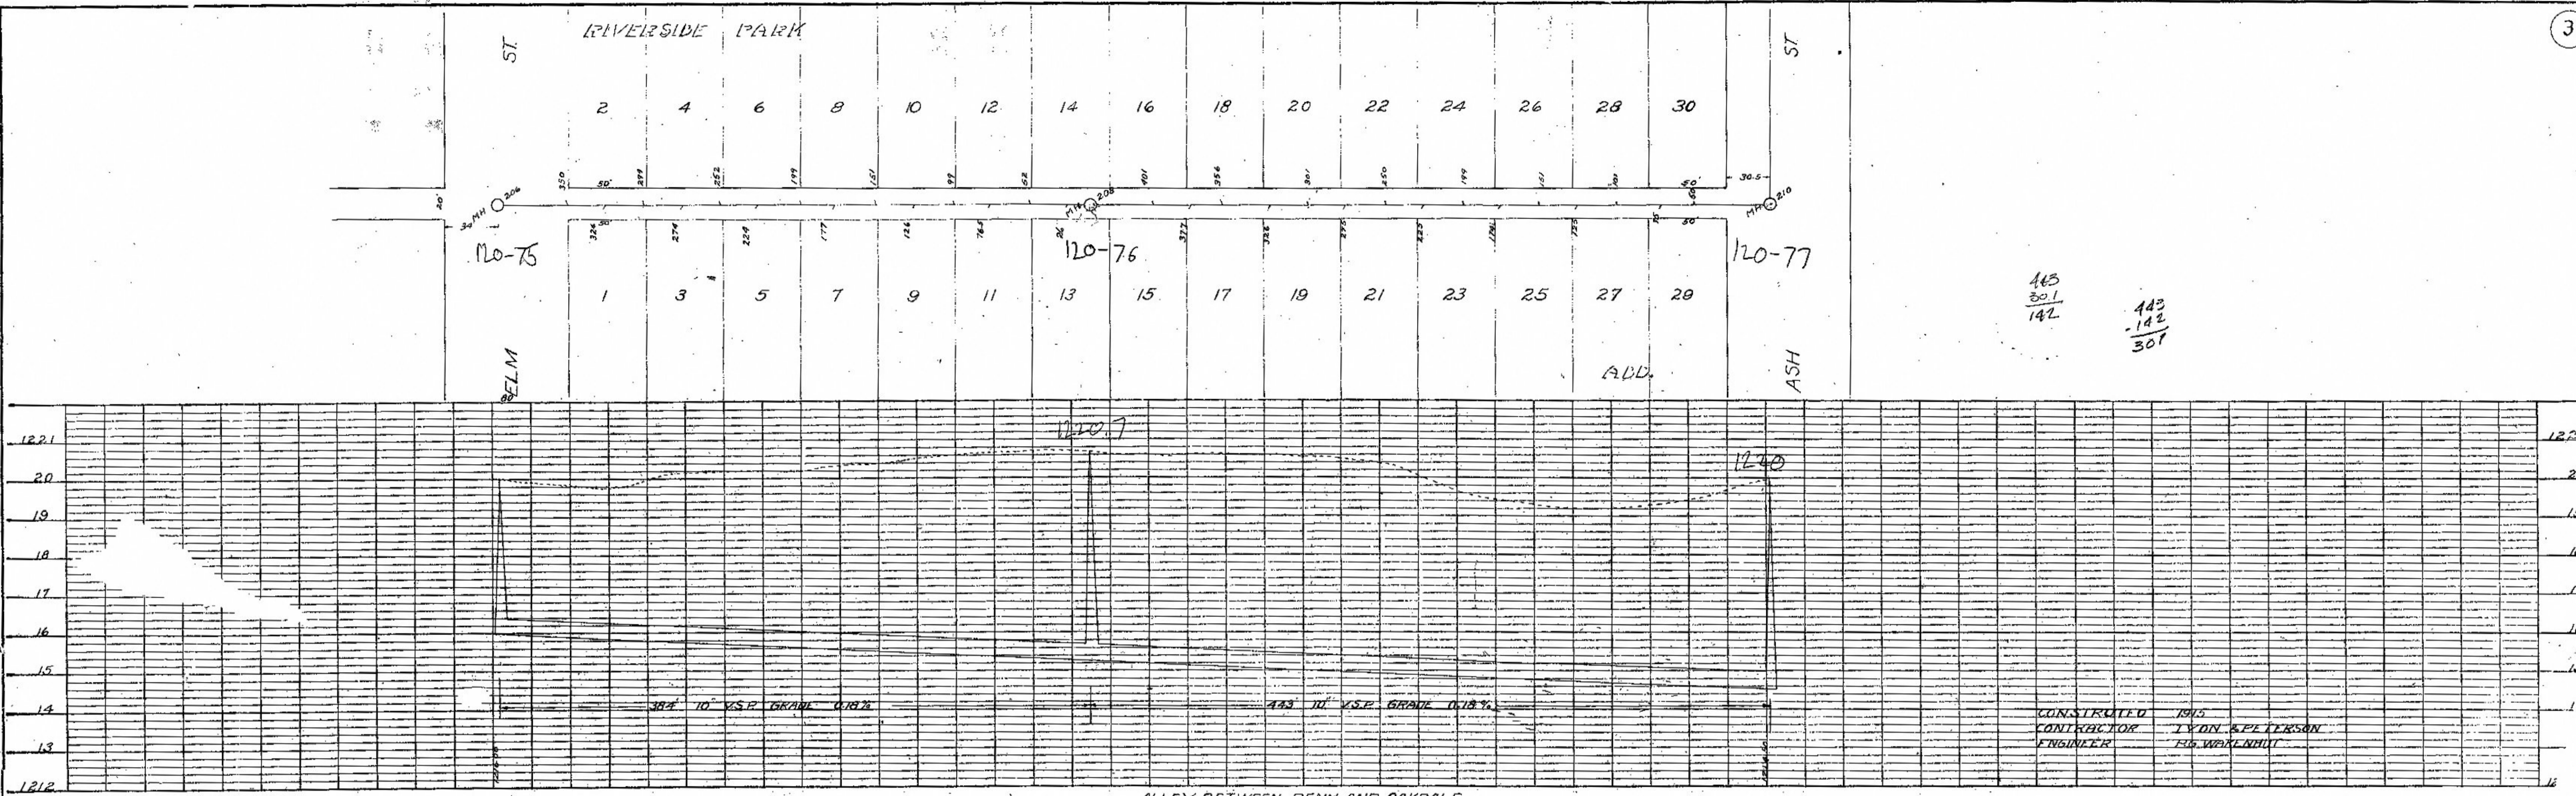

LATERAL NO 44