

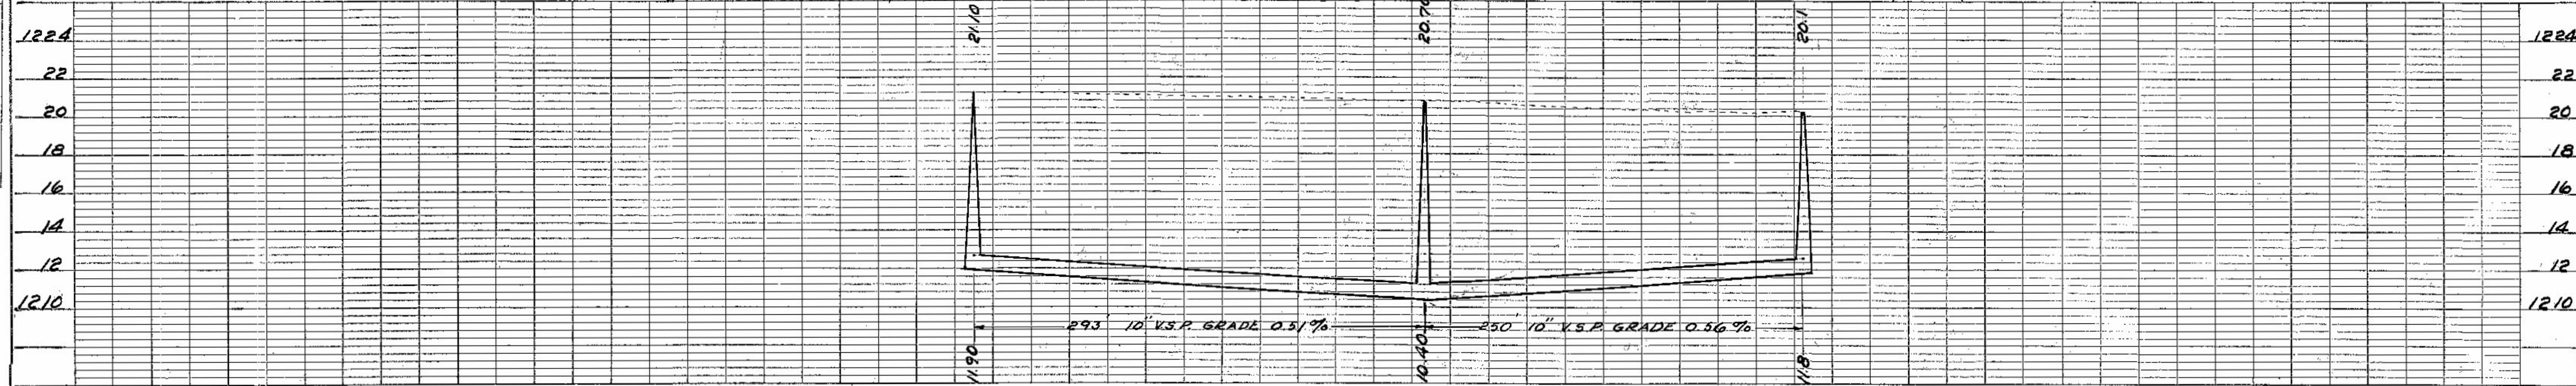
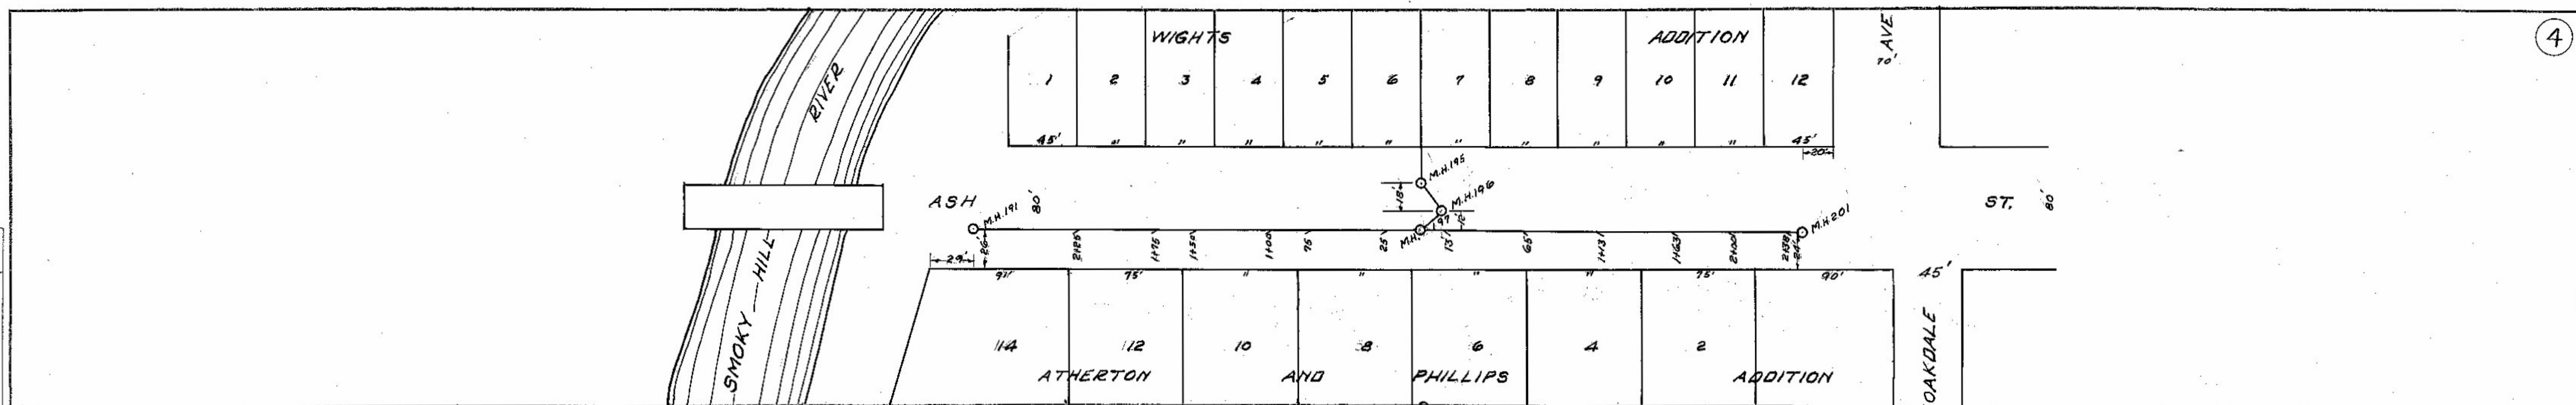


4

DATE  
BY  
H.E.B.  
S.E.B.  
SURVEYED  
NOTE BOOK  
ALIGNED CHECKED  
RT. OF WAY CHECKED  
NO.

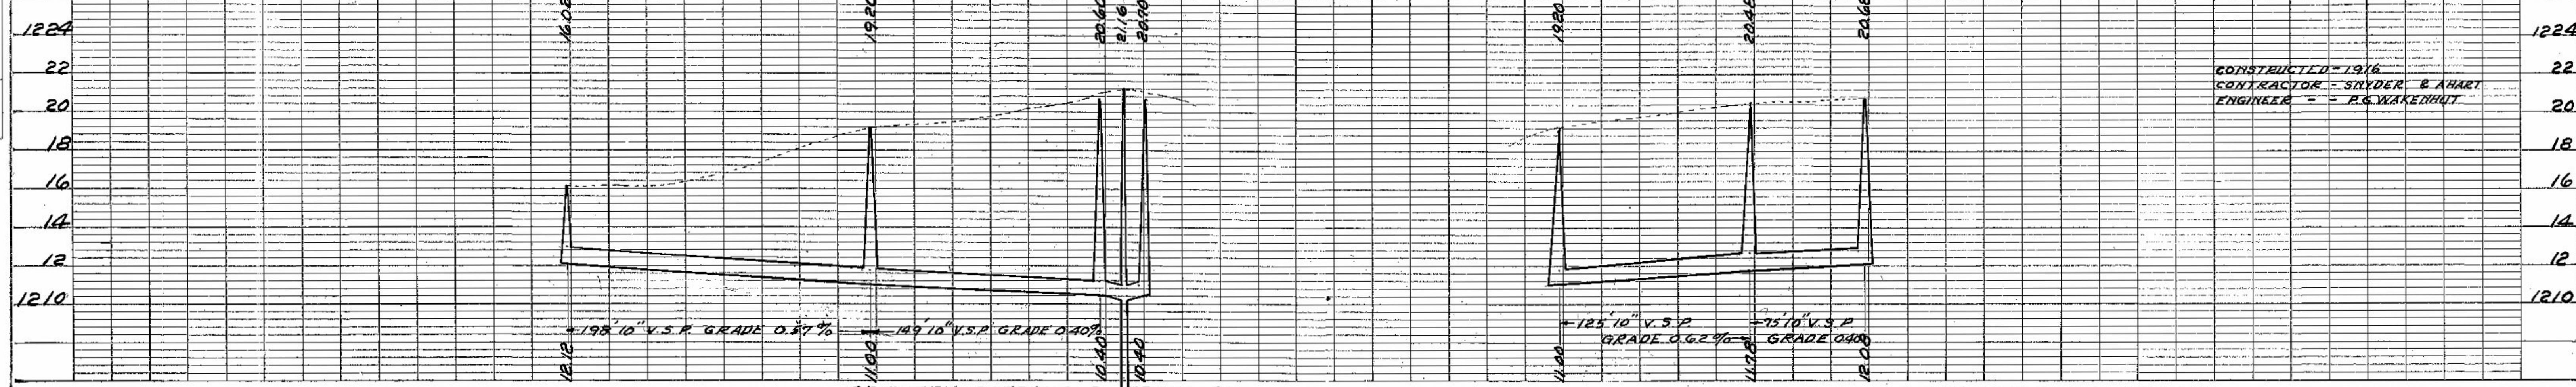

DATE  
BY  
H.E.B.  
S.E.B.  
SURVEYED  
NOTE BOOK  
CONCES. CHECKED  
B.M. NOTED  
STRUCTURE NOTATION CHECKED  
NO.

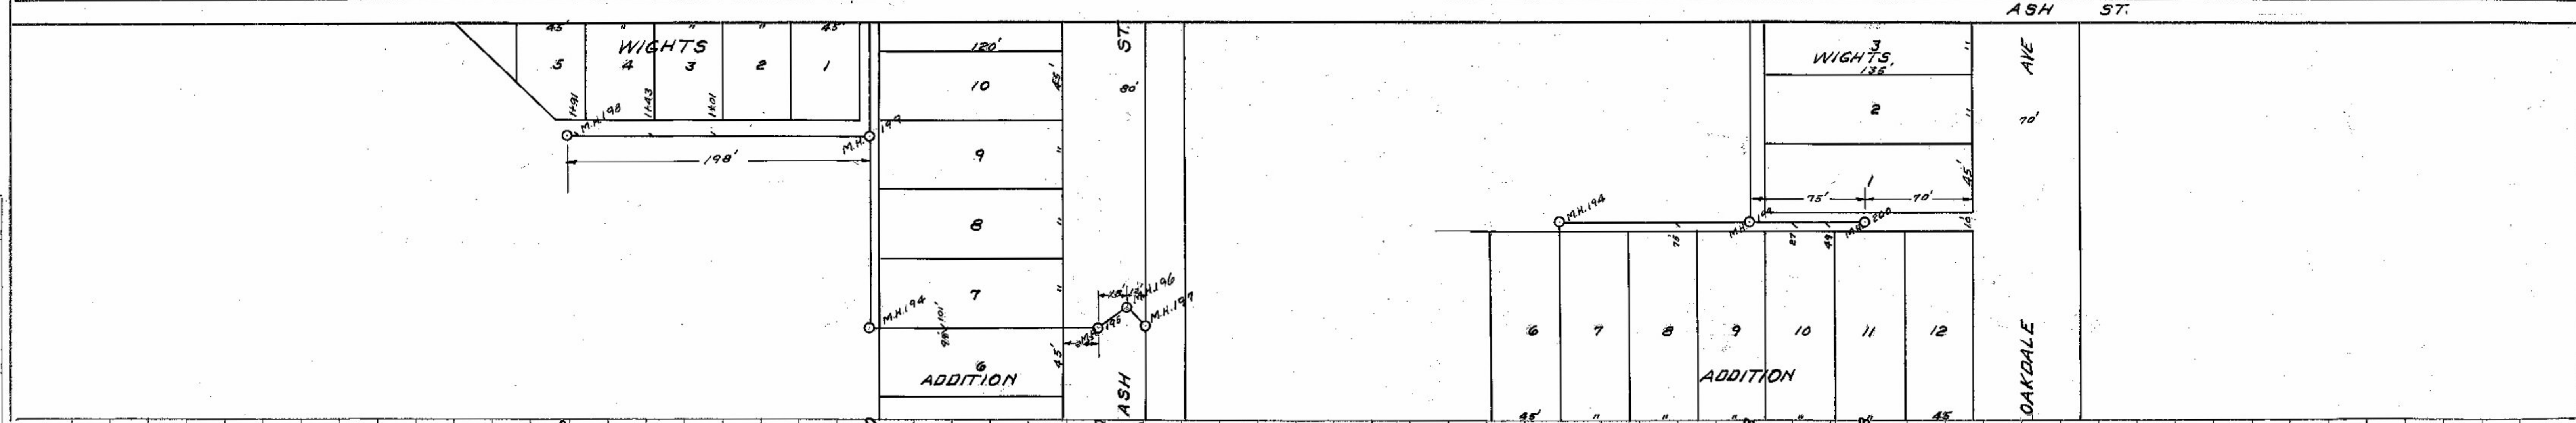

CONSTRUCTED 1916  
CONTRACTOR - SNYDER & HART  
ENGINEER - P.S. WAKELHUT