
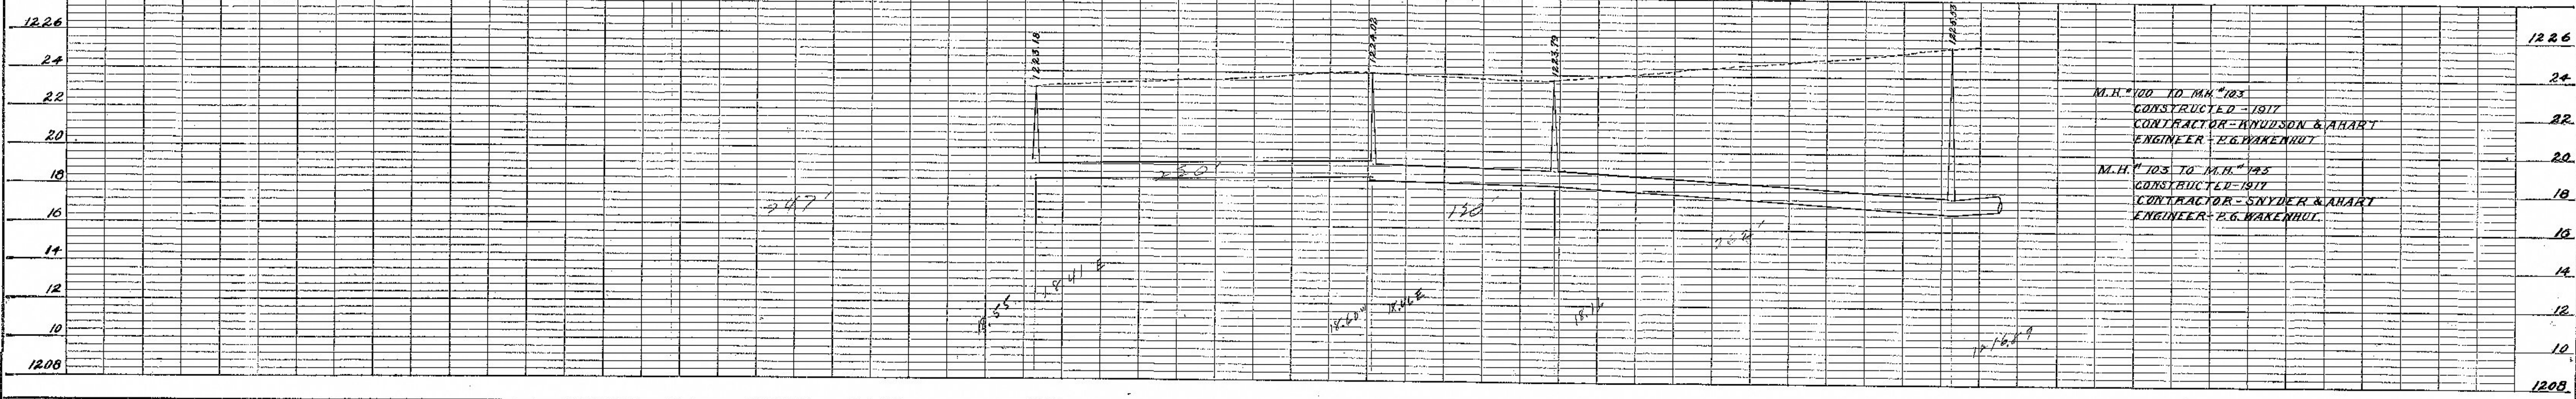




PLAN	SURVEYED	DATE
NOTED	BY	
PLOTTED		
ALIGNED		
CHECKED		
BY		
NO.		

PROFILE	SURVEYED	DATE
NOTED	BY	
PLOTTED		
ALIGNED		
CHECKED		
BY		
NO.		

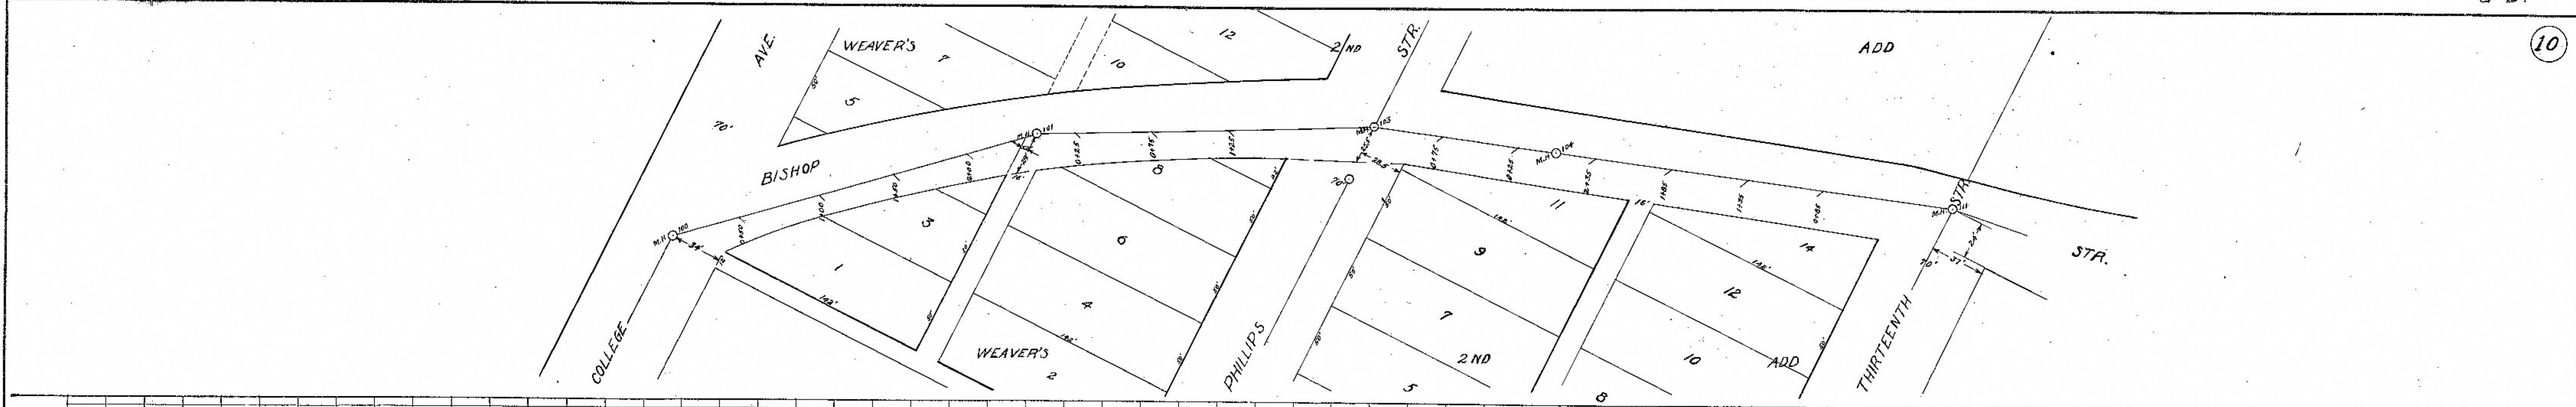

M.H. # 100 TO M.H. # 103  
CONSTRUCTED - 1917  
CONTRACTOR - KNUDSON & AHART  
ENGINEER - E.G. WAKENHUT

M.H. # 103 TO M.H. # 143  
CONSTRUCTED - 1917  
CONTRACTOR - SNYDER & AHART  
ENGINEER - E.G. WAKENHUT

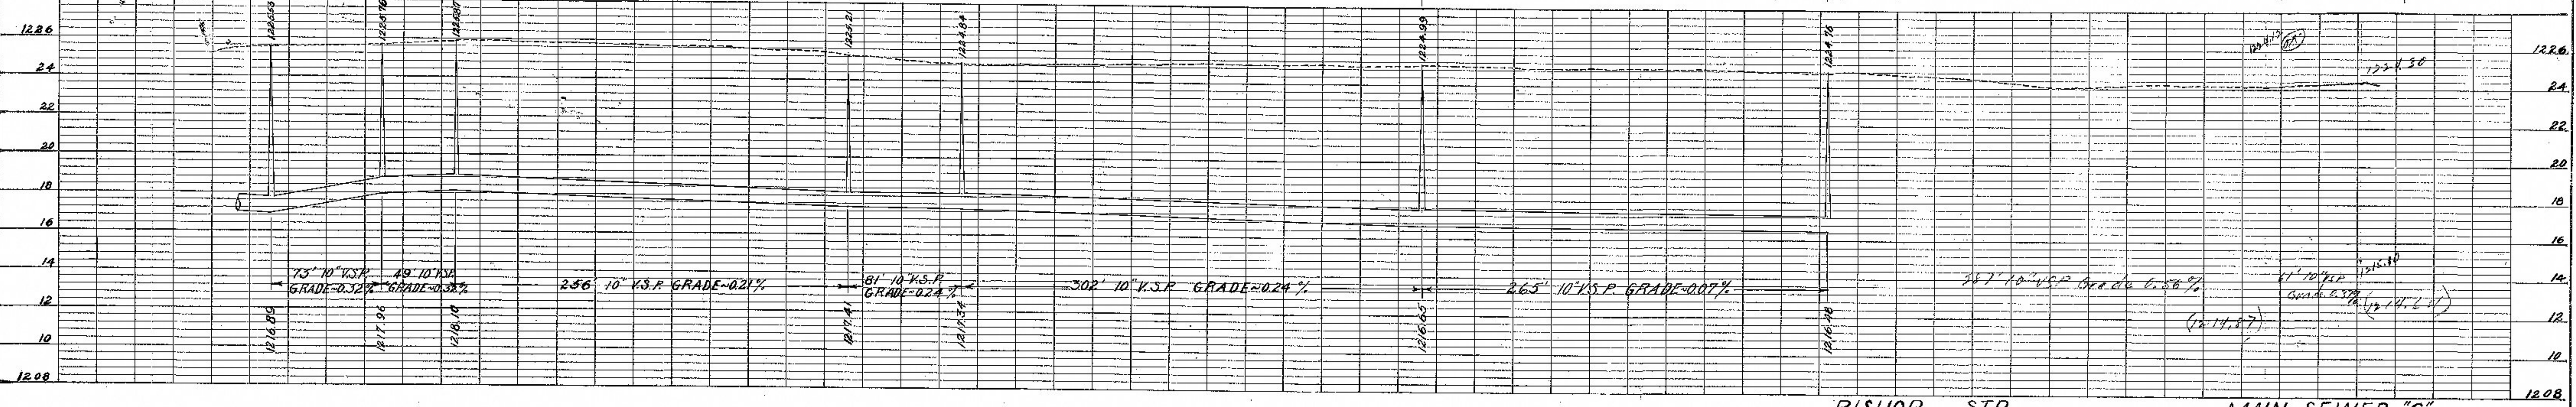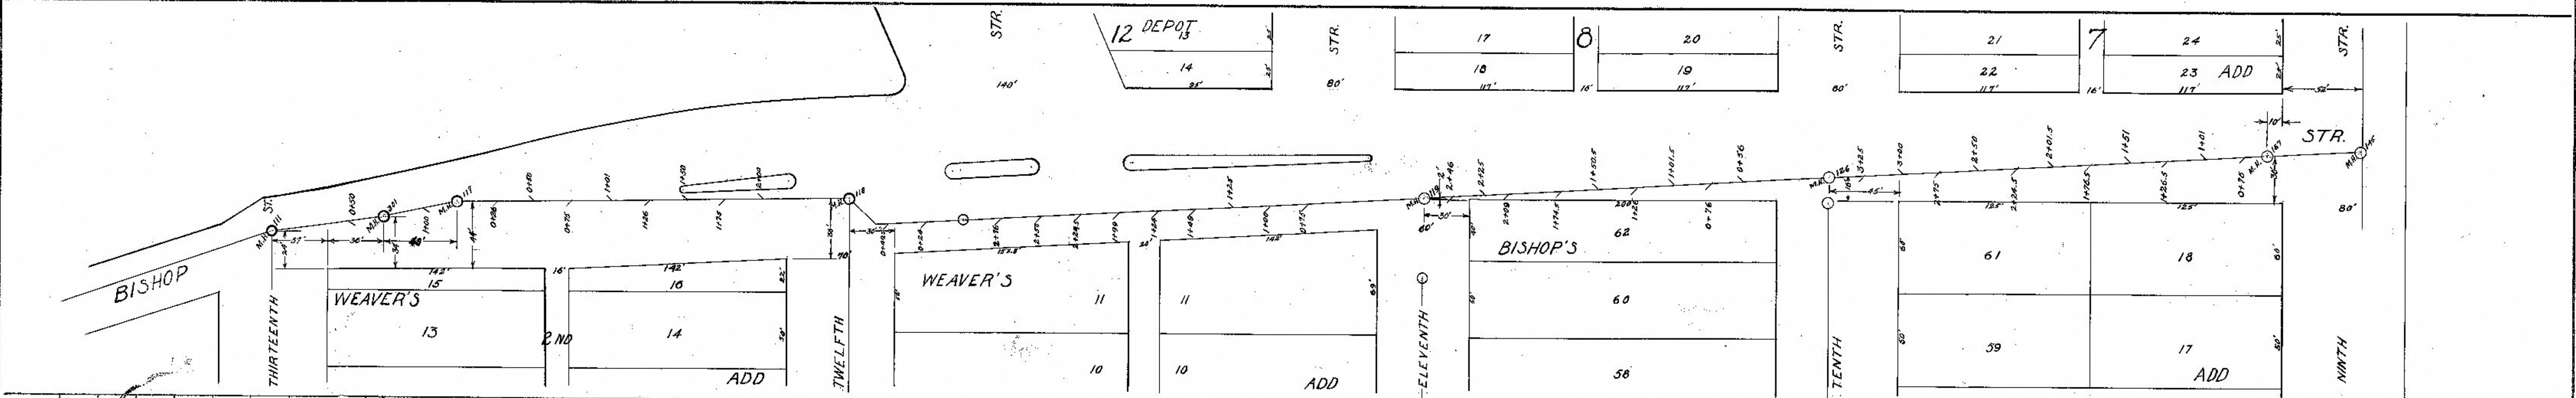

BISHOP STR. MAIN SEWER "C"