

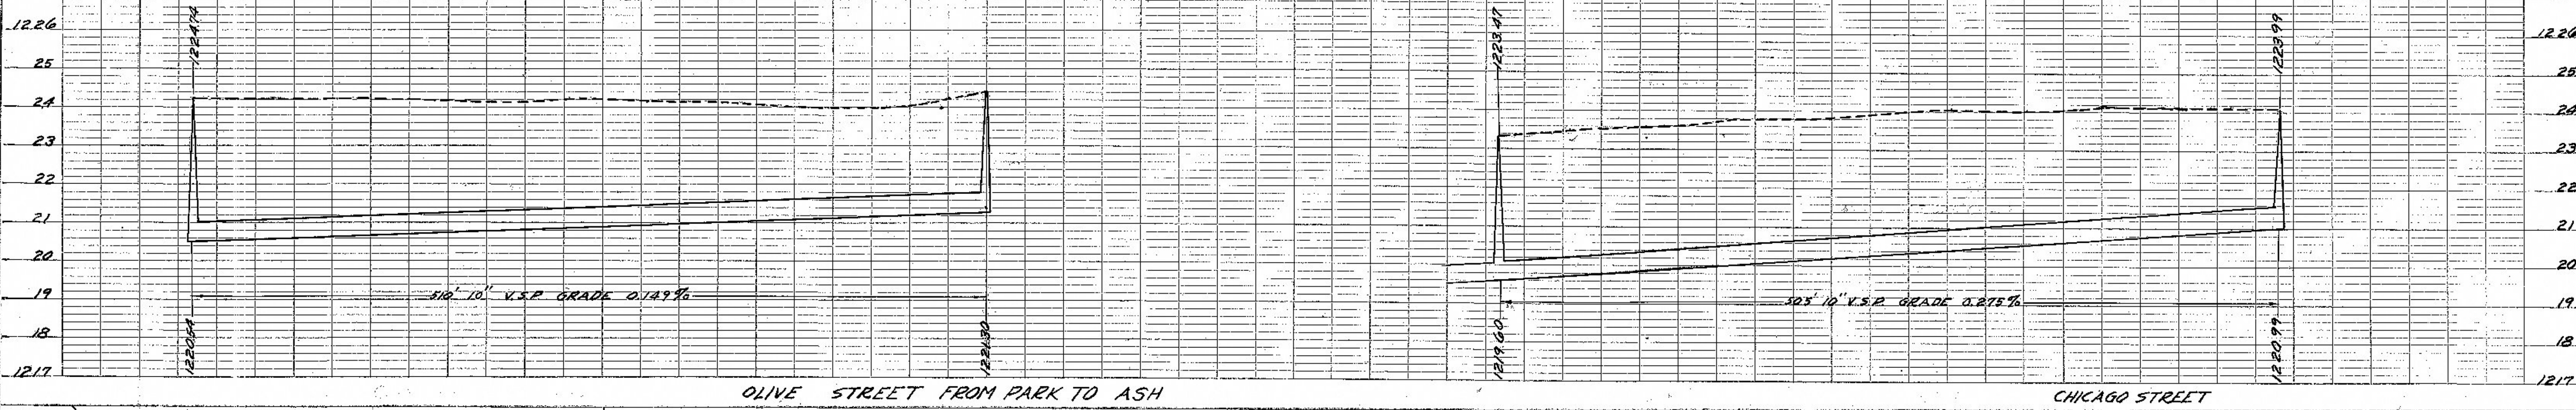
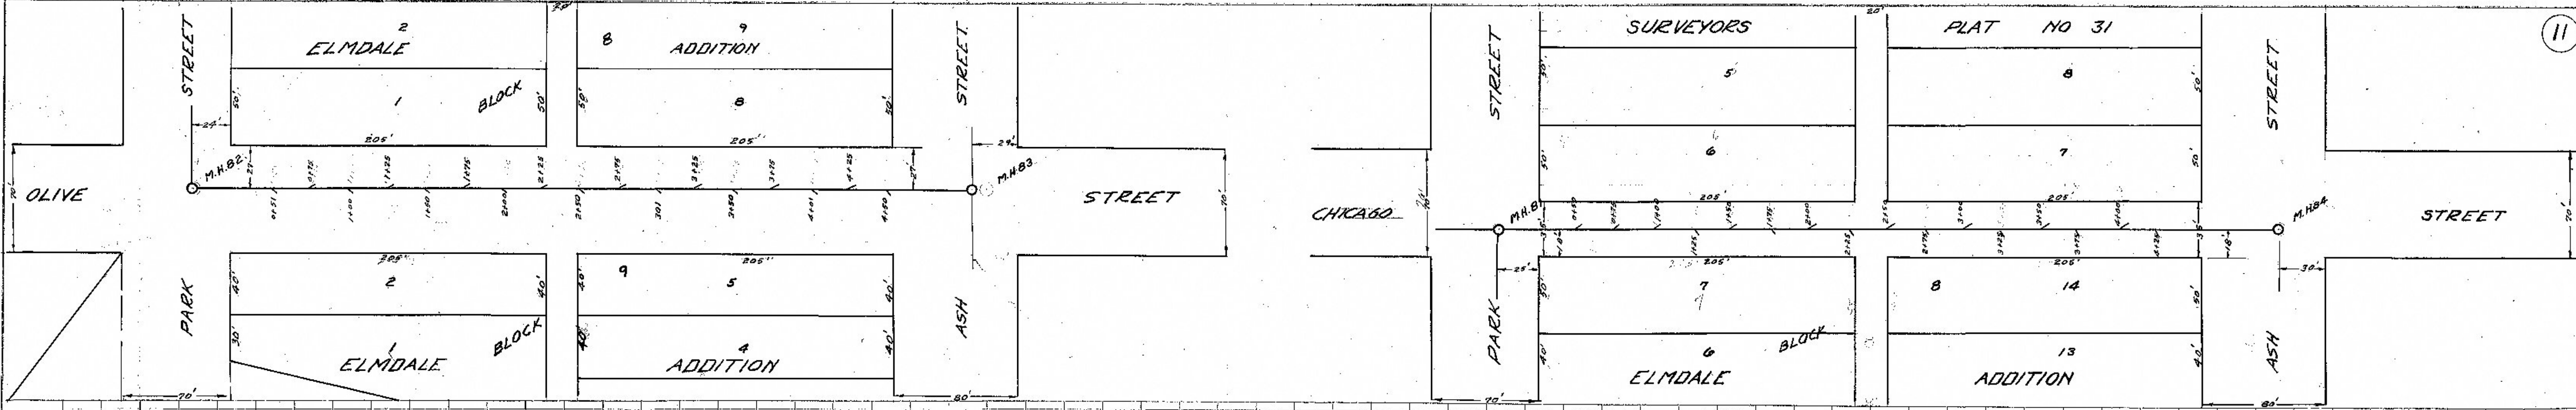


PLAN
 SURVISED
 FLOTTED
 CHECKED
 DATE
 BY
 RLB

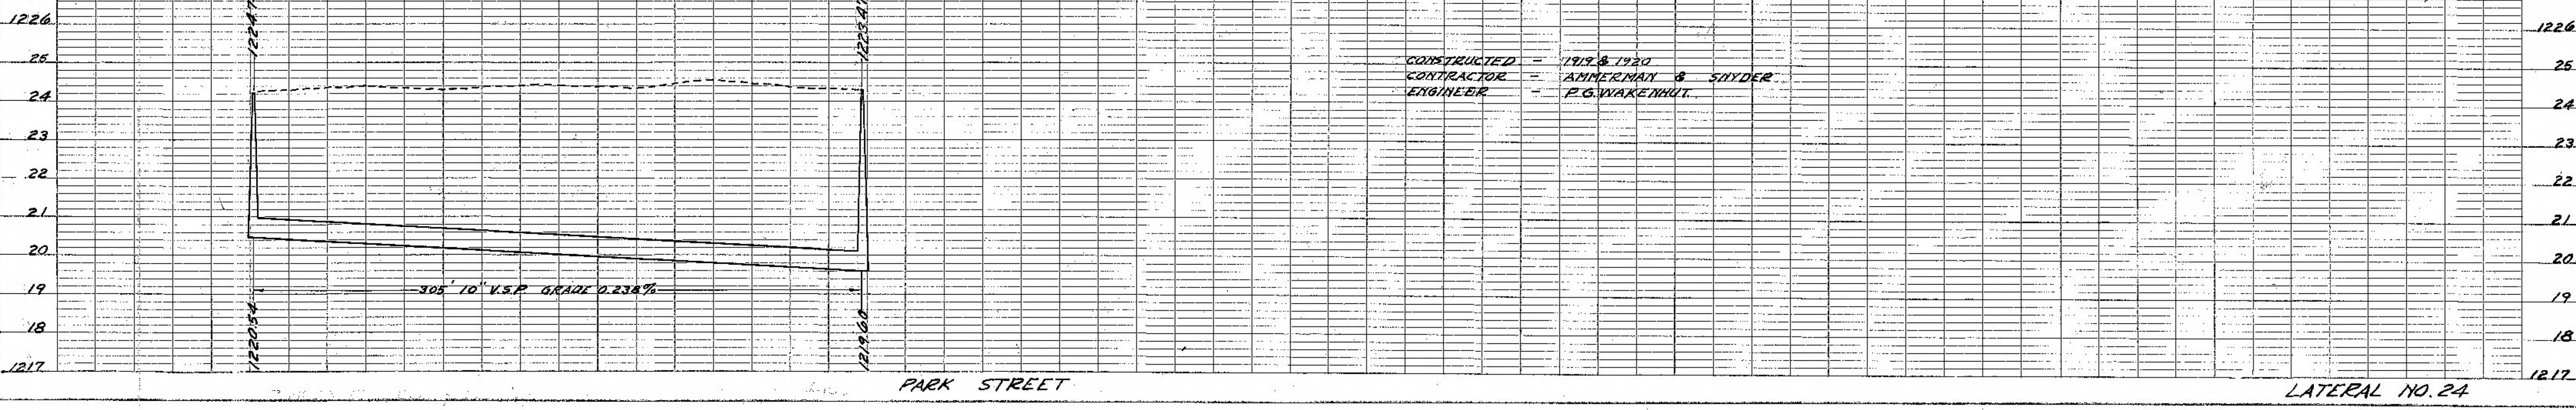

PROFILE
 SURVISED
 GRADES CHECKED
 DATE
 BY
 RLB

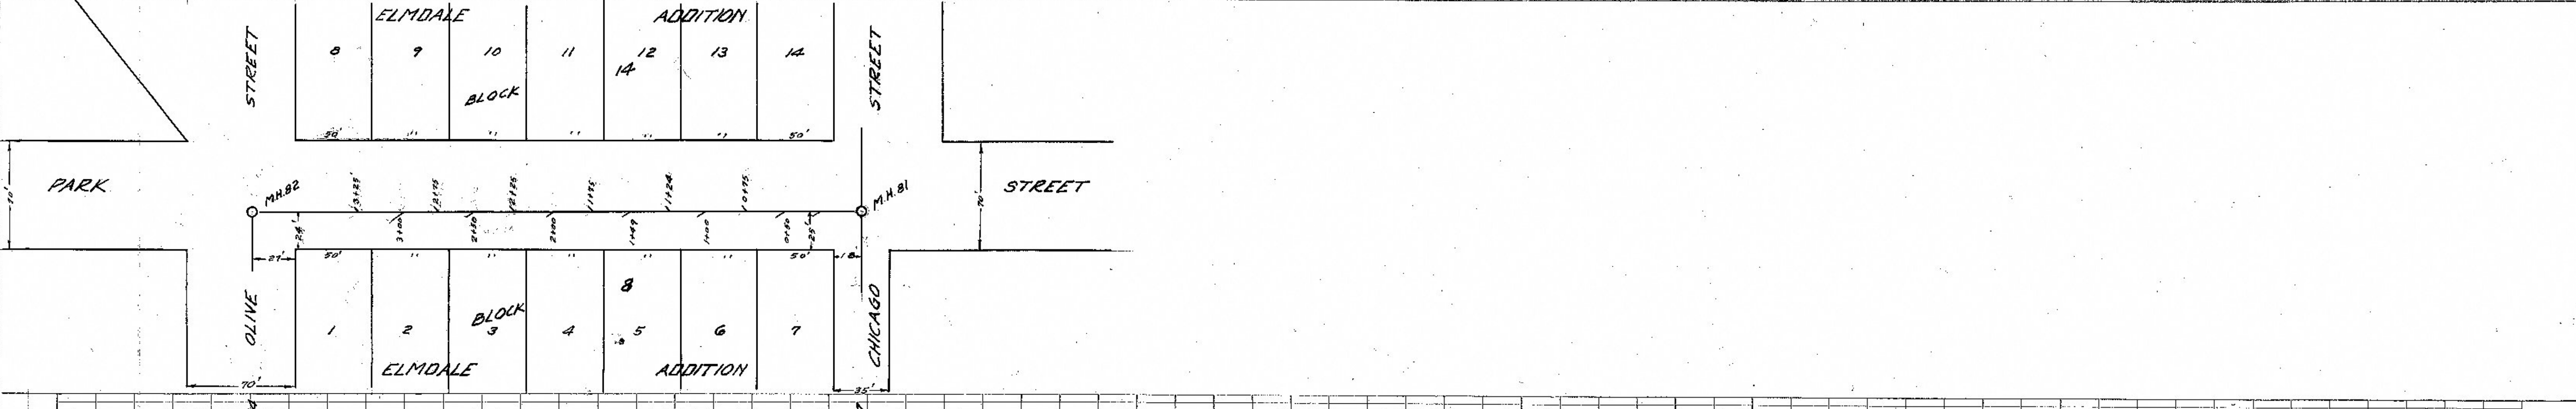

CONSTRUCTED - 1919 & 1920
 CONTRACTOR - AMMERMAN & SNYDER
 ENGINEER - P.G. WAKENHUT.