


(12)

PLAN SURVEYED
 NOTES CHECKED
 DATE
 BY
 HEN
 REB



PROFILE SURVEYED
 NOTES CHECKED
 DATE
 BY
 HEN
 REB

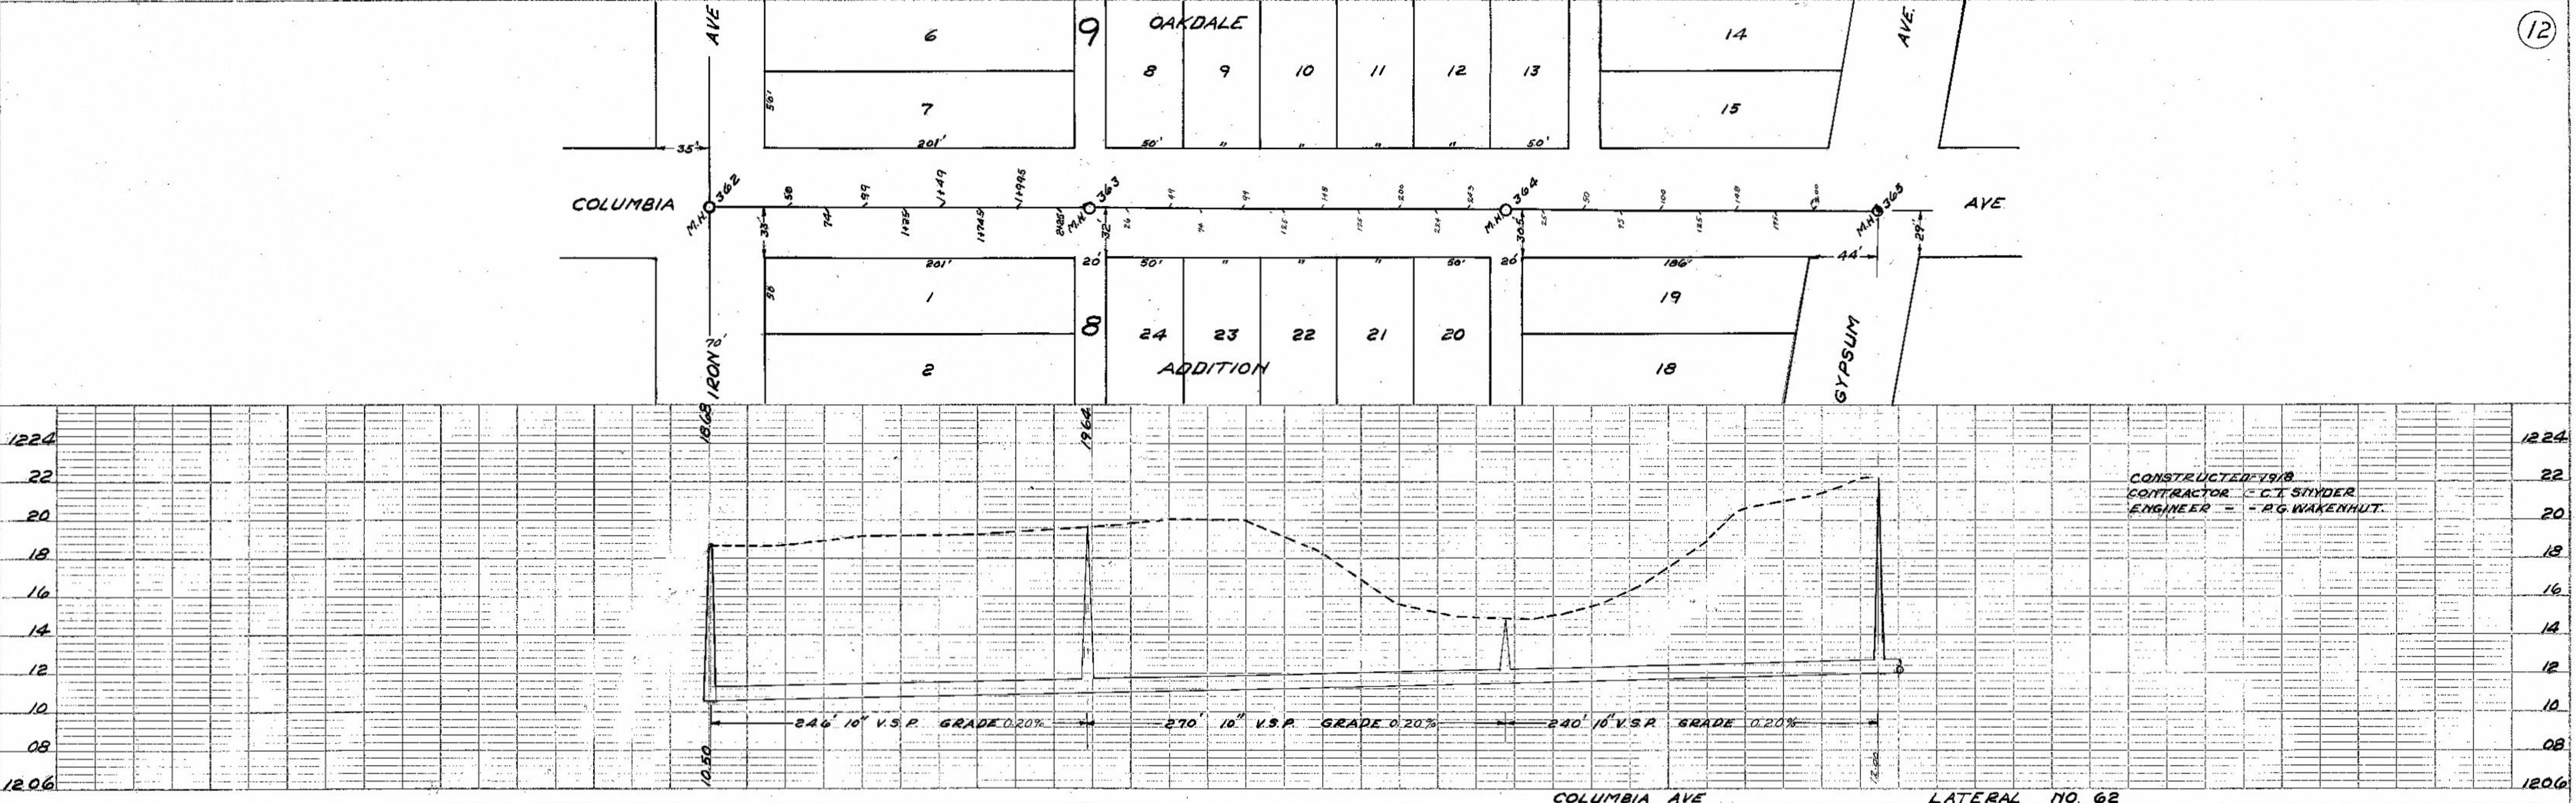