



PLAN
 SURVEYED BY
 H.E.B.
 CHECKED BY
 H.E.B.
 NOTE BOOK ALIGNED CHECKED
 RT. OF DAY CHECKED
 NO.

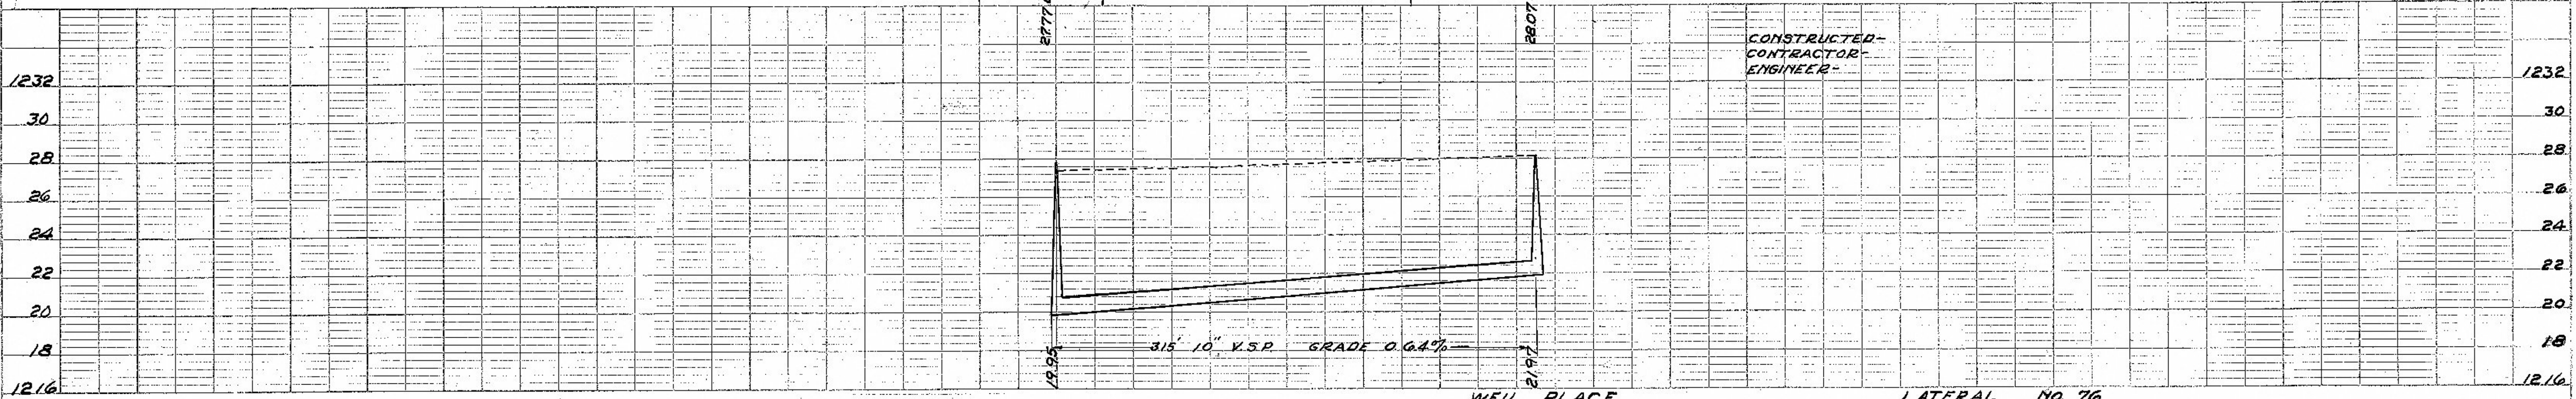

PROFILE
 SURVEYED BY
 H.E.B.
 CHECKED BY
 H.E.B.
 NOTE BOOK ALIGNED CHECKED
 RT. OF DAY CHECKED
 NO.

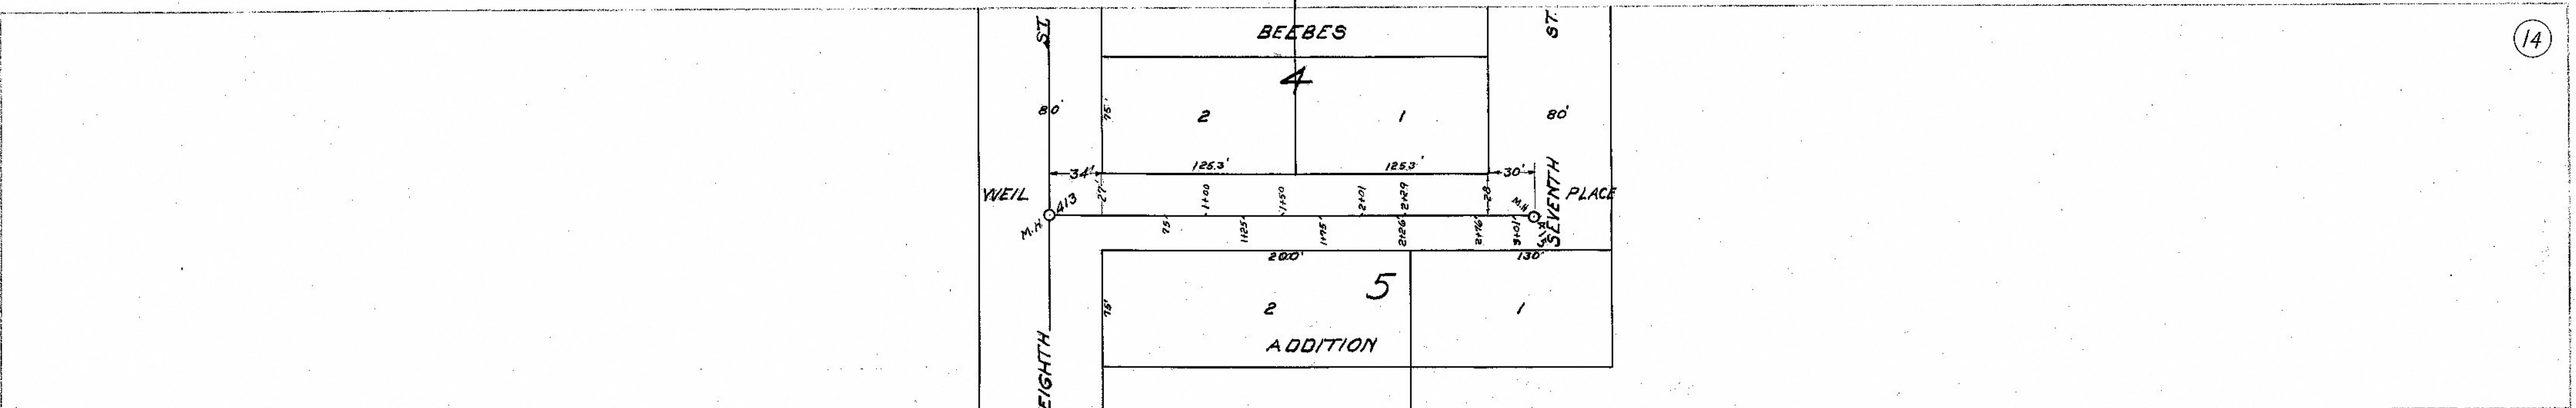