



(15)

PLAN SURVEYED
PROFILING
NOTED AT BOARD CHECKED
BY
DATE
NEW
REB

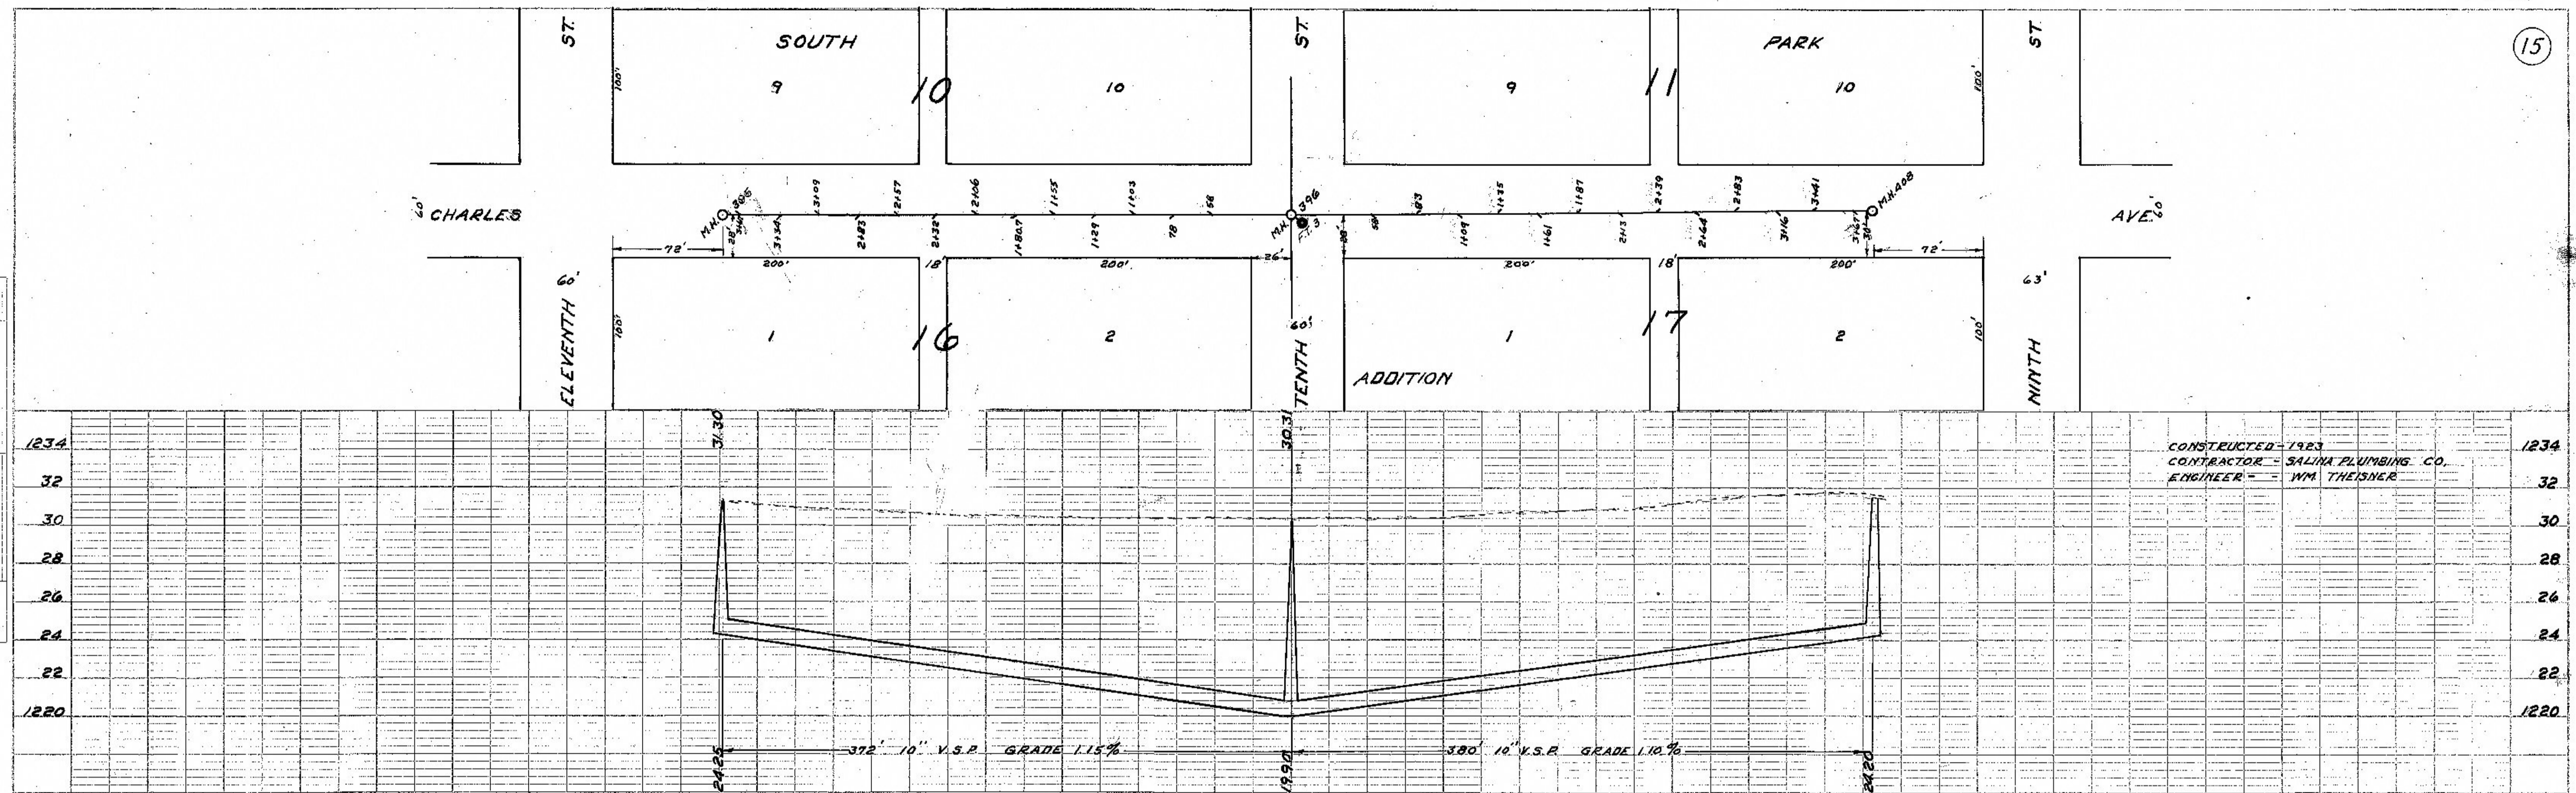

PROFILE SURVEYED
PROFILING
GRADES CHECKED
BY
DATE
NEW
REB

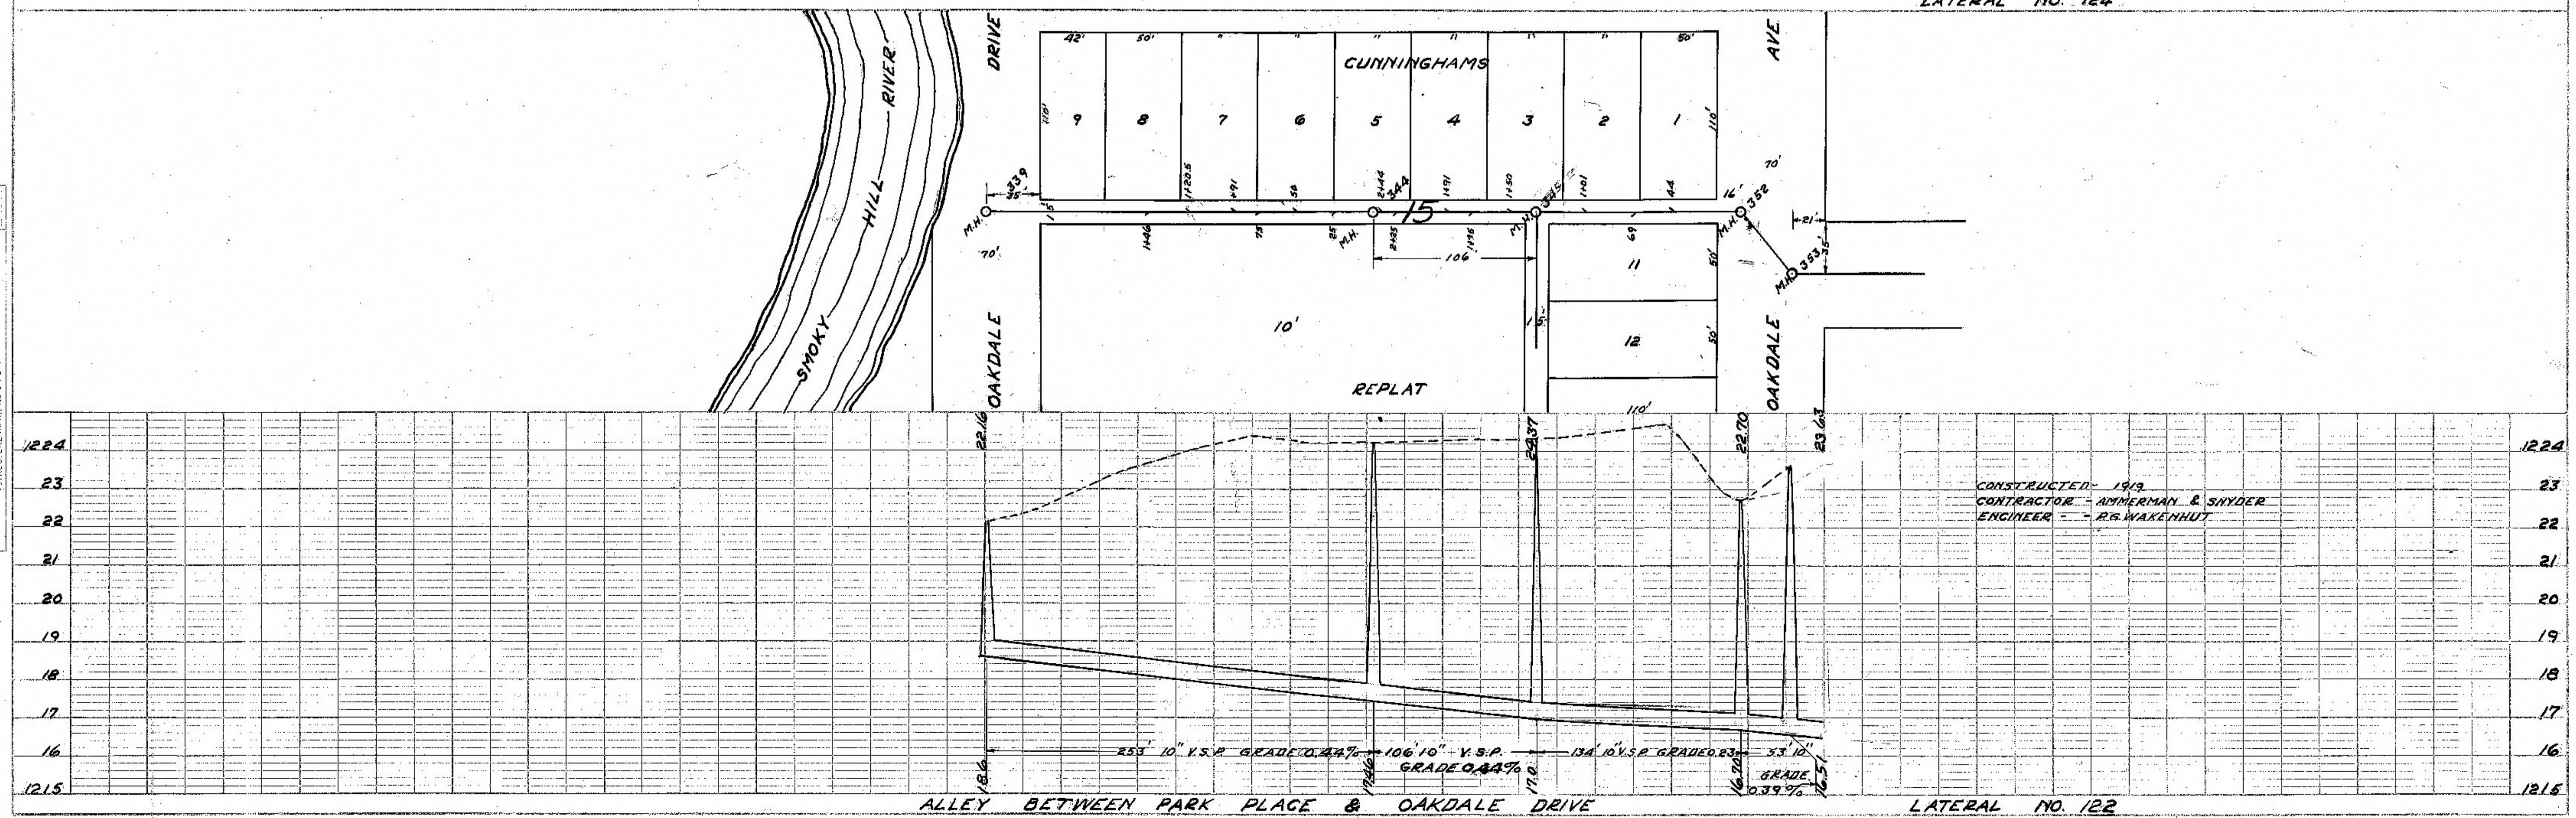

NOTE: - PLAN PROFILE TO P.P.S. & STANDARD
ELEVATION - 85.5 FT. M.S.L. NEW YORK