



PLAN	SURVEYED	DATE
NOTE BOOK	PLOTTED	BY
NO.	GRADE CHECKED	
	BY OF W.A. CHECKED	

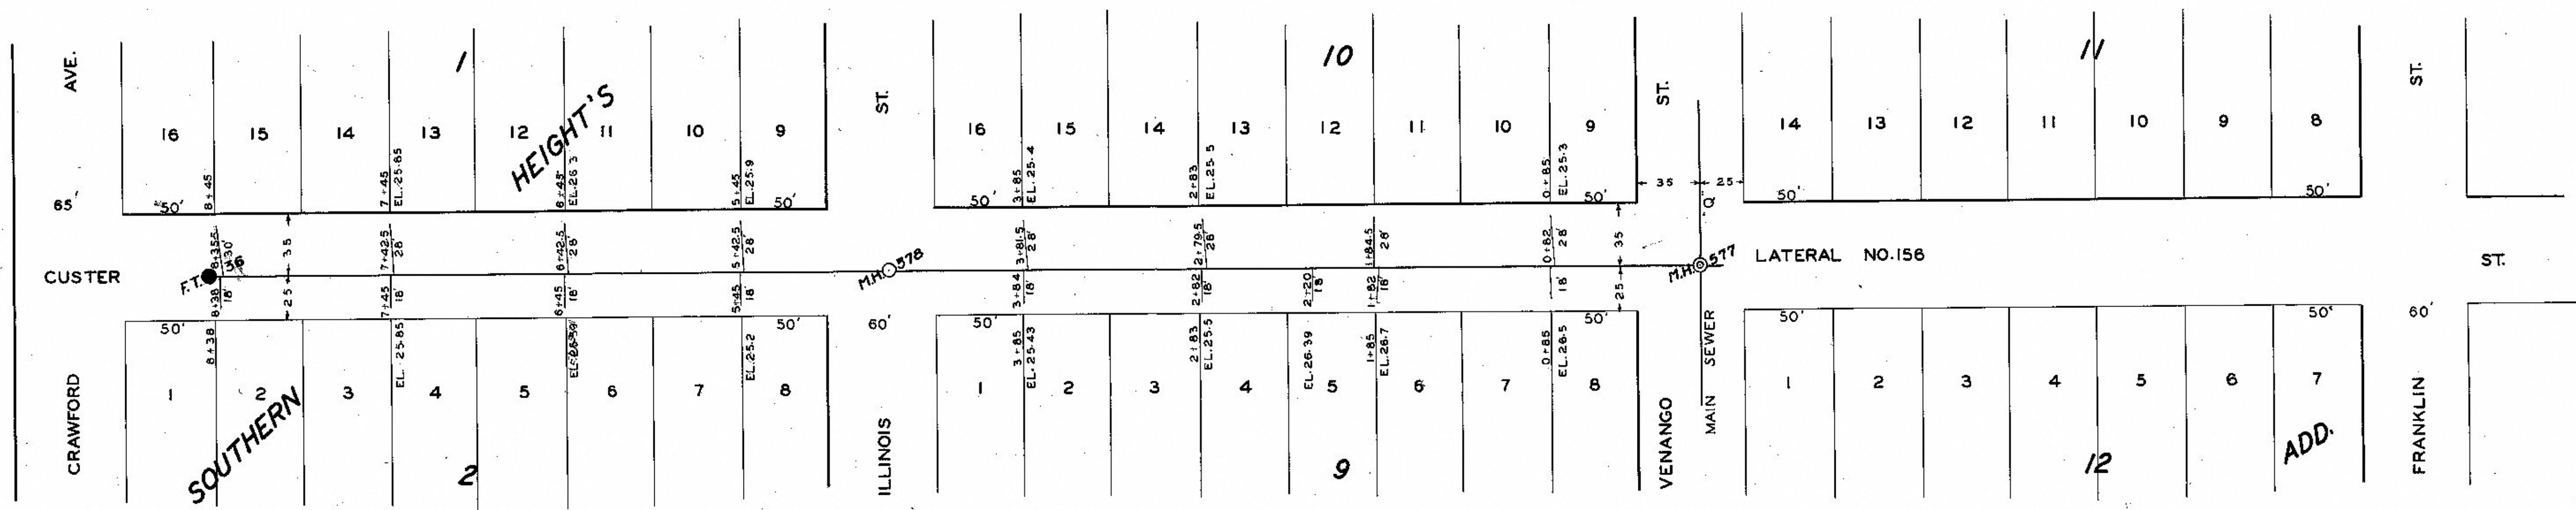

PROFILE	SURVEYED	DATE
NOTE BOOK	PLOTTED	BY
NO.	GRADE CHECKED	
	STRUCTURE NOT IN CHECK	

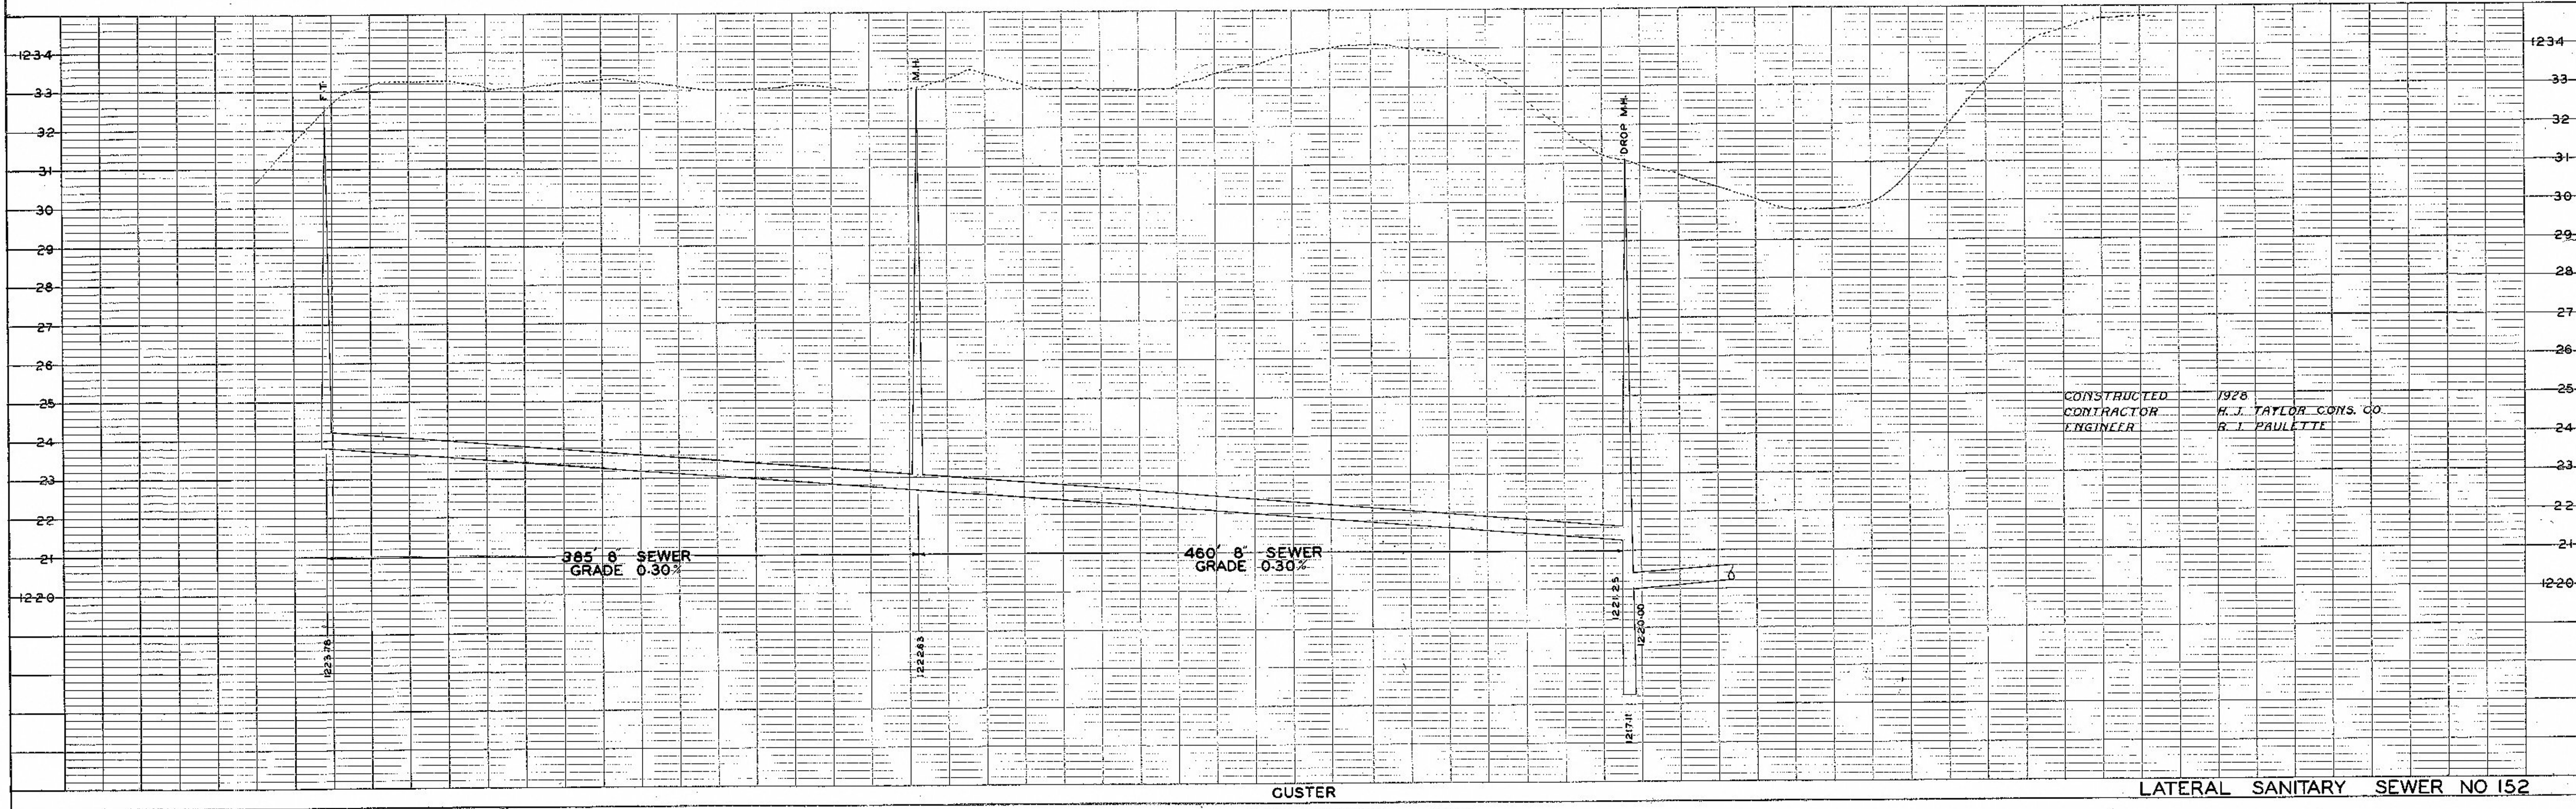

CONSTRUCTED 1928  
 CONTRACTOR H. J. TAYLOR CONS. CO.  
 ENGINEER R. J. PAULLETTE