



PLAN
SURVEYED
NOTE BOOK
NO. _____
PLOTTED
NOTE BOOK
NO. _____
CHECKED
BY _____
DATE _____

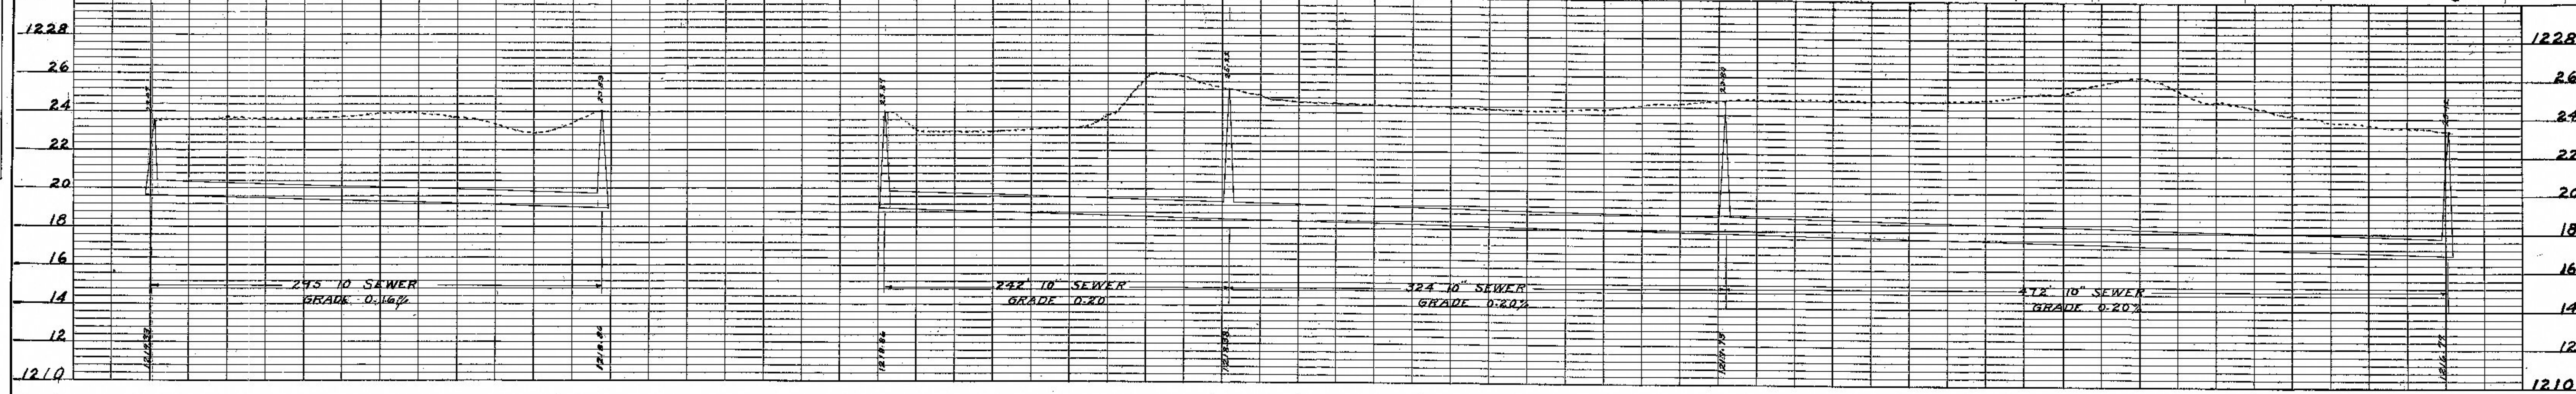

PROFILE
SURVEYED
NOTE BOOK
NO. _____
PLOTTED
NOTE BOOK
NO. _____
CHECKED
BY _____
DATE _____

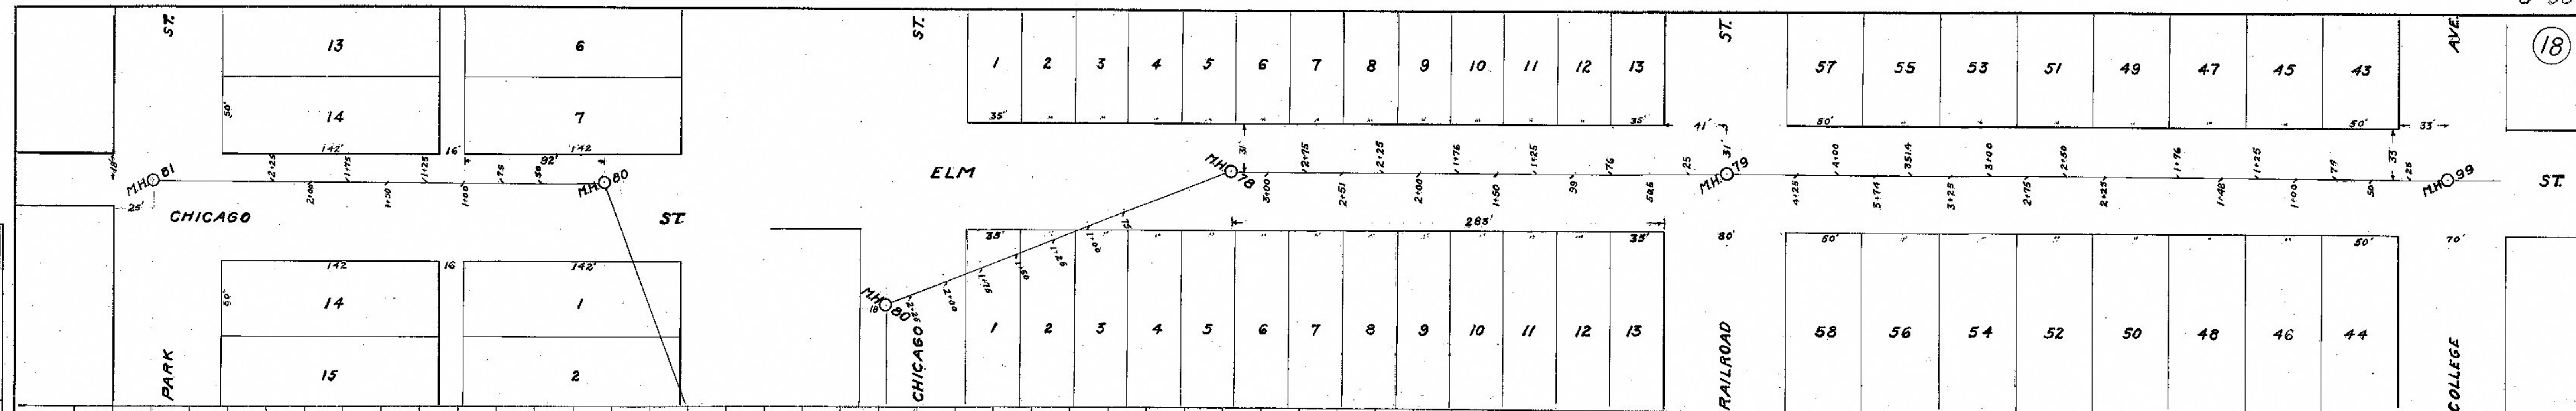