
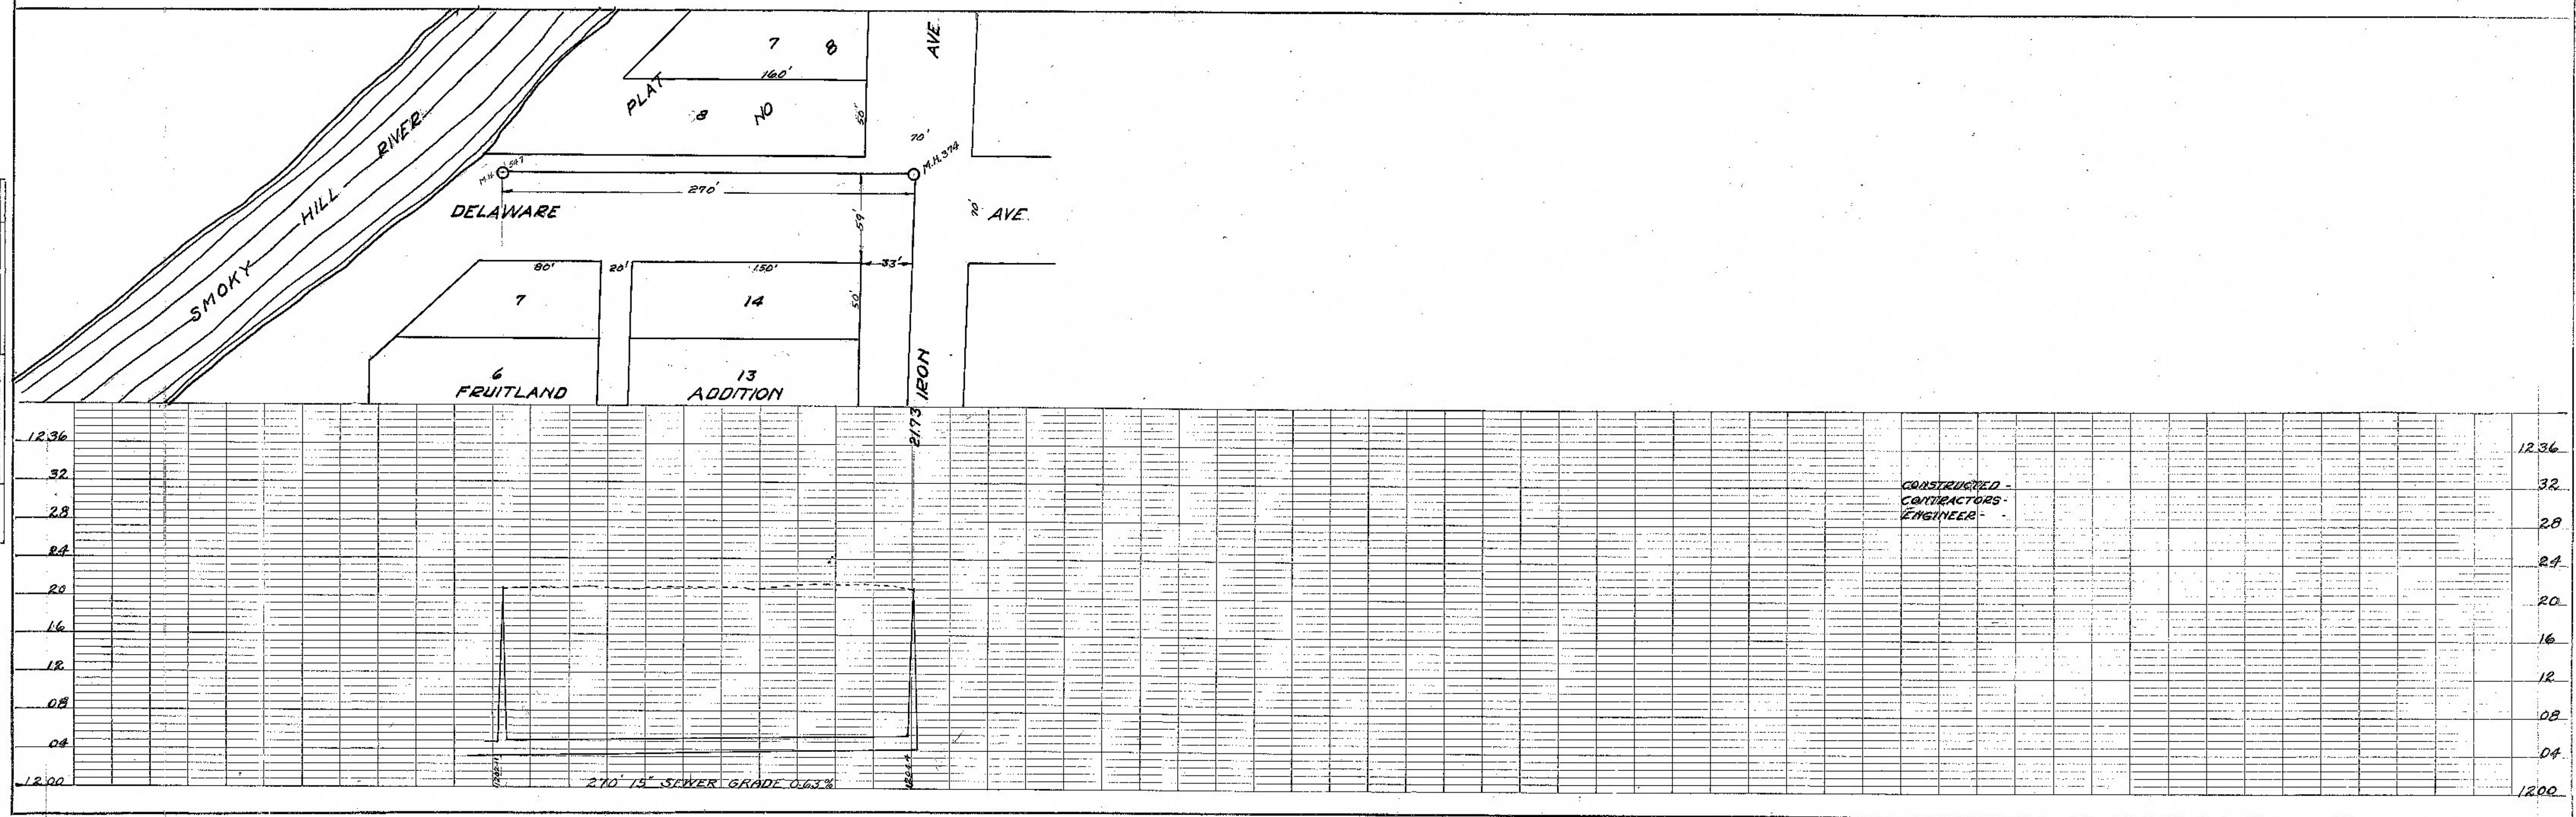


DATE: _____ BY: **HEW**
 PLAN SURVEYED _____ PLOTTED _____
 NOTE BOOK _____ CHECKED _____
 NO. _____

DATE: _____ BY: **HEW**
 PROFILE SURVEYED _____ PLOTTED _____
 NOTE BOOK _____ CHECKED _____
 NO. _____

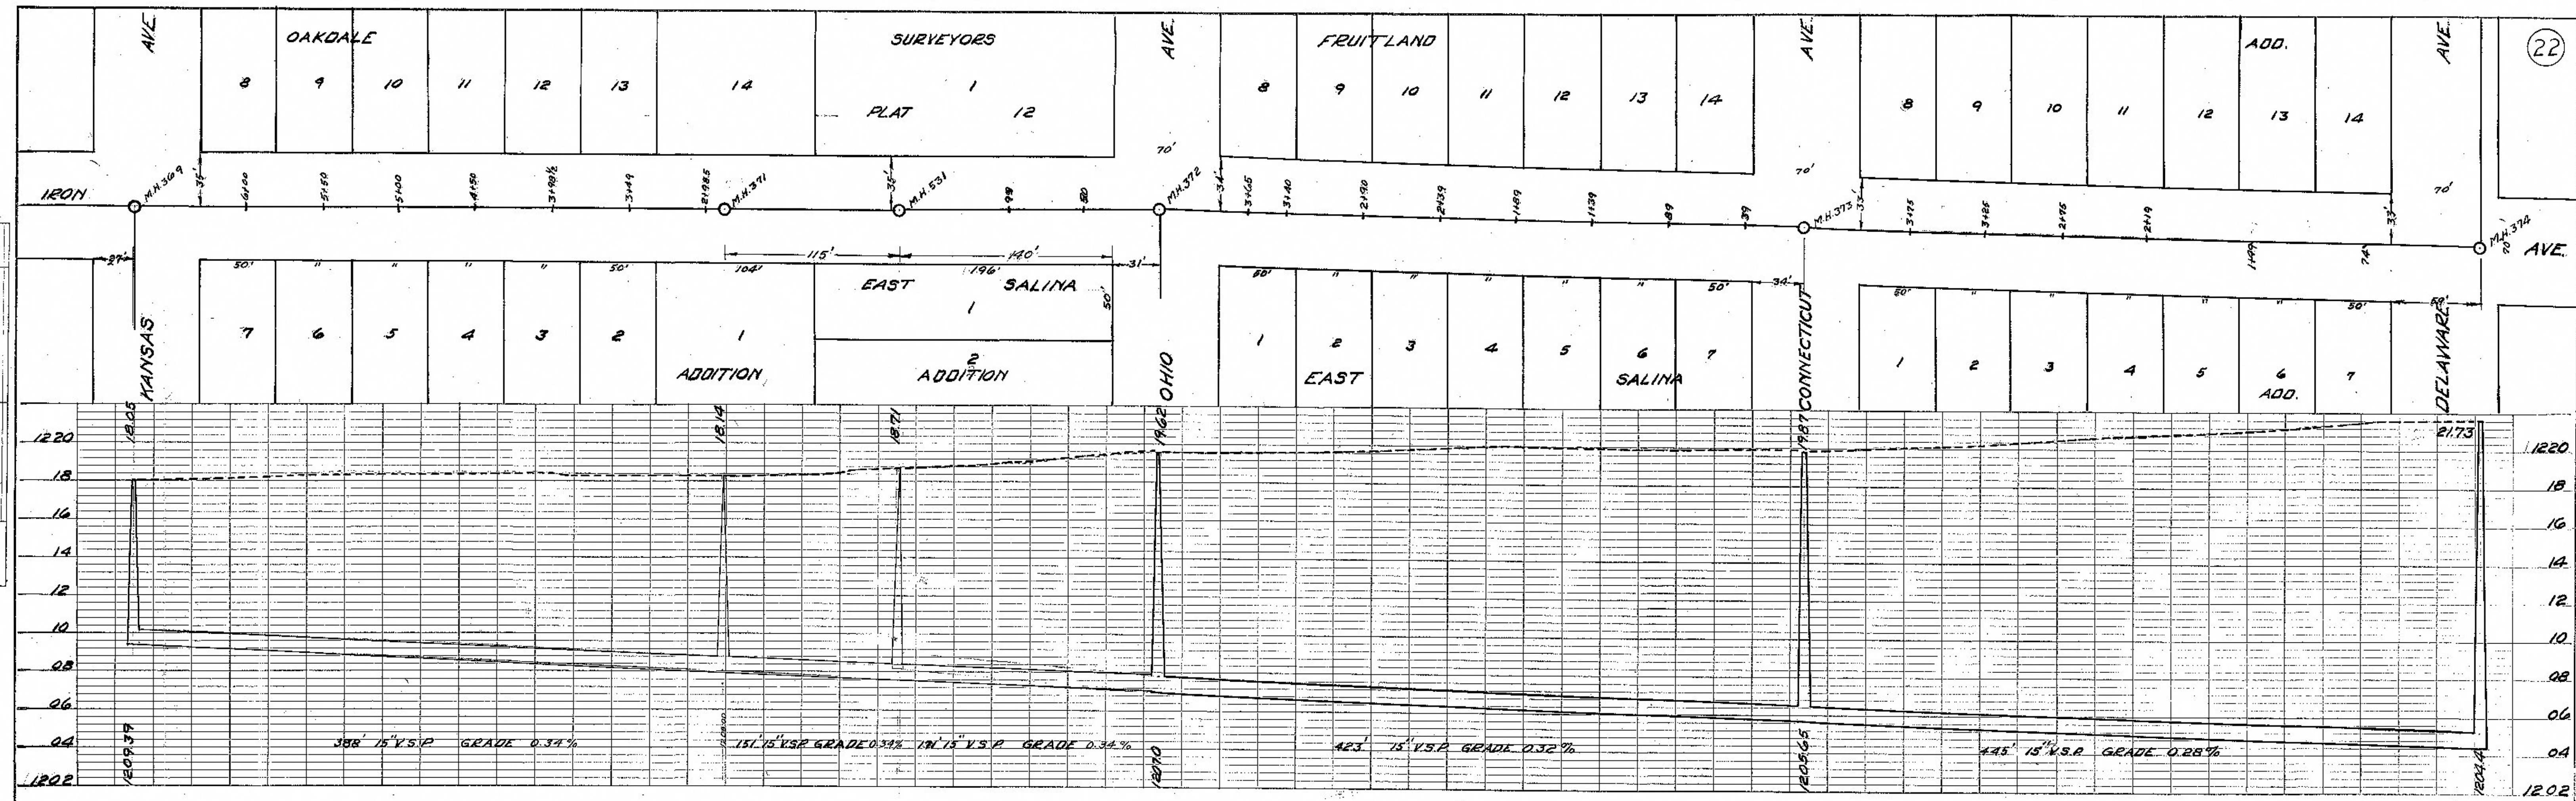

CONSTRUCTED - CONTRACTORS - ENGINEER