
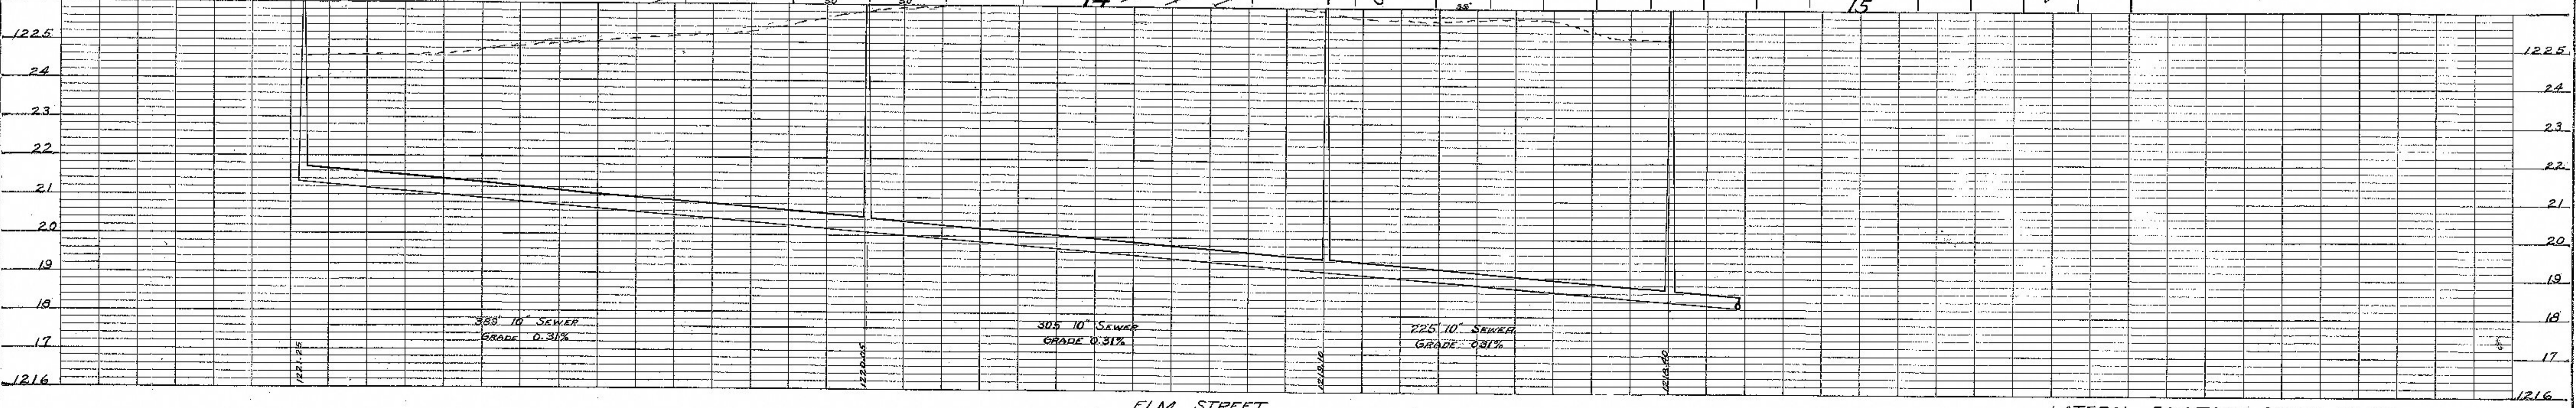
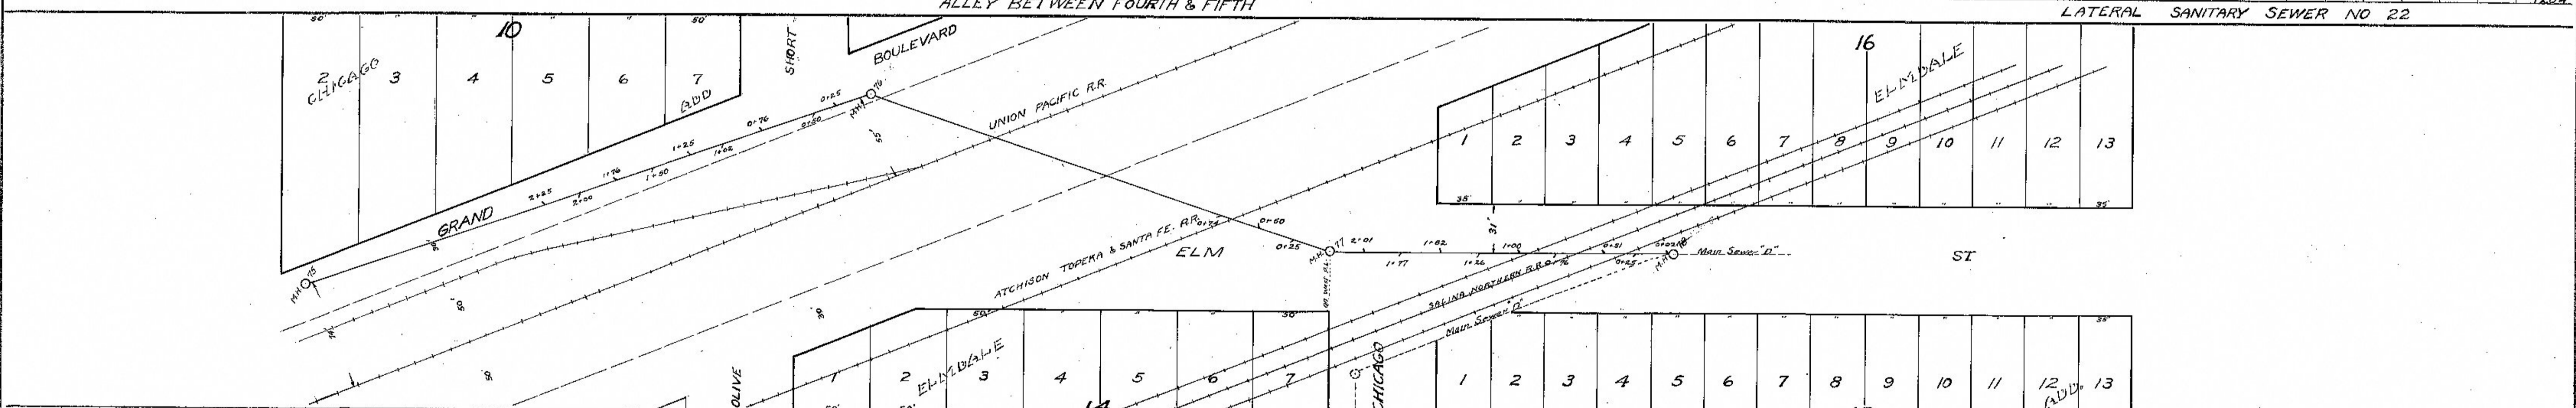
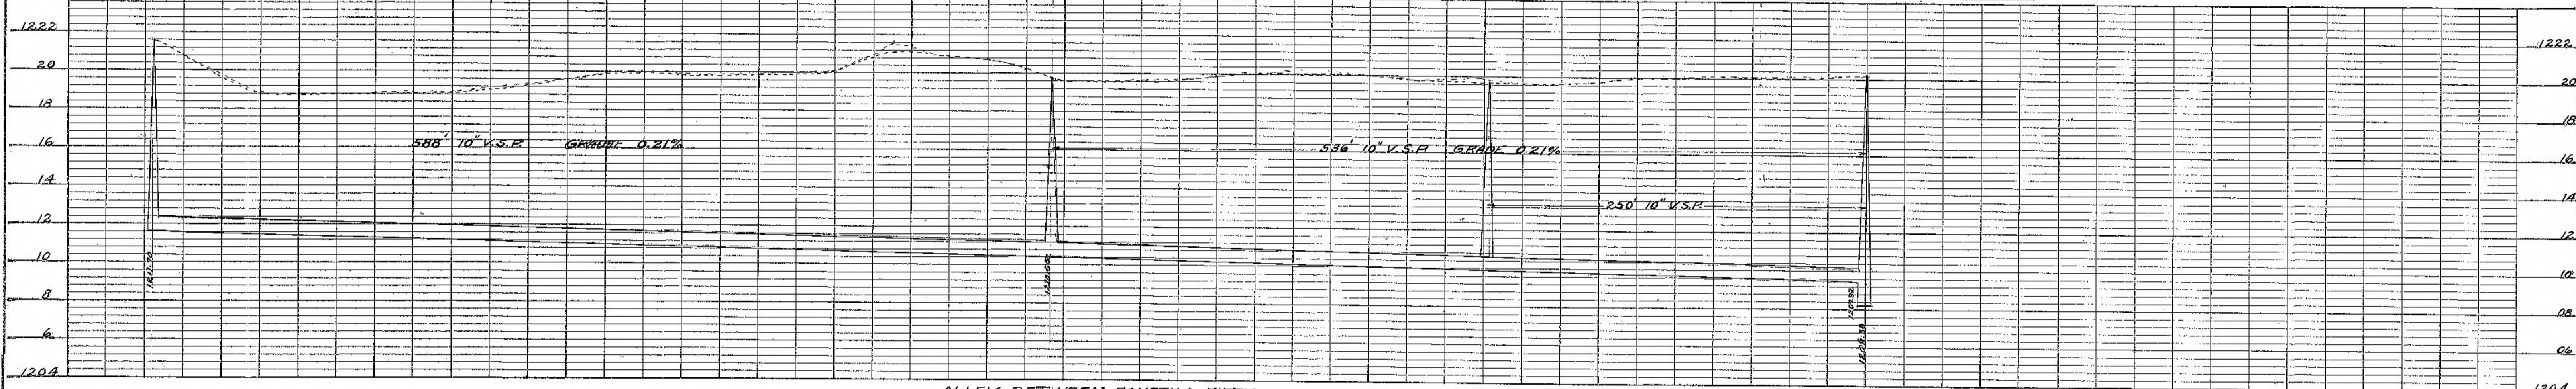


PLAN SURVEYED BY DATE
 PLOTTED BY
 NOTE BOOK NO. L.A.C.
 ALIGNMENT CHECKED BY
 RT. OF WAY CHECKED BY

PROFILE SURVEYED BY DATE
 PLOTTED BY
 NOTE BOOK NO. L.A.C.
 STRUCTURE NOTED BY
 STRUCTURE NOTED BY

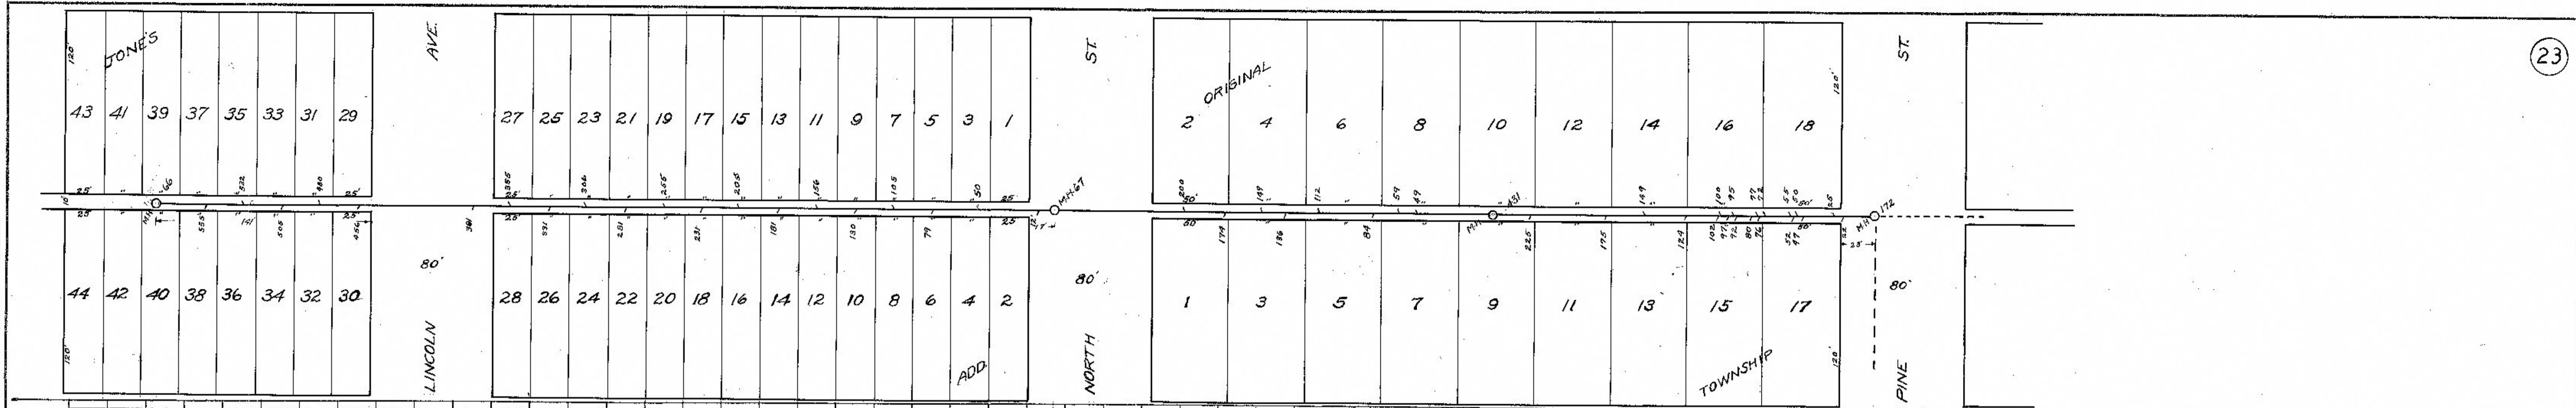

ELM STREET

LATERAL SANITARY SEWER NO 23

PLATE 2-PLAN-PROFILE S. P. R. STANDARD