


(27)

DATE: _____
 PLAN SURVEYED BY: HEM
 NOTE: SEE SHEET FOR ADJUSTMENTS
 NO. _____



DATE: _____
 PROFILE SURVEYED BY: HEM
 NOTE: SEE SHEET FOR ADJUSTMENTS
 NO. _____

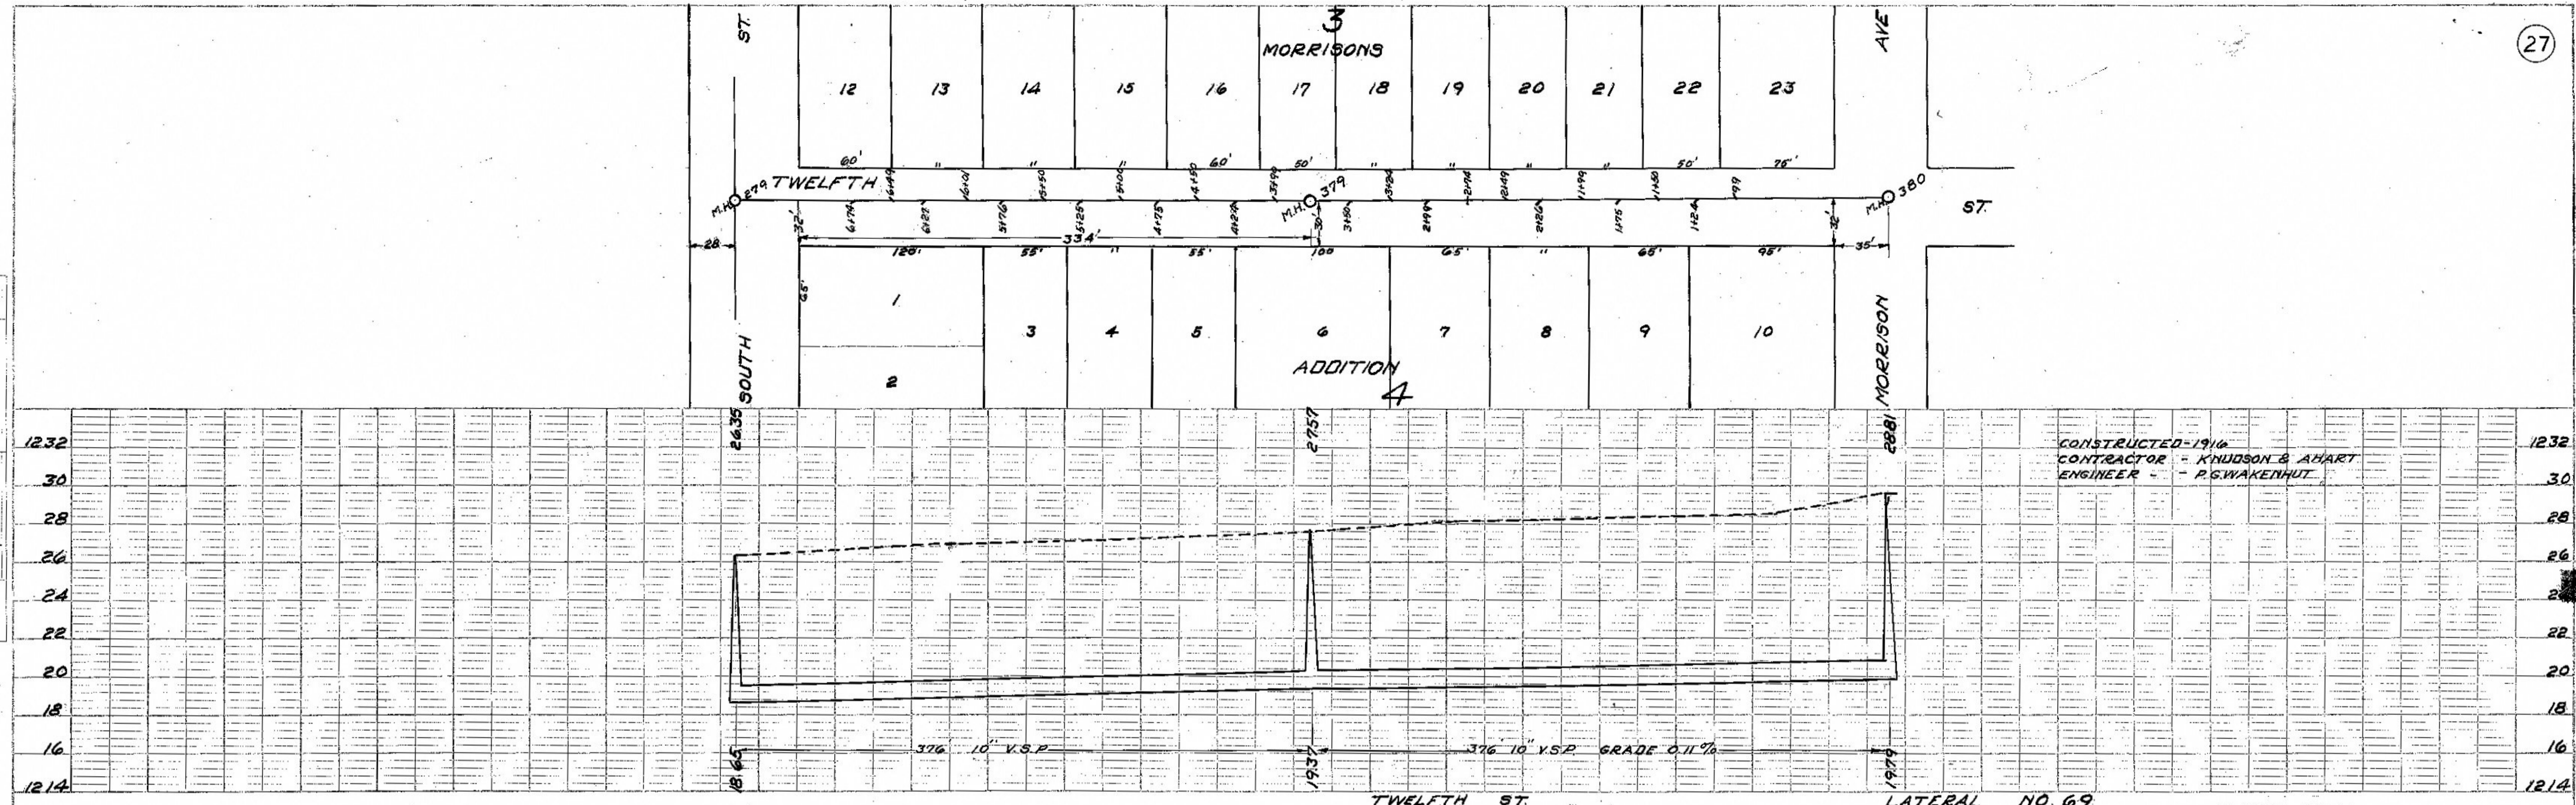