


PLAN  
 SURVEYED  
 NOTE BOOK  
 NO. 1230



PROFILE  
 SURVEYED  
 NOTE BOOK  
 NO. 1232

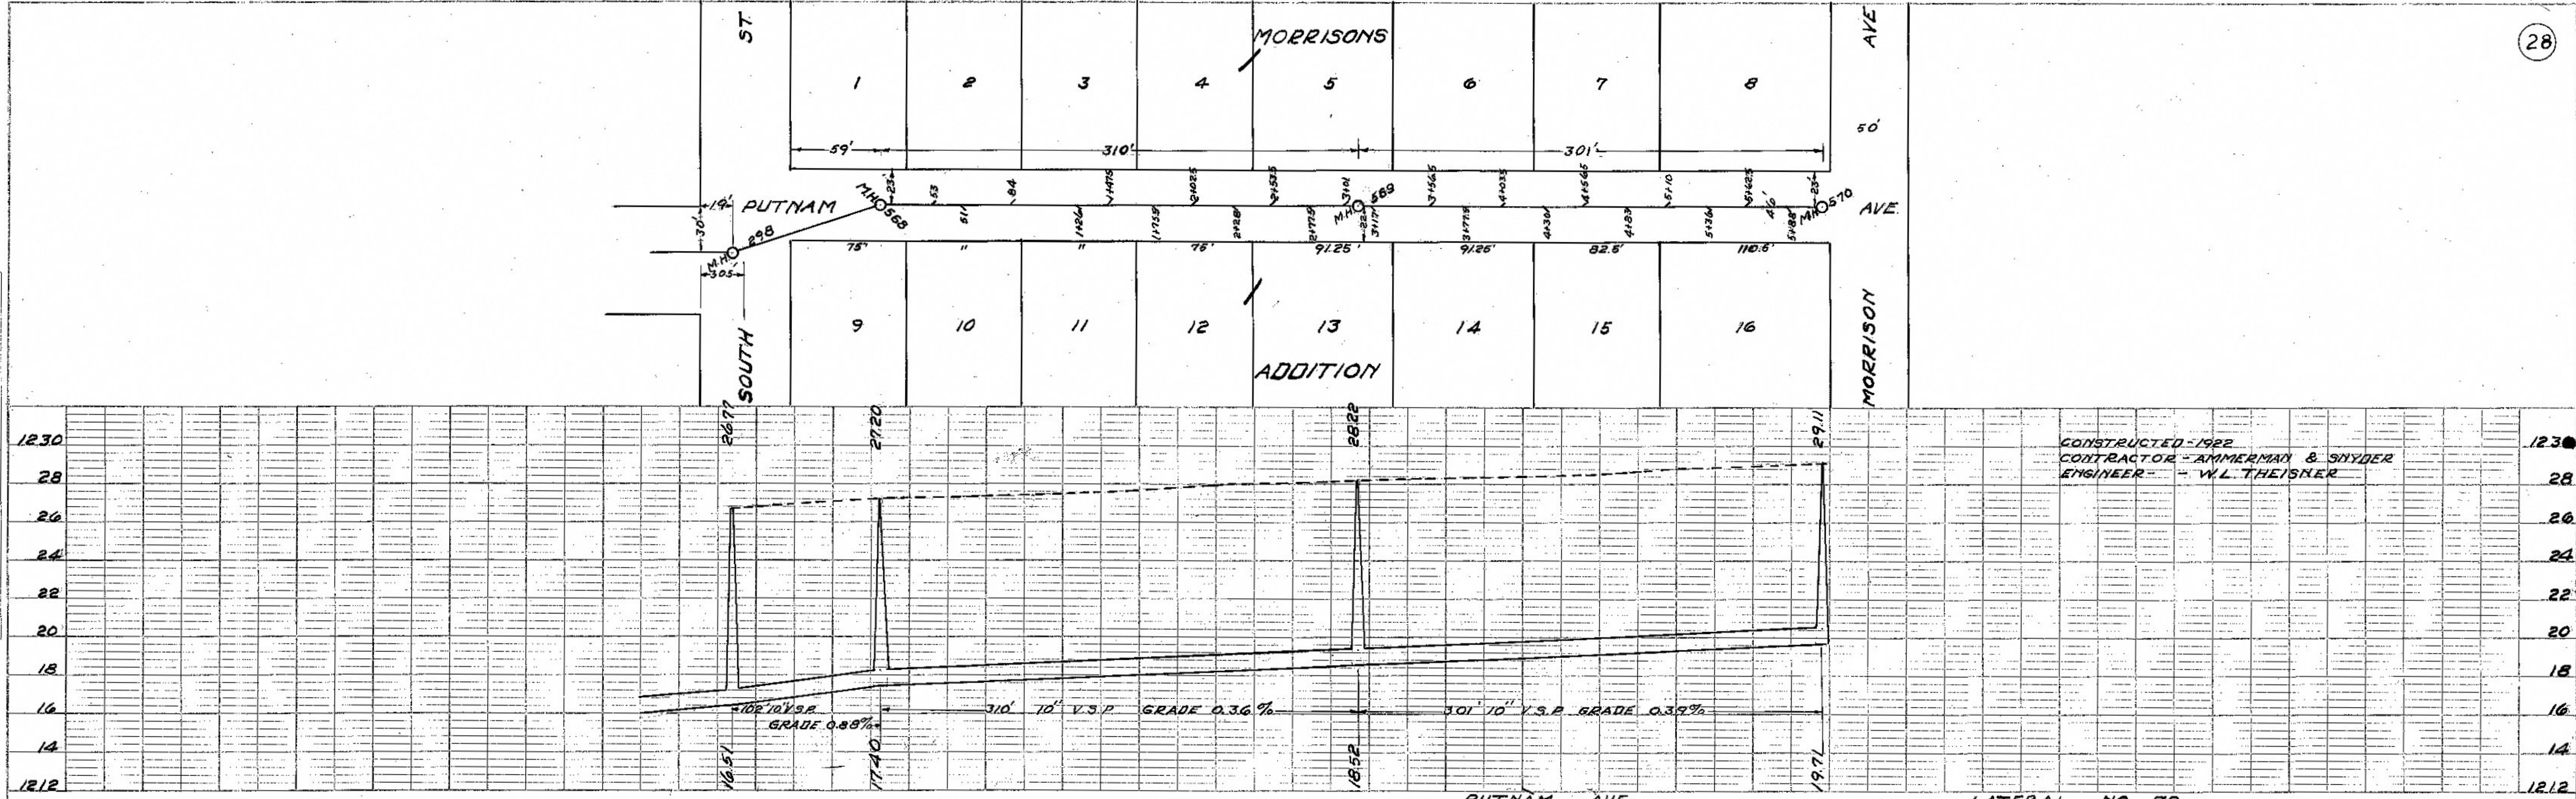