


PLAN SURVEYED BY DATE
 PLOTTED BY
 NOTE BOOK NO. CHECKED BY
 SET OF WAY CHECKED BY

PROFILES SURVEYED BY DATE
 PLOTTED BY
 NOTE BOOK NO. CHECKED BY
 STRUCTURE NOTATION CH'KO

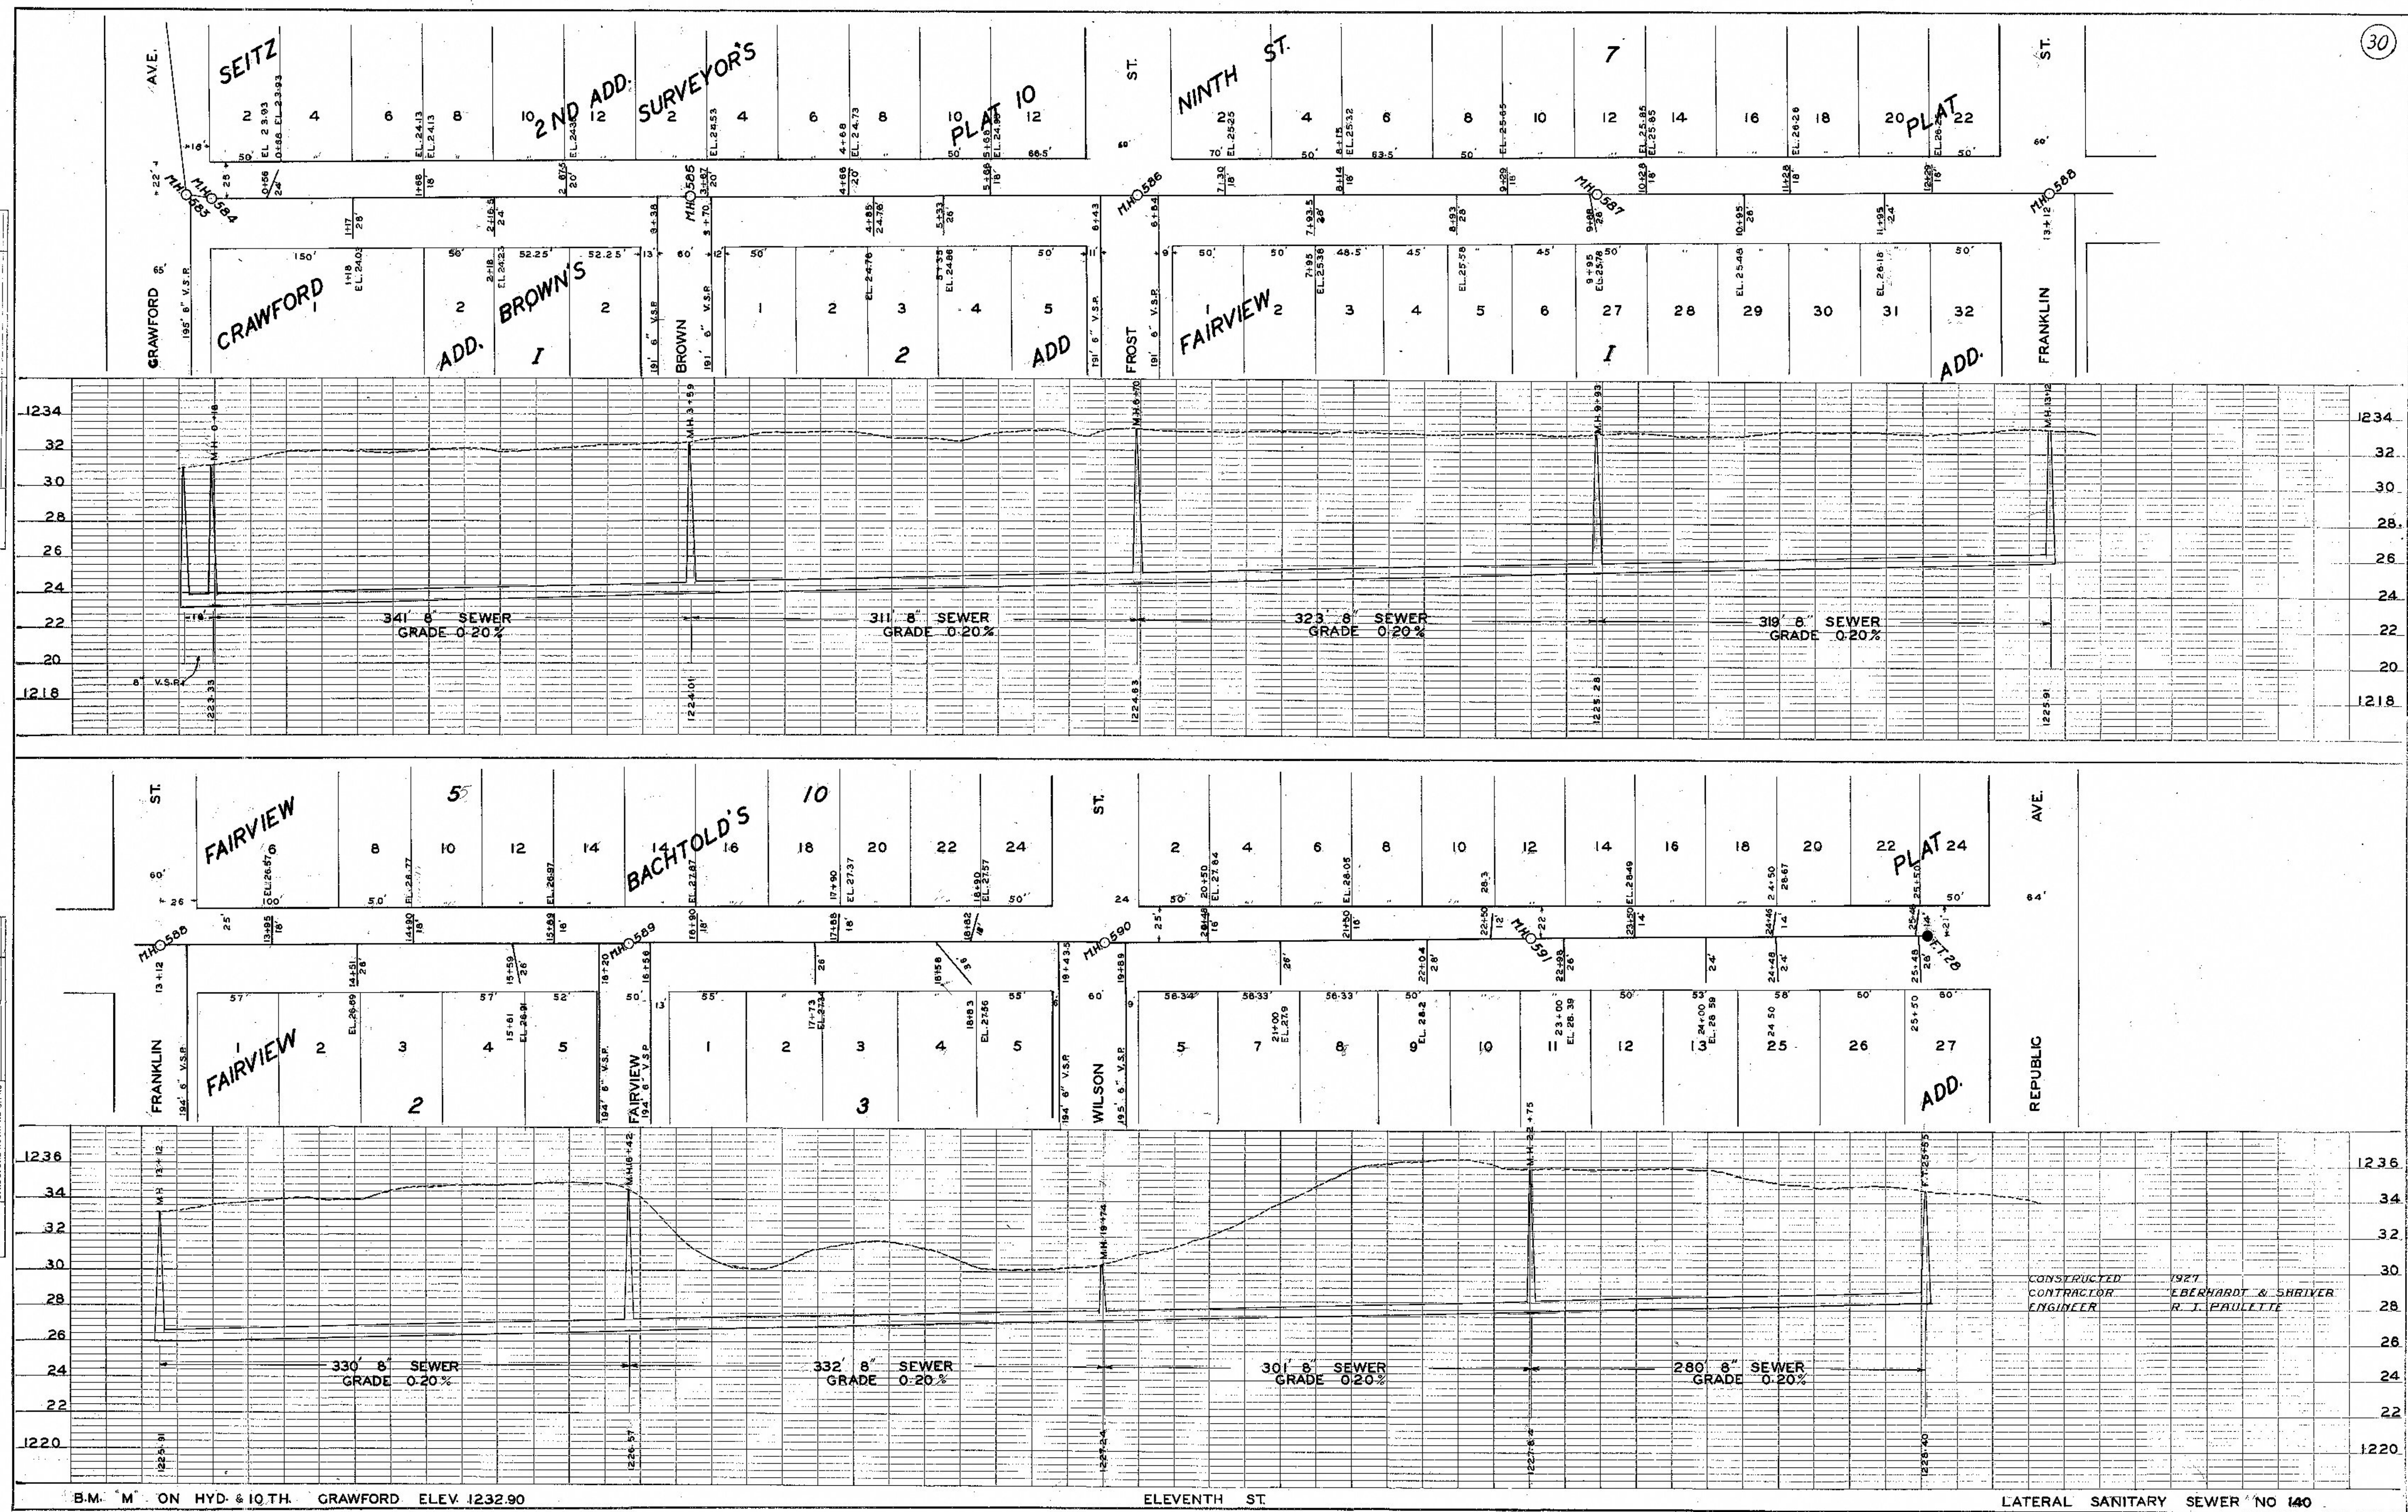

CONSTRUCTED 1921
 CONTRACTOR EBERHARDT & SHRIVER
 ENGINEER R. J. PAULLETTE

B.M. M ON HYD. & 10 TH. GRAWFORD ELEV. 1232.90

ELEVENTH ST

LATERAL SANITARY SEWER NO 140