


PLAN	SURVEYED	DATE
	PLOTTED	BY
	NOTE BOOK	NO.
	ALIGNMENT CHECKED	
	REL. OF W/L CHECKED	

PROFILE	SURVEYED	DATE
	PLOTTED	BY
	NOTE BOOK	NO.
	GRADES CHECKED	
	STRUCTURE LOCATIONS CHECKED	

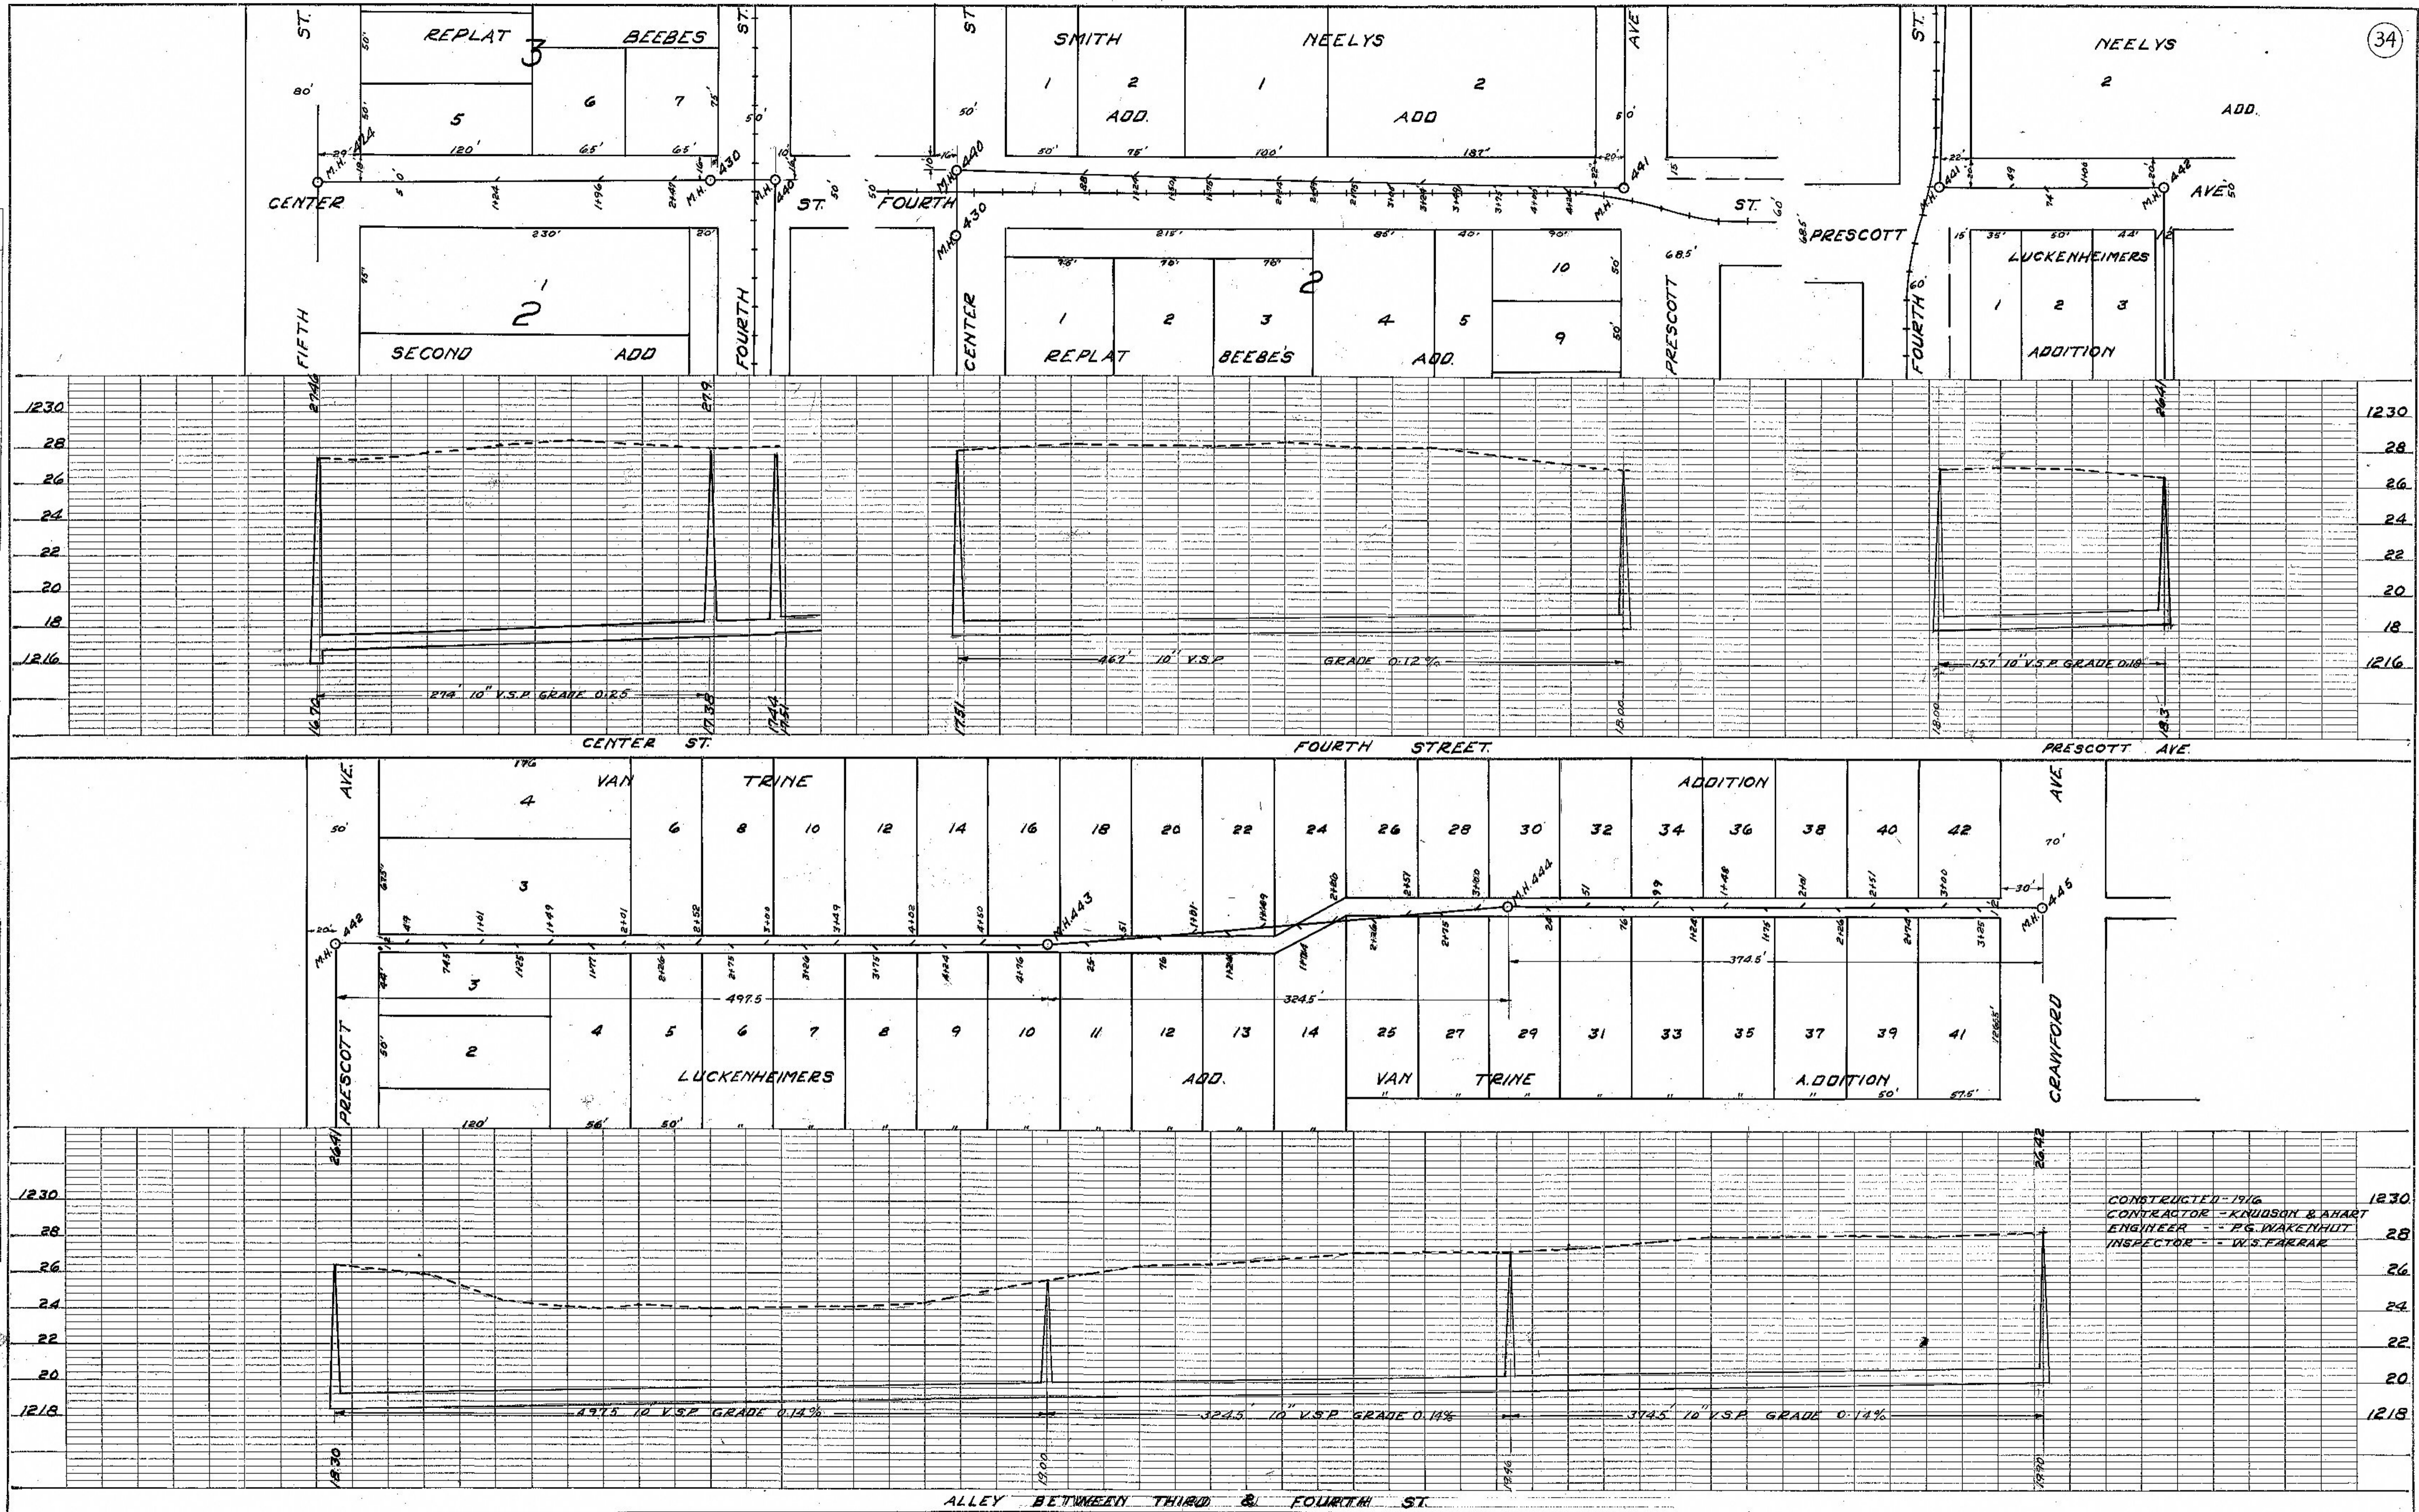

CONSTRUCTED - 1916
 CONTRACTOR - KNUDSON & AHART
 ENGINEER - F.G. WAKENHUT
 INSPECTOR - W.S. FARRAR