


DATE _____ BY _____
 PLAN SURVEYED _____
 PLOTTED _____
 ALIGNED CHECKED _____
 ROUTE BOOK _____
 NO. _____

DATE _____ BY _____
 PROFILE SURVEYED _____
 PLOTTED _____
 ALIGNED CHECKED _____
 ROUTE BOOK _____
 NO. _____

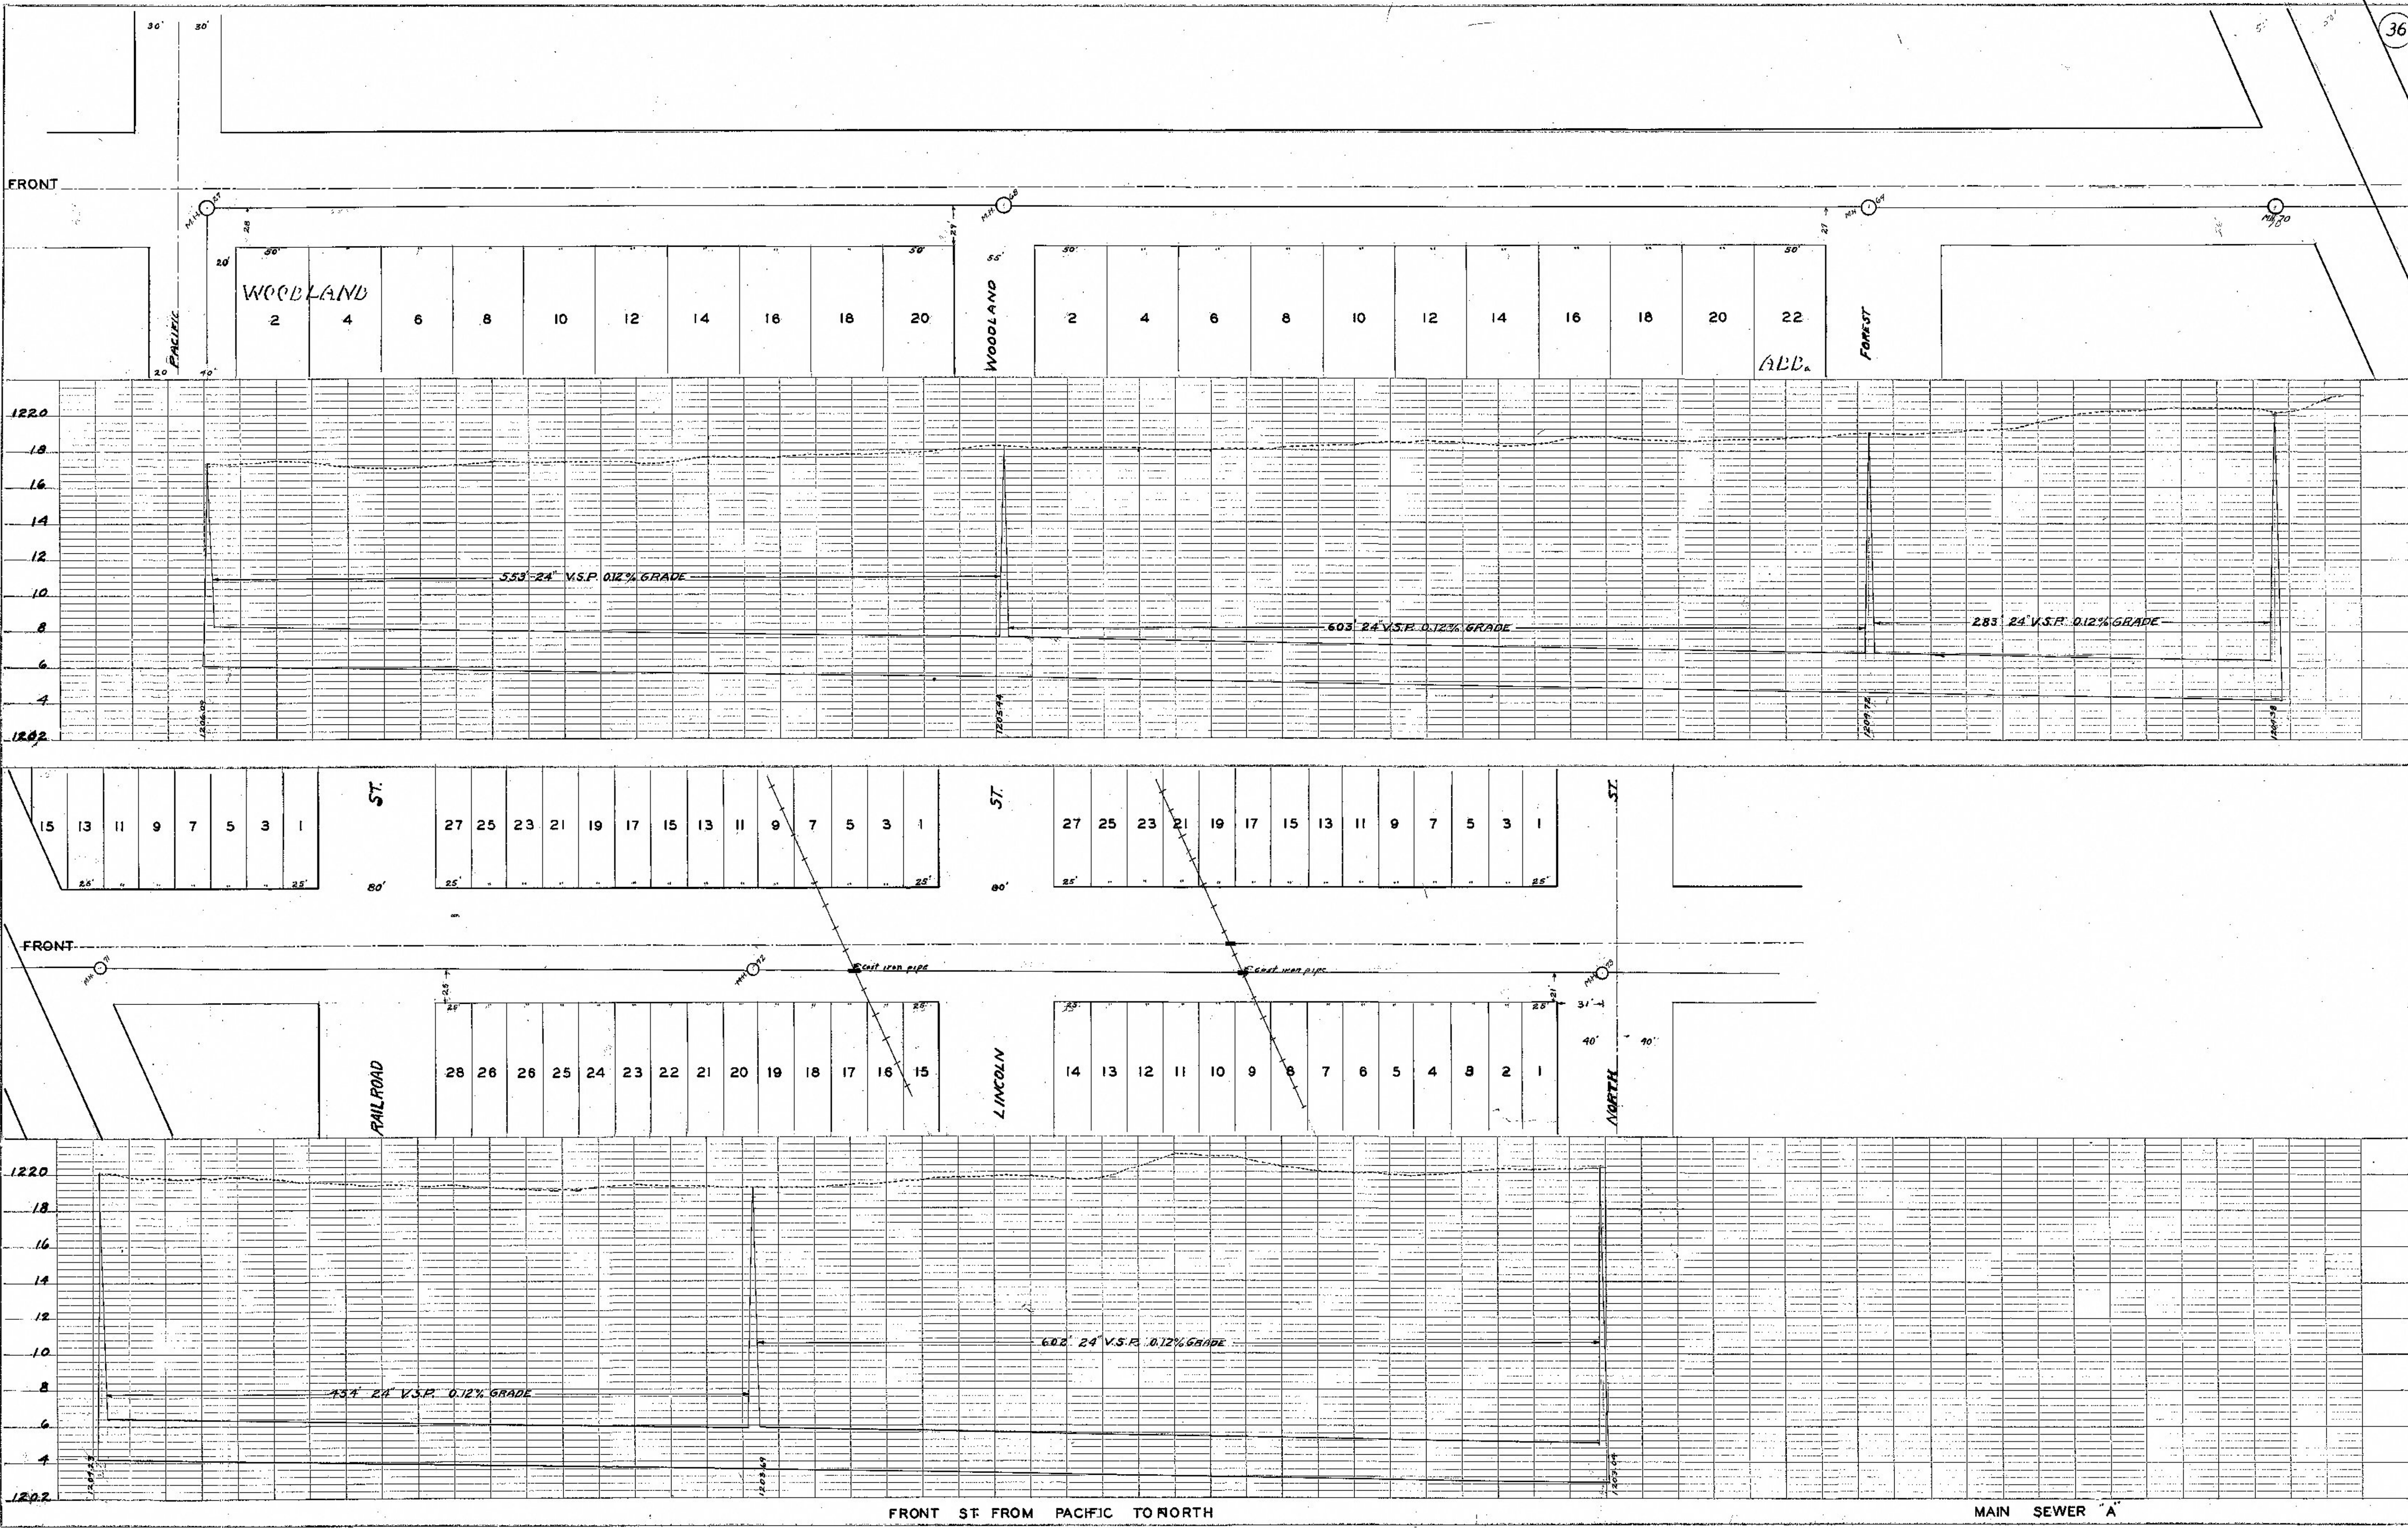

FRONT ST FROM PACIFIC TO NORTH

MAIN SEWER A