
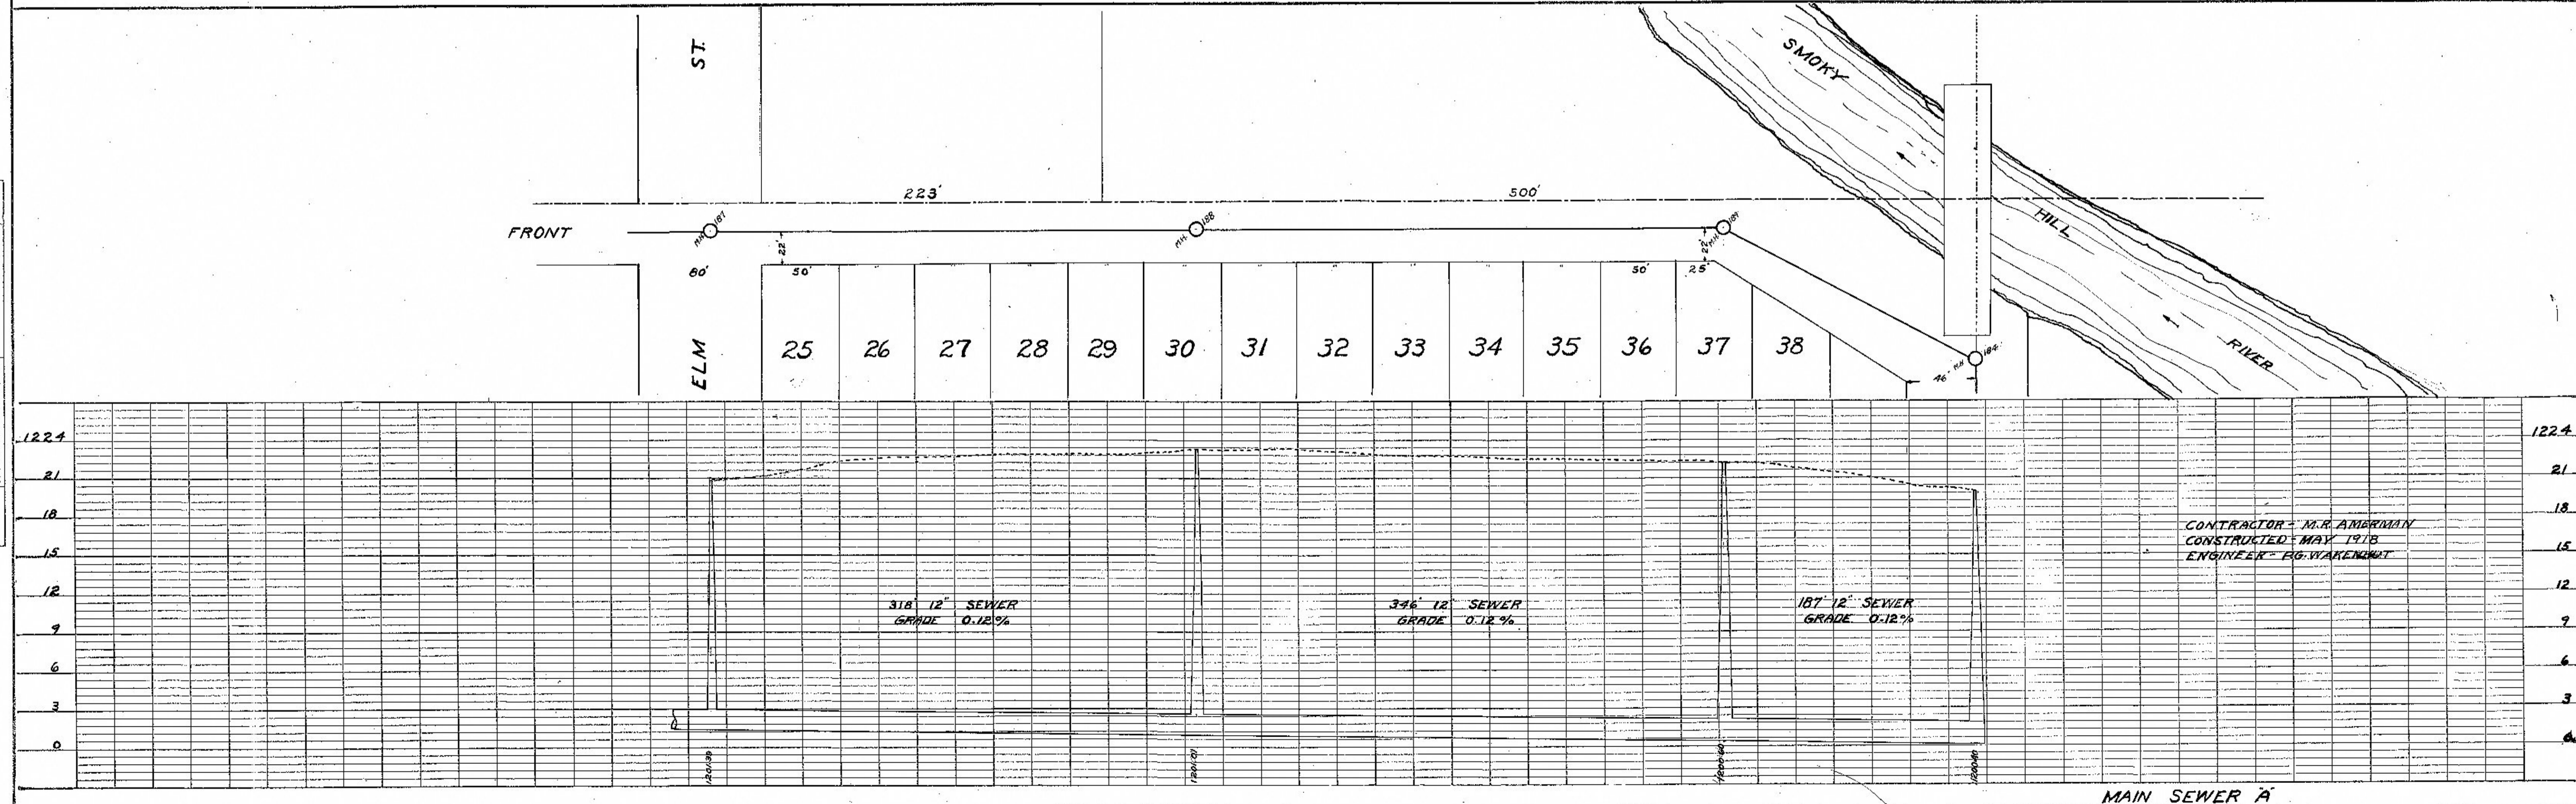


PLAN  
 SURVING  
 PLOTTED  
 NOTE BOOK  
 NO. OF W.P. CHECKED

PROFILE  
 SURVING  
 GRADES CHECKED  
 NOTE BOOK  
 NO. OF W.P. CHECKED

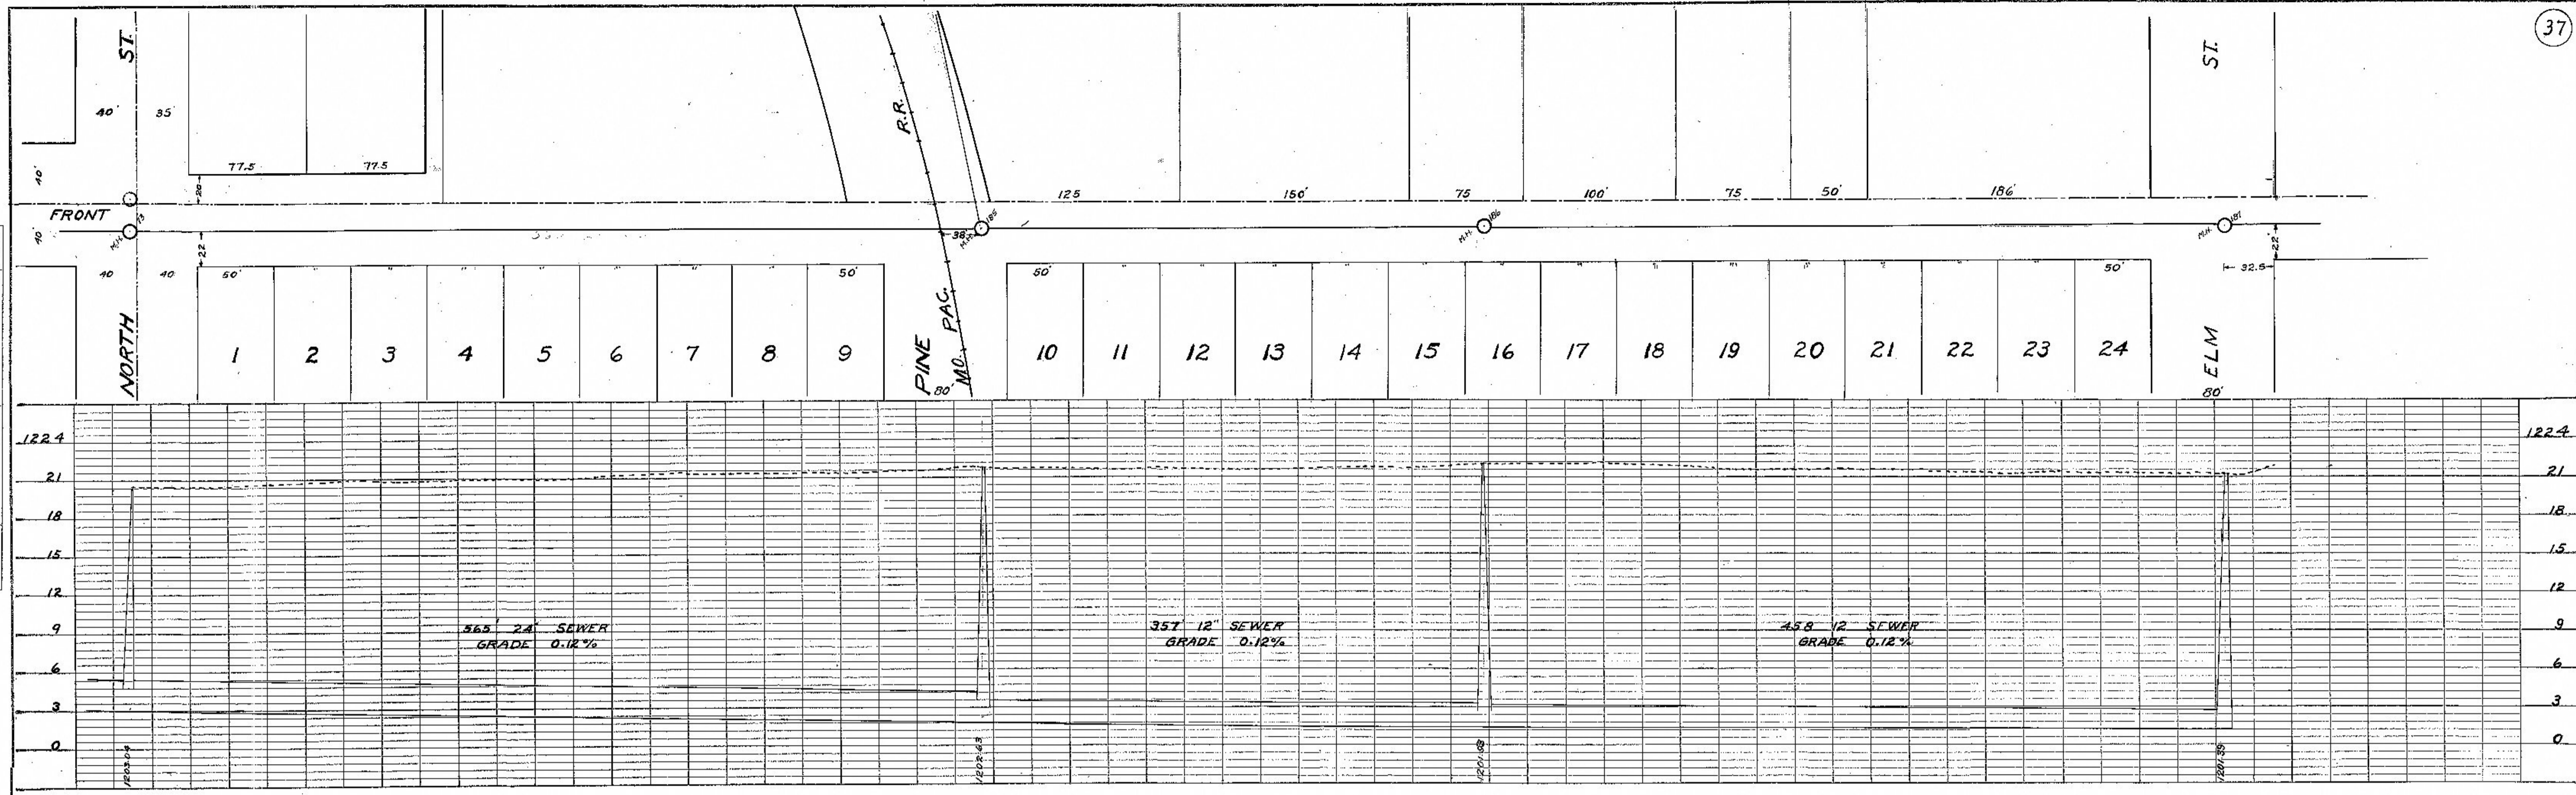

MAIN SEWER A