
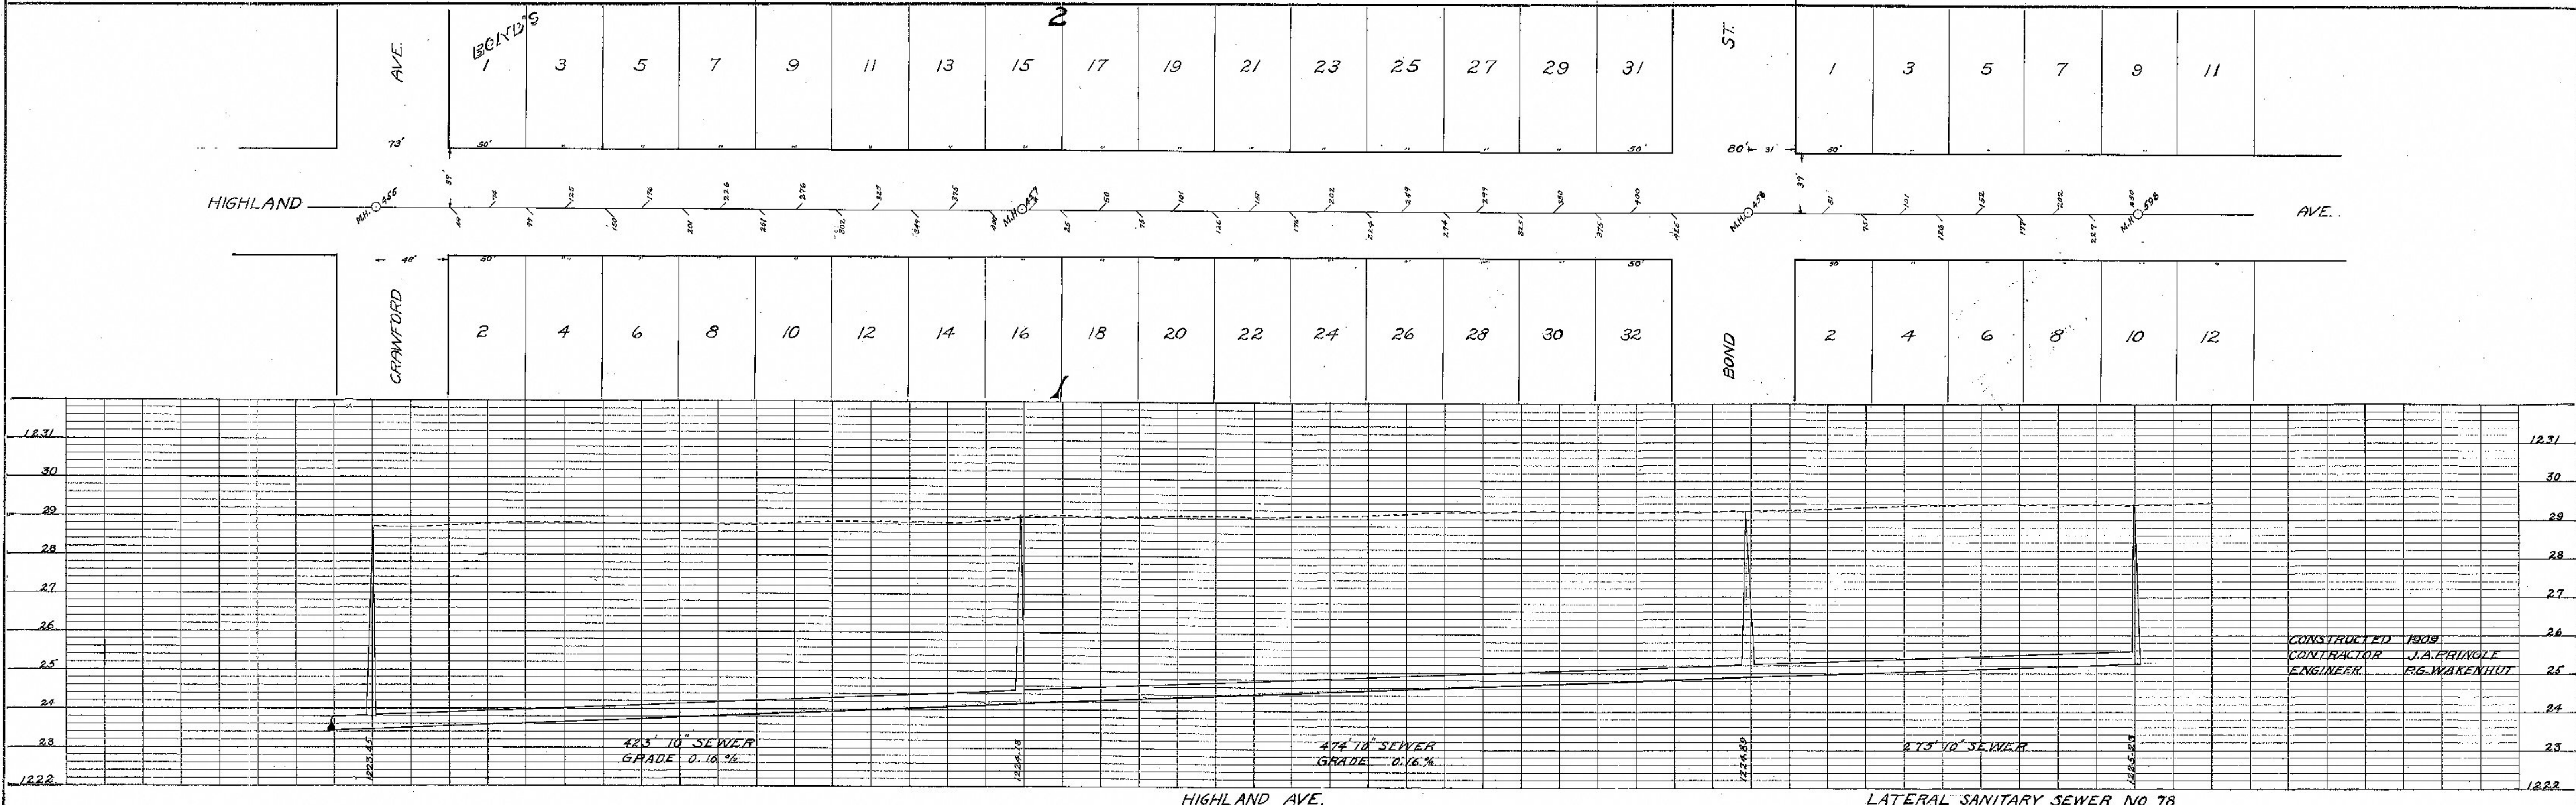


PLAN	DATE	
	BY	L.A.C.
SURVEYED	ALIGNED	
	PLOTTED	
NOTE BOOK	CHECKED	
	BY	
NO.		

PROFILE	DATE	
	BY	L.A.C.
NOTE BOOK	CHECKED	
	BY	
NO.		

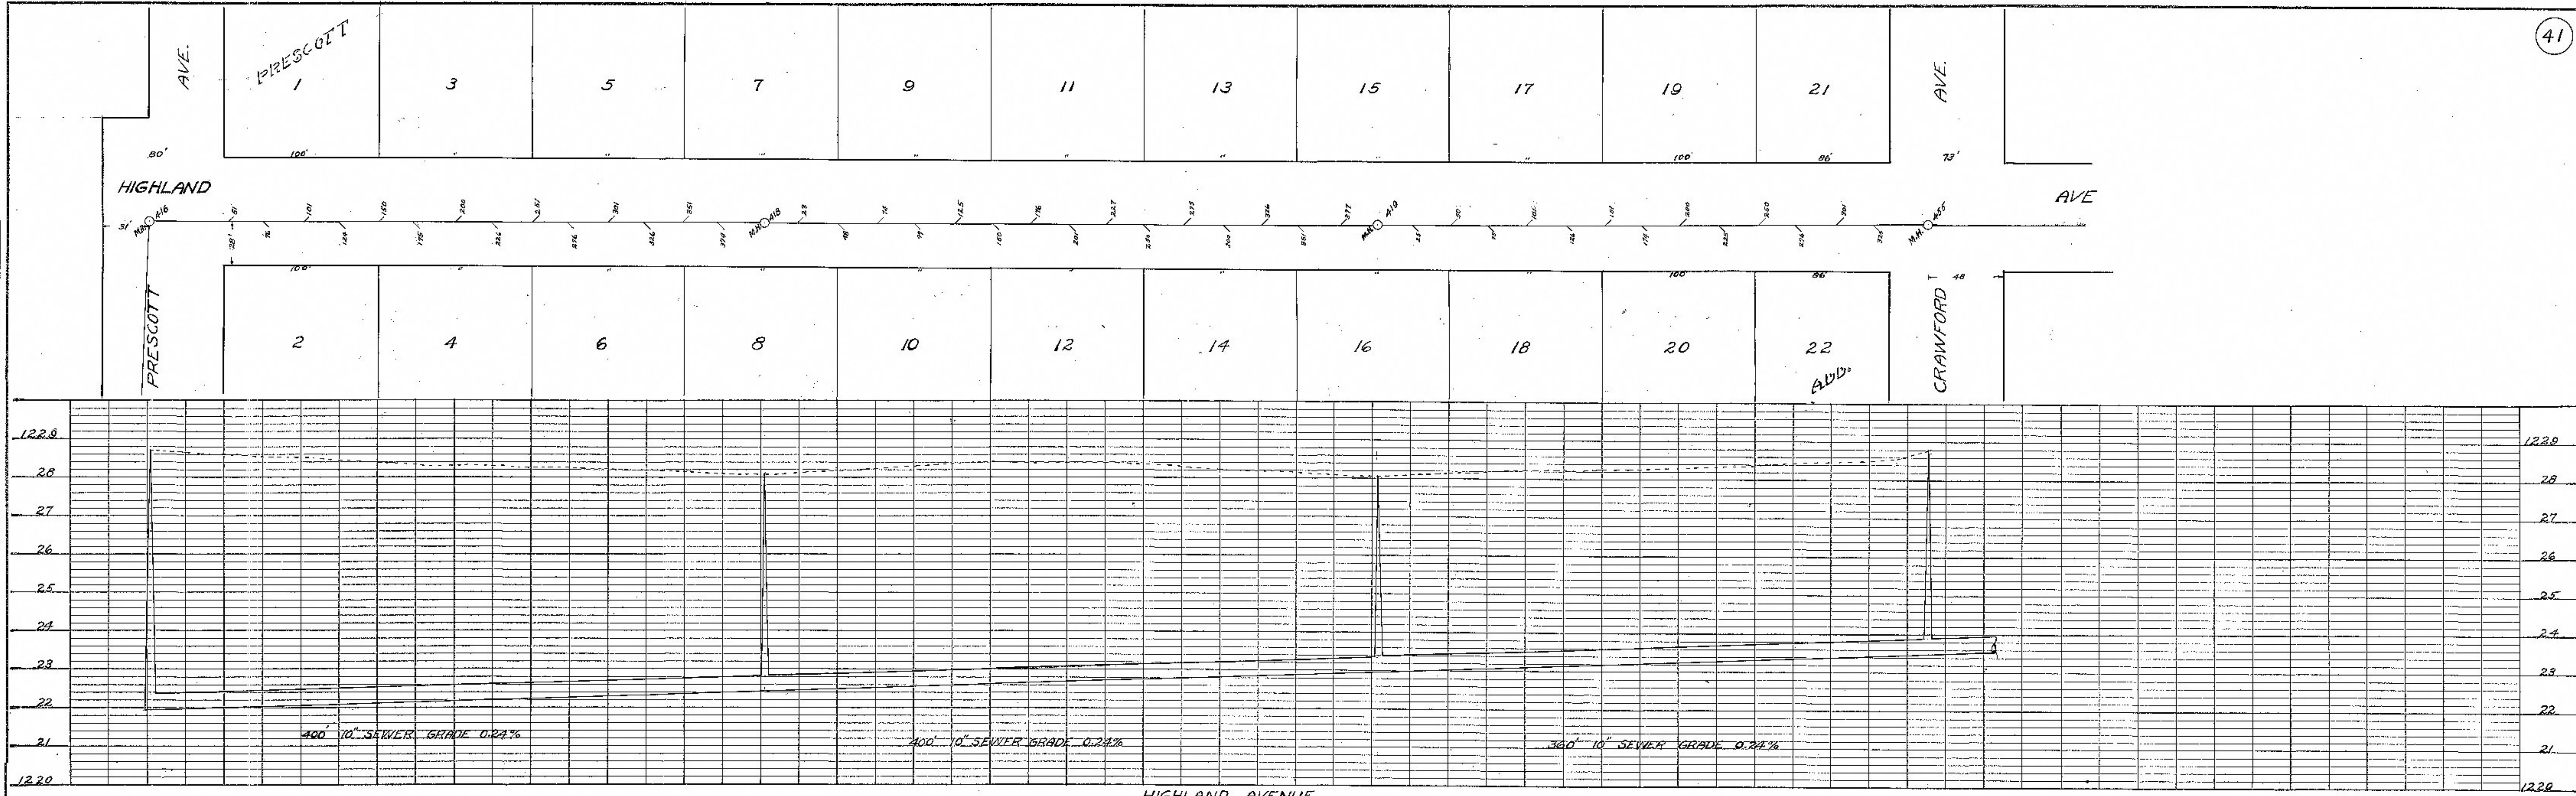

CONSTRUCTED 1909
 CONTRACTOR J.A. PRINGLE
 ENGINEER R.G. WAKENHUT