


DATE: _____
 BY: _____
 CHECKED: _____
 TITLE: _____
 NO. _____

PLAN
 SURVEYED
 PLOTTED
 NOTE BOOK
 ALIGNED
 CHECKED
 RT. OF WAY
 CHECKED
 NO. _____

NEW
 REB.

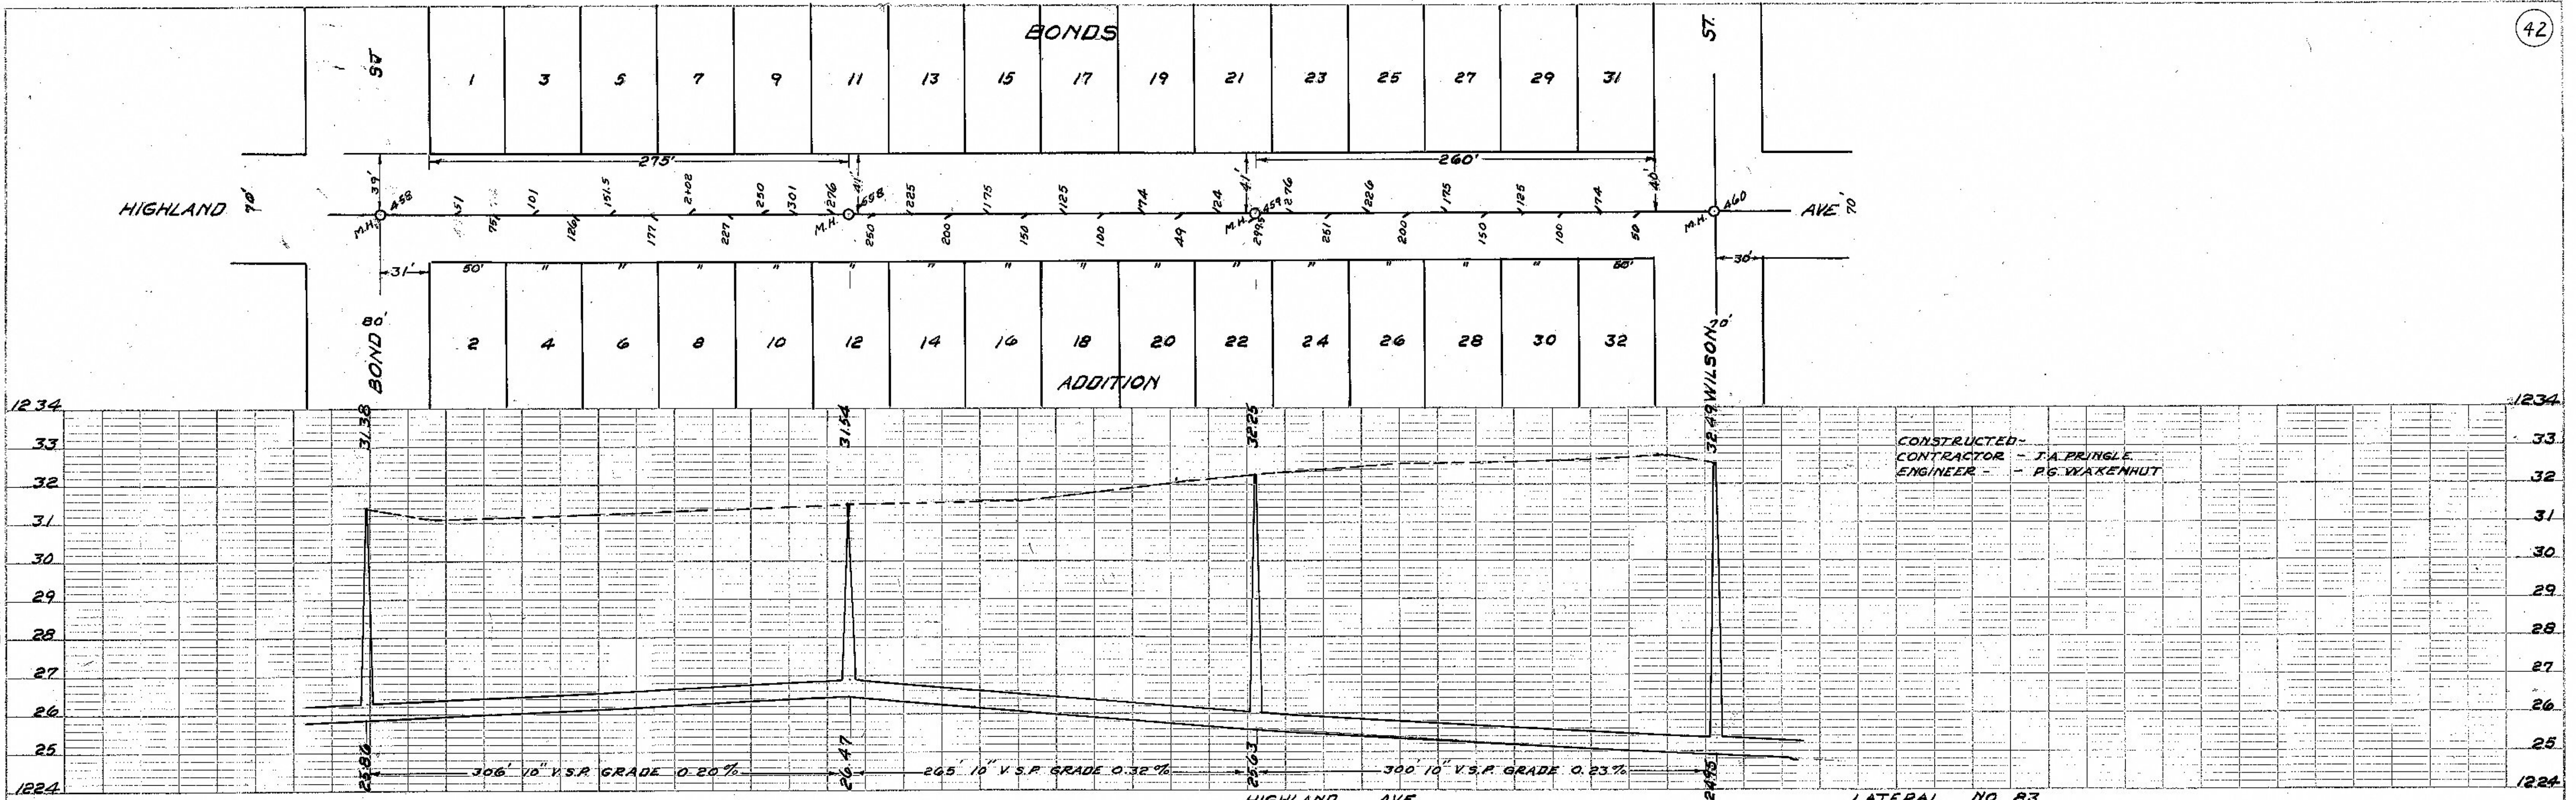

DATE: _____
 BY: _____
 CHECKED: _____
 TITLE: _____
 NO. _____

PROFILE
 SURVEYED
 PLOTTED
 NOTE BOOK
 ALIGNED
 CHECKED
 C.M.S. NOTED
 SPEC. TO BE NOTED
 NO. _____

NEW
 REB.

