
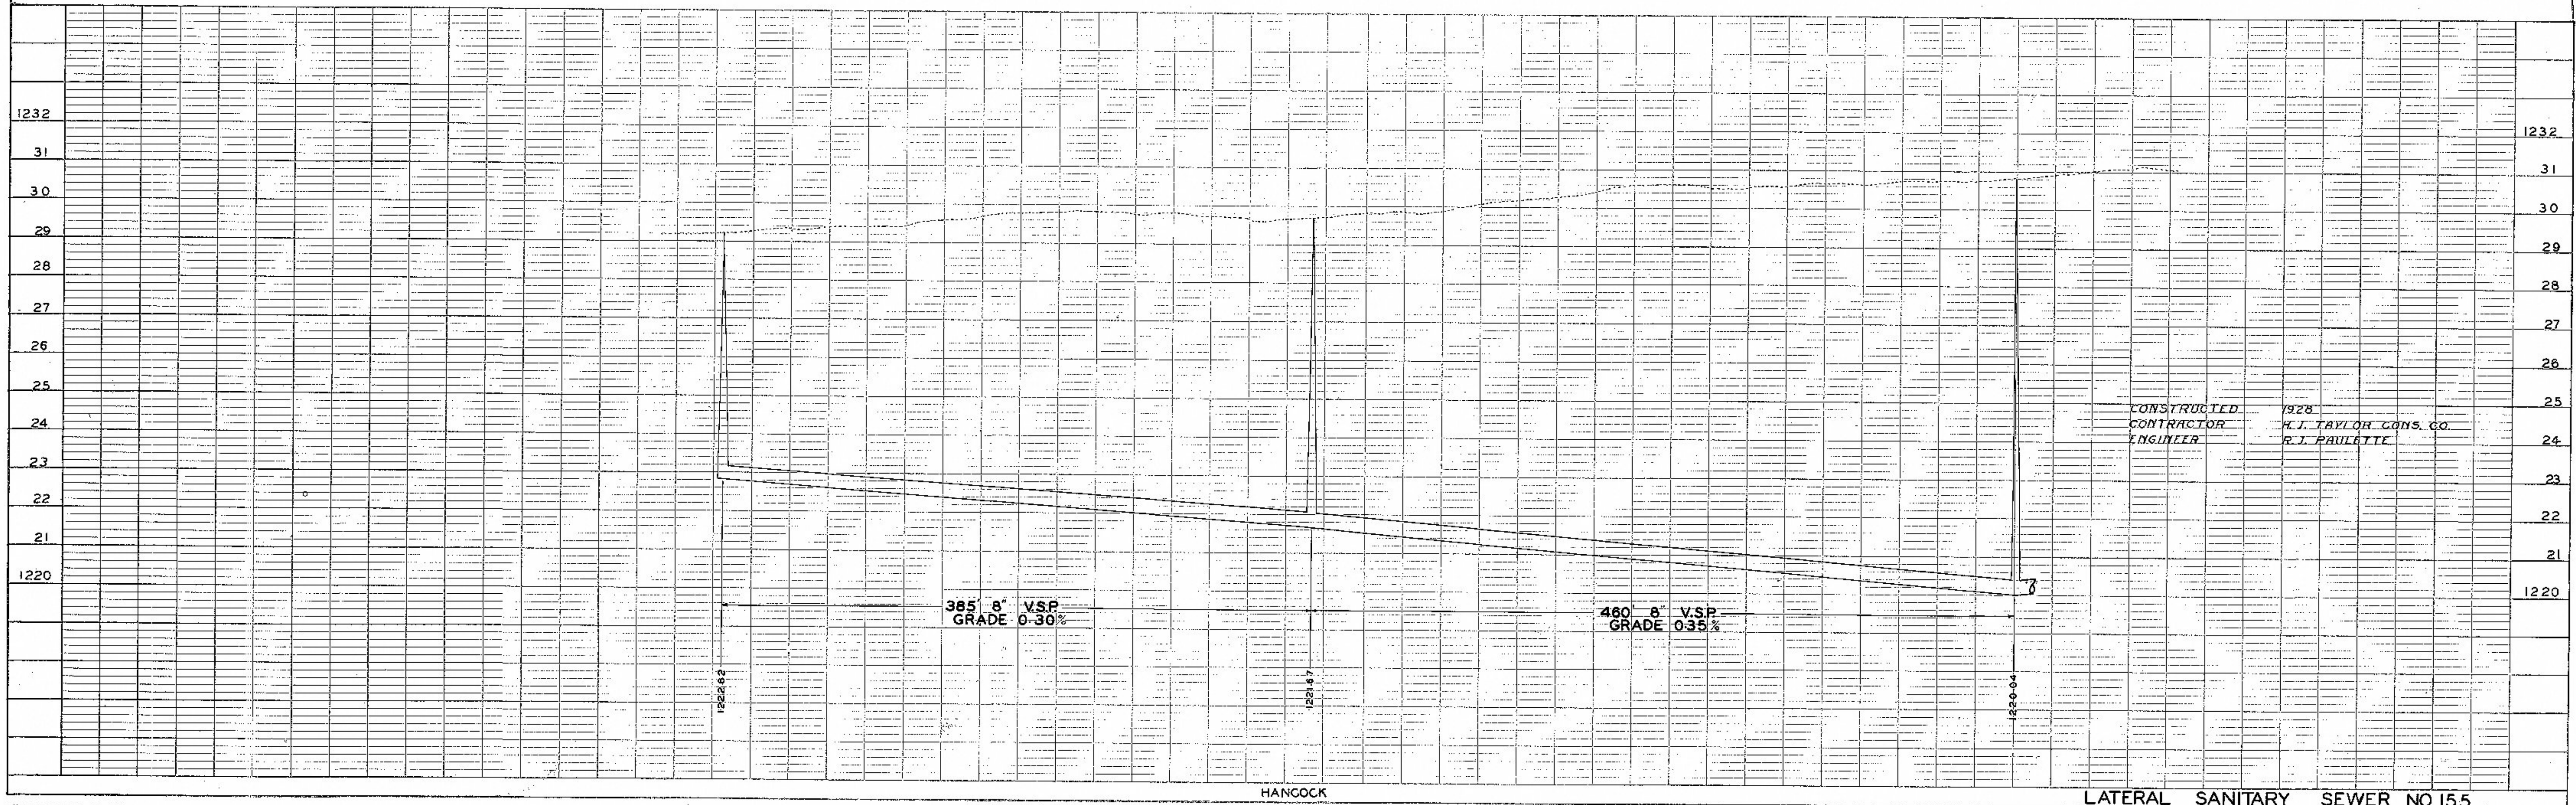


PLAN SURVEYED BY DATE
 NOTE BOOK NO. LAM SANCY
 PLOTTED BY L.A. CARROLL
 ALIGNMENT CHECKED
 RT. OF WAY CHECKED

PROFILE SURVEYED BY DATE
 NOTE BOOK NO. LAM SANCY
 PLOTTED BY L.A. CARROLL
 GRADES CHECKED
 STRUCTURE NOTATIONS CHECKED

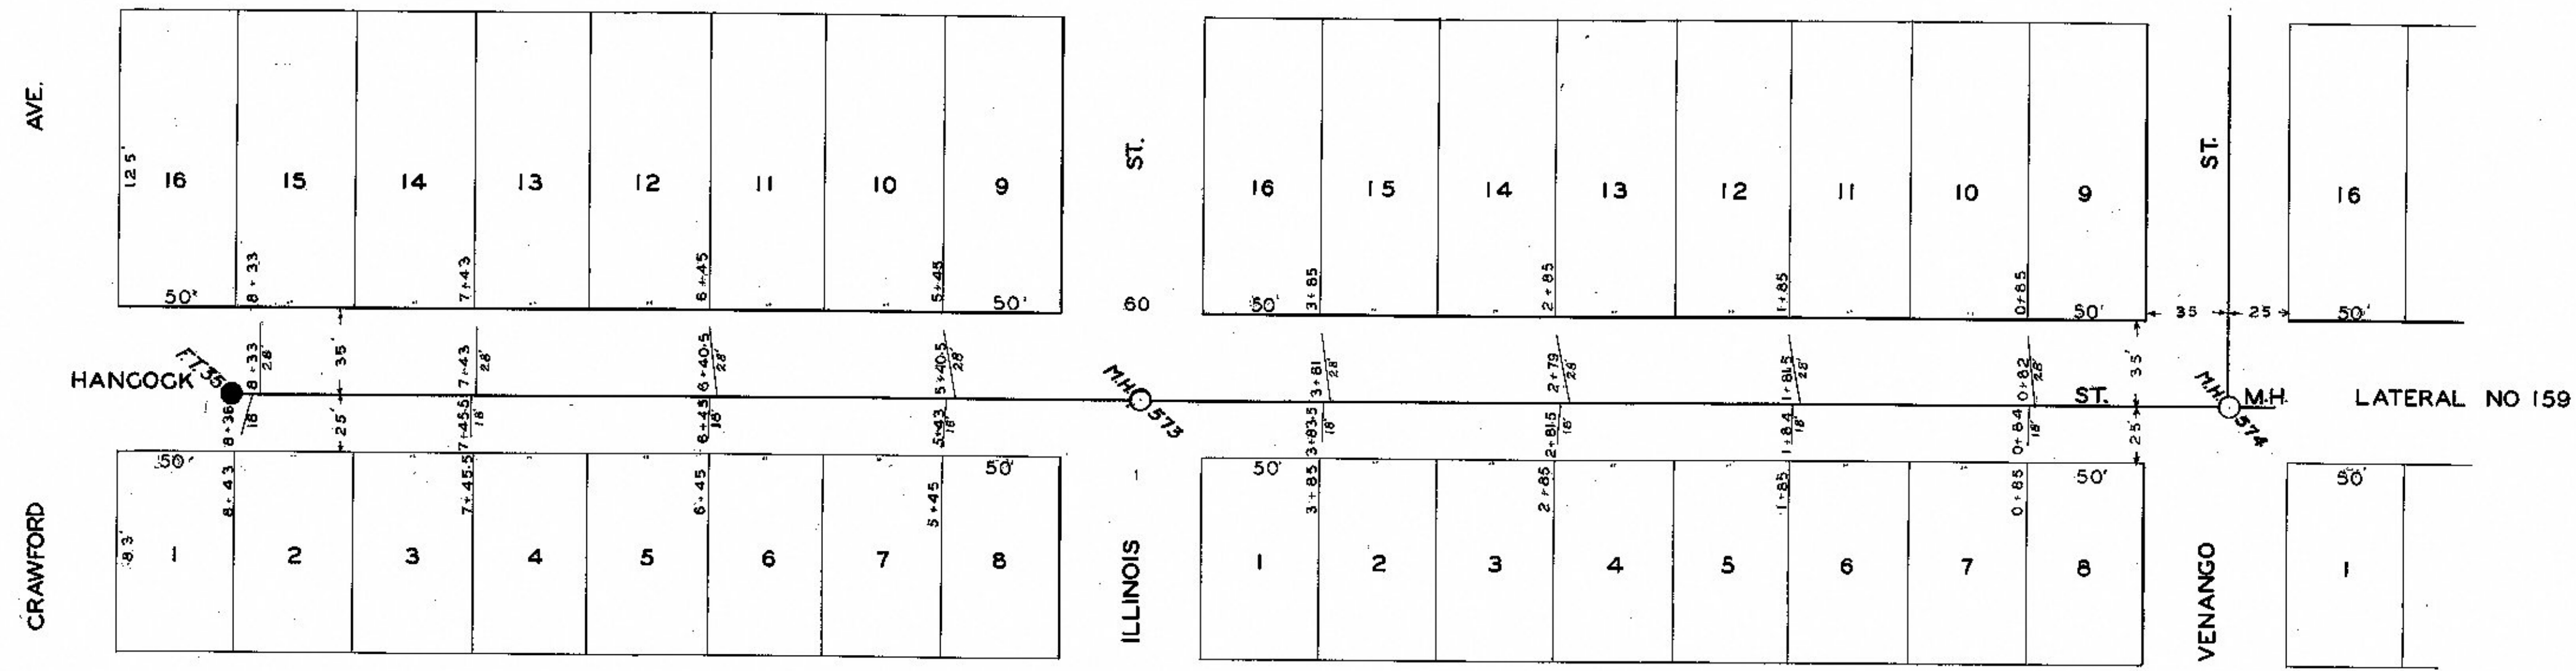

CONSTRUCTED 1928
 CONTRACTOR H.J. TAYLOR CONS. CO.
 ENGINEER R.J. PAULLETTE