


PLAN
 SURVEYED BY
 CHECKED BY
 DATE
 M.E.B.
 2-28-23
 NOTE: ROOM GRADIENTS CHECKED BY M.E.B. 2-28-23
 RT. OF WAY CHECKED BY M.E.B. 2-28-23



PROFILE
 SURVEYED BY
 CHECKED BY
 DATE
 M.E.B.
 2-28-23
 NOTE: ROOM GRADIENTS CHECKED BY M.E.B. 2-28-23
 RT. OF WAY CHECKED BY M.E.B. 2-28-23

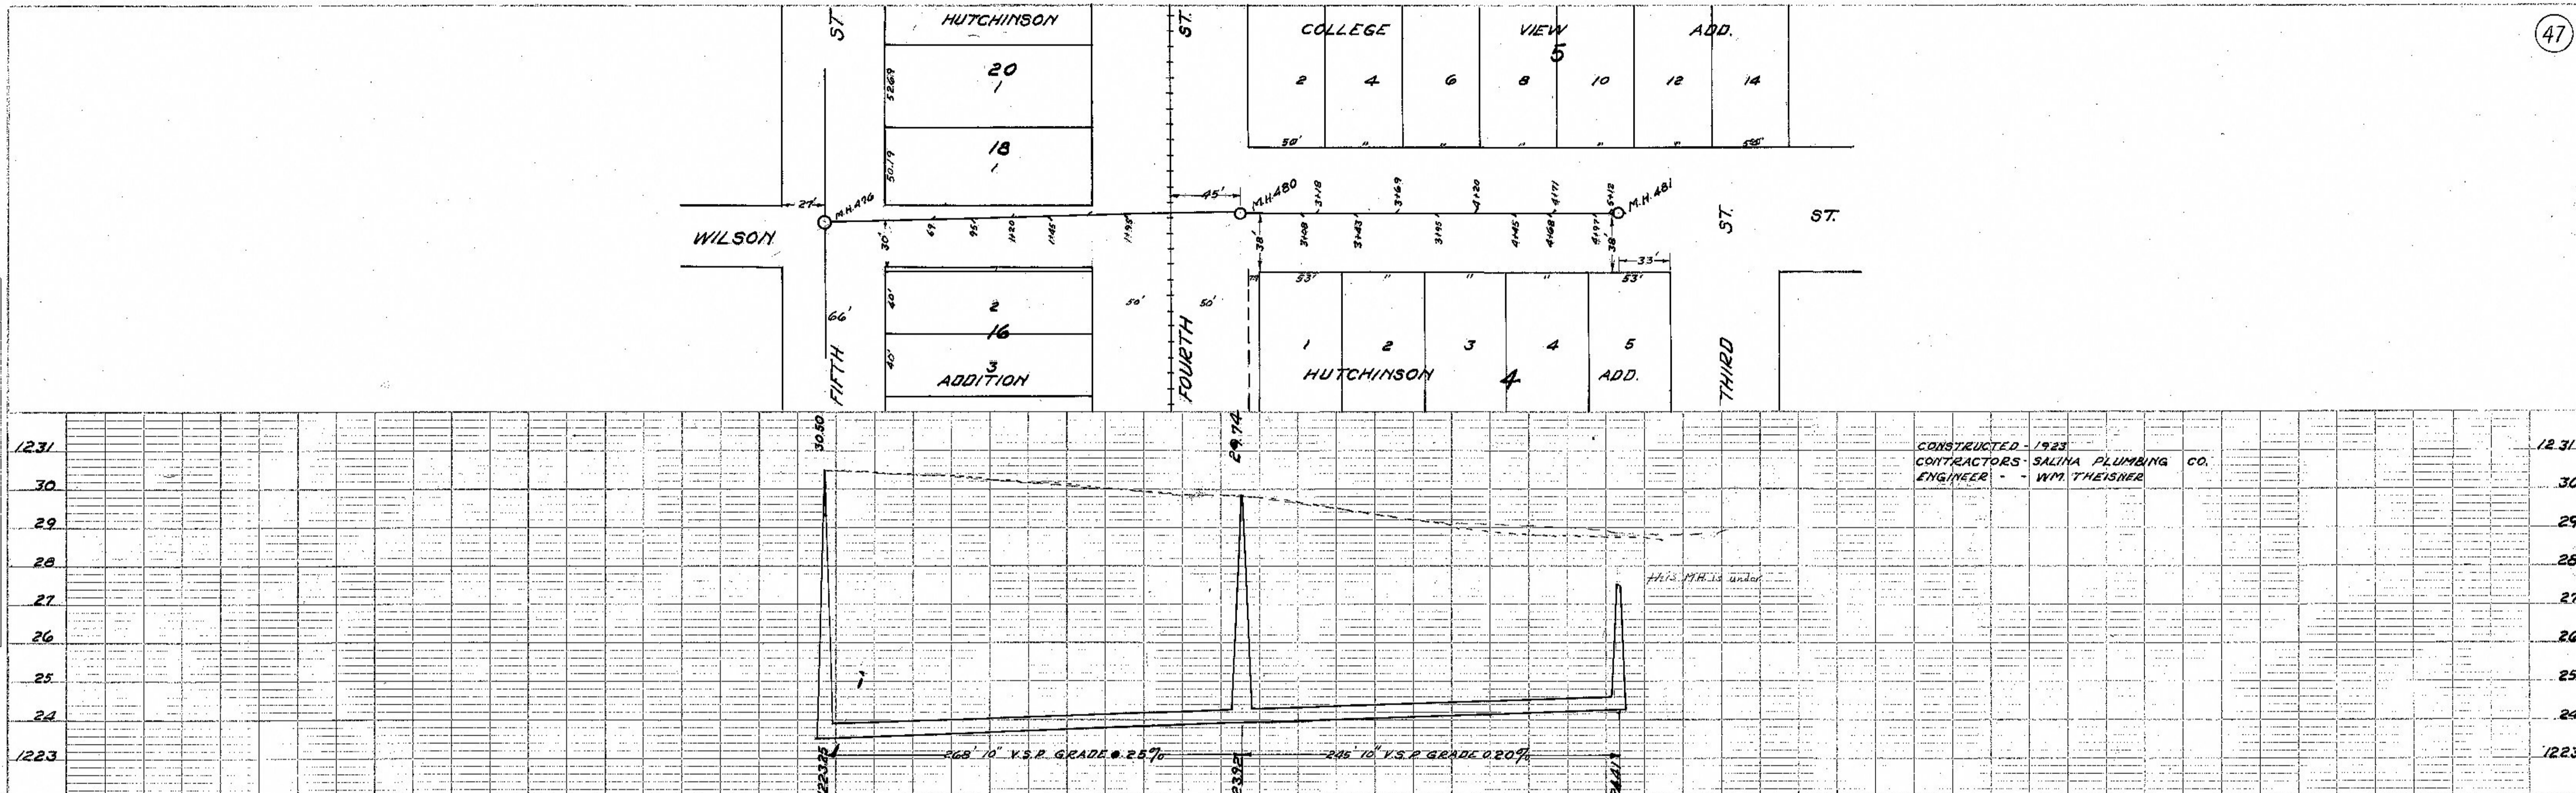