



DATE	
BY	HEB
SURVEYED	
PLOTTED	
ALIGNMENT CHECKED	
RET. OF WAY CHECKED	
PLAN	
NOTE BOOK NO.	

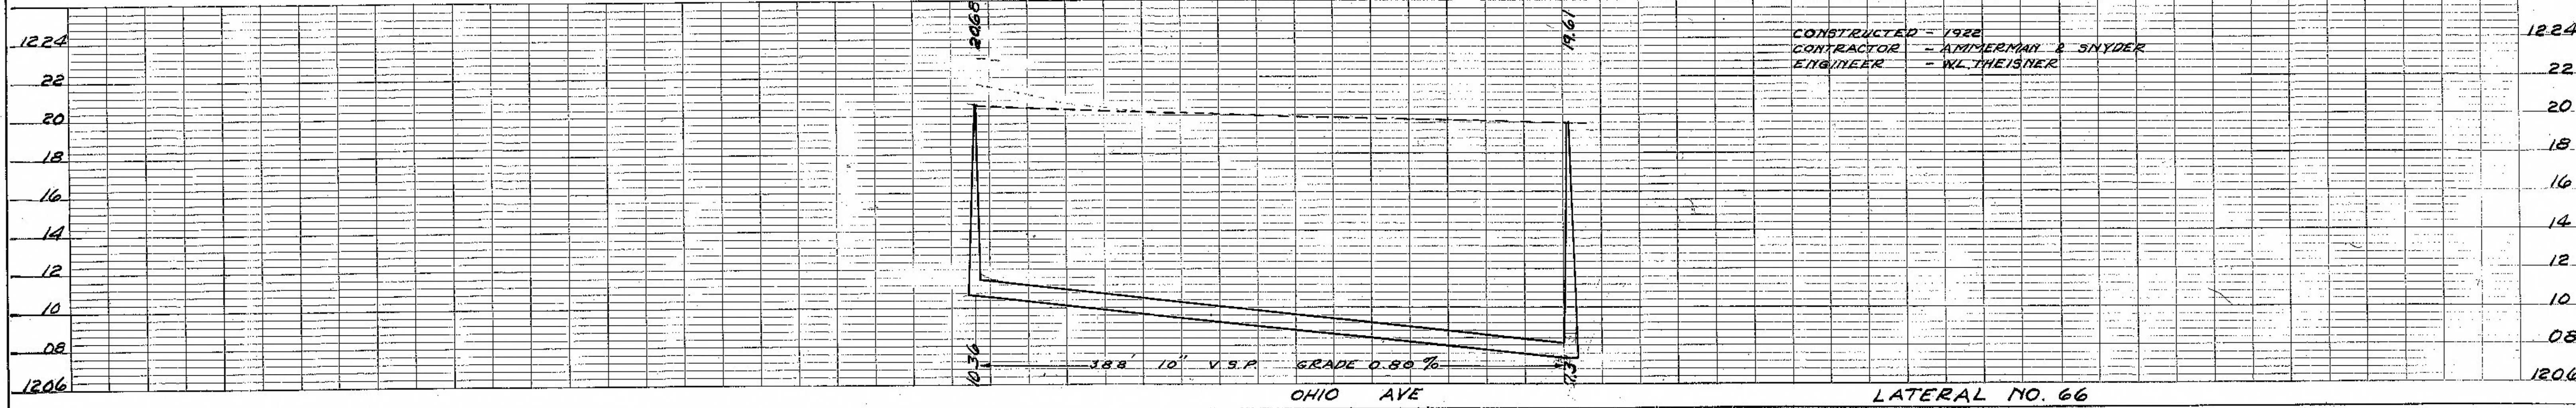

DATE	
BY	HEB
SURVEYED	
PLOTTED	
GRADES CHECKED	
RET. OF WAY CHECKED	
PROFILE	
NOTE BOOK NO.	
STRUCTURE NOTATIONS CHD	

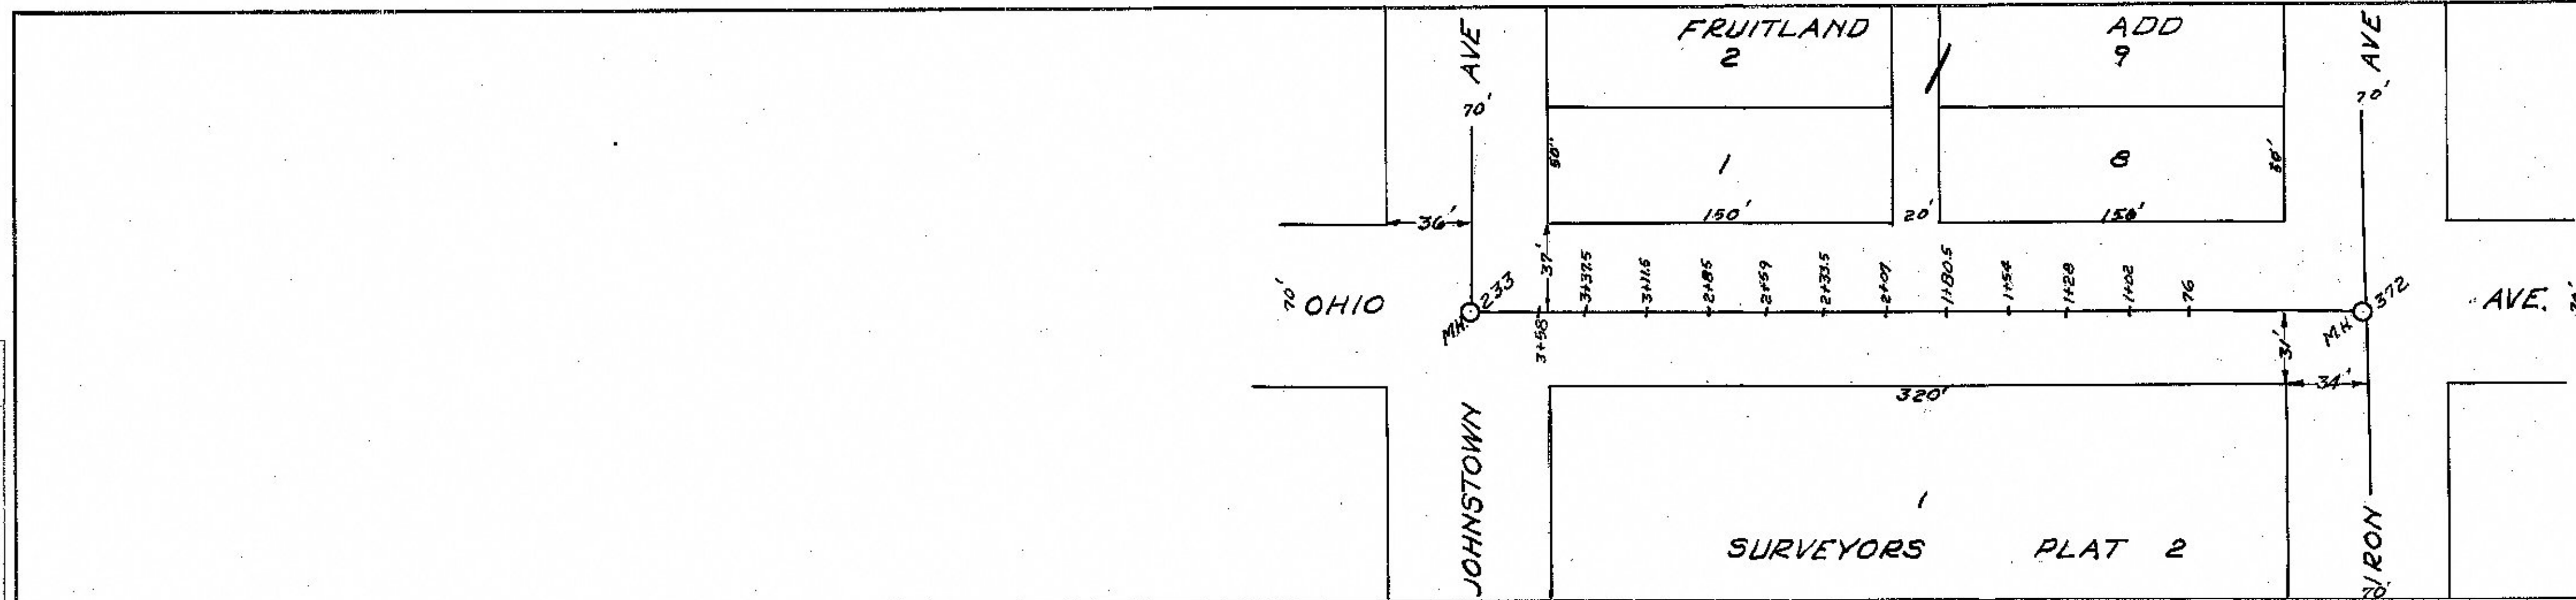