

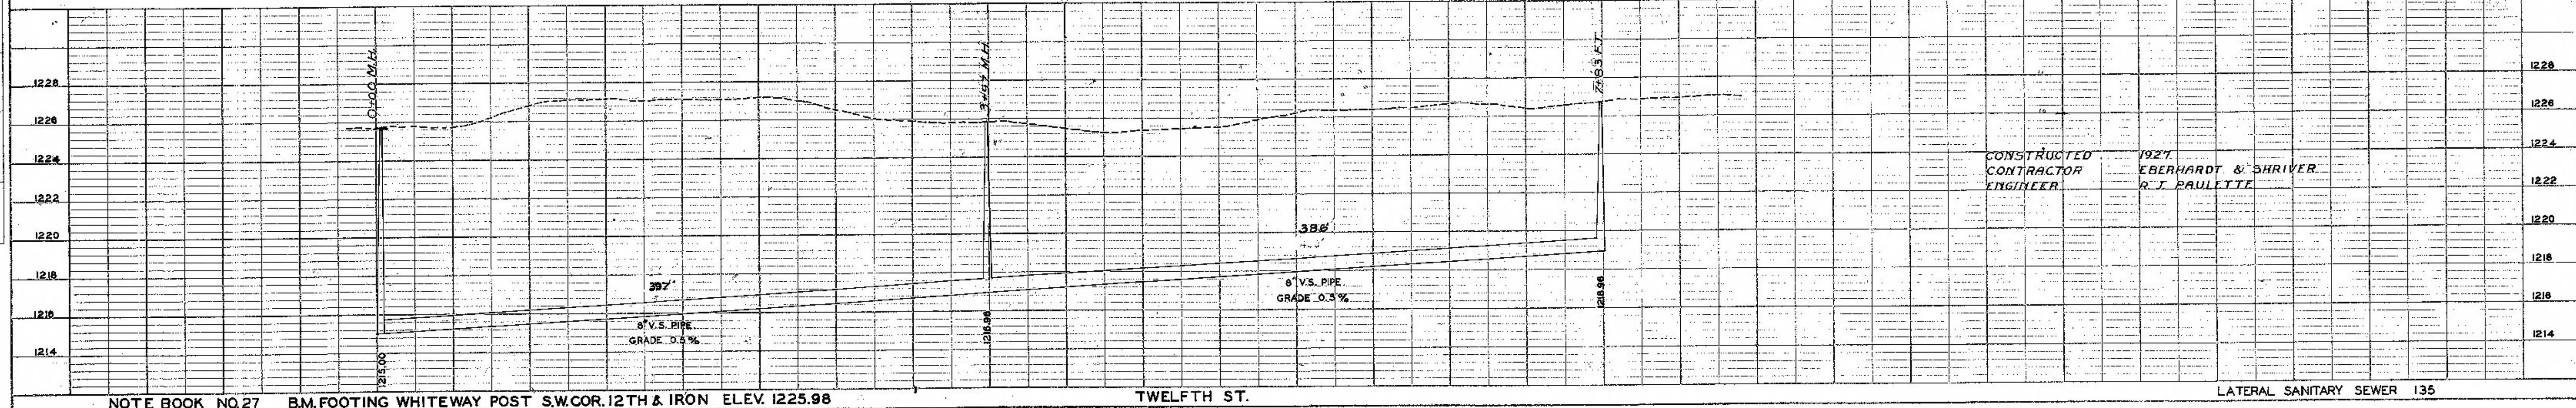
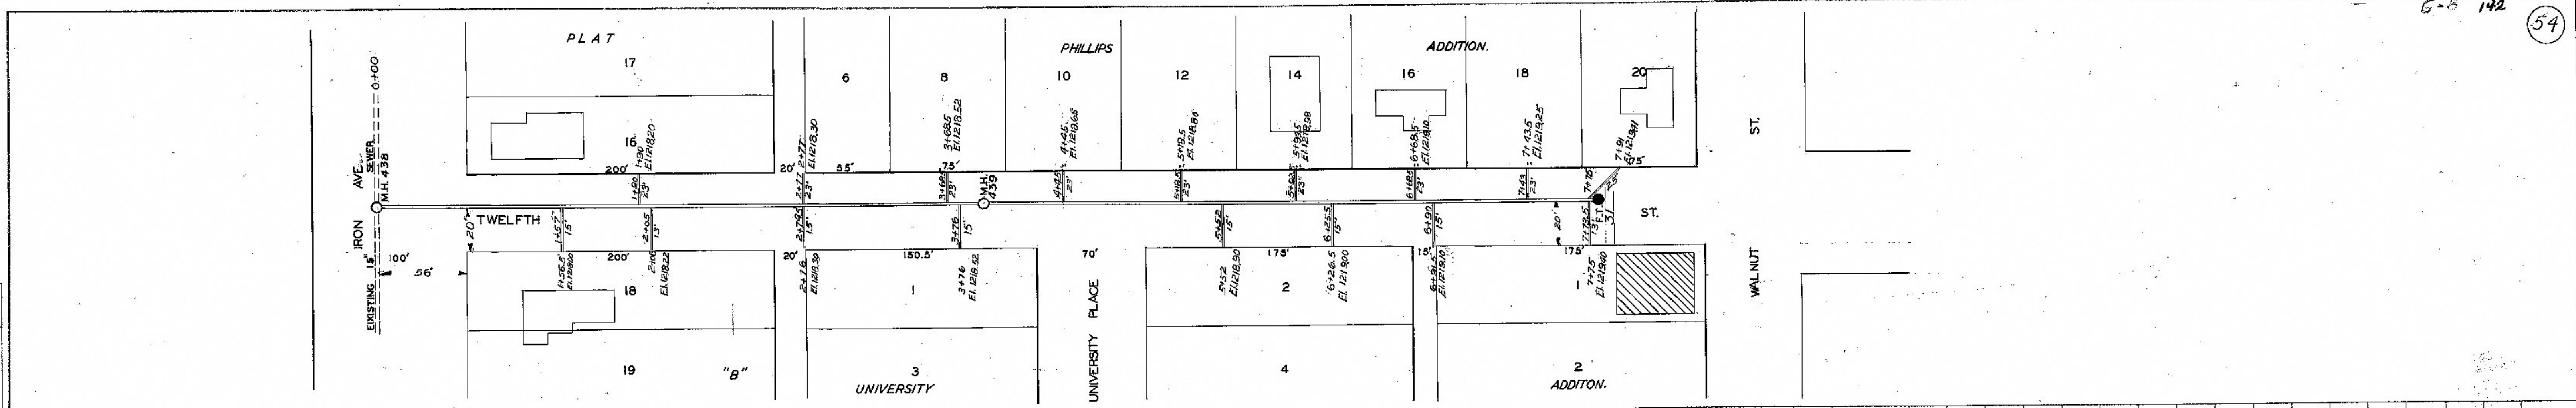


PLAN SURVEYED, PLOTTED, CHECKED, REVISIONS, DATE

PROFILE SURVEYED, PLOTTED, CHECKED, REVISIONS, DATE

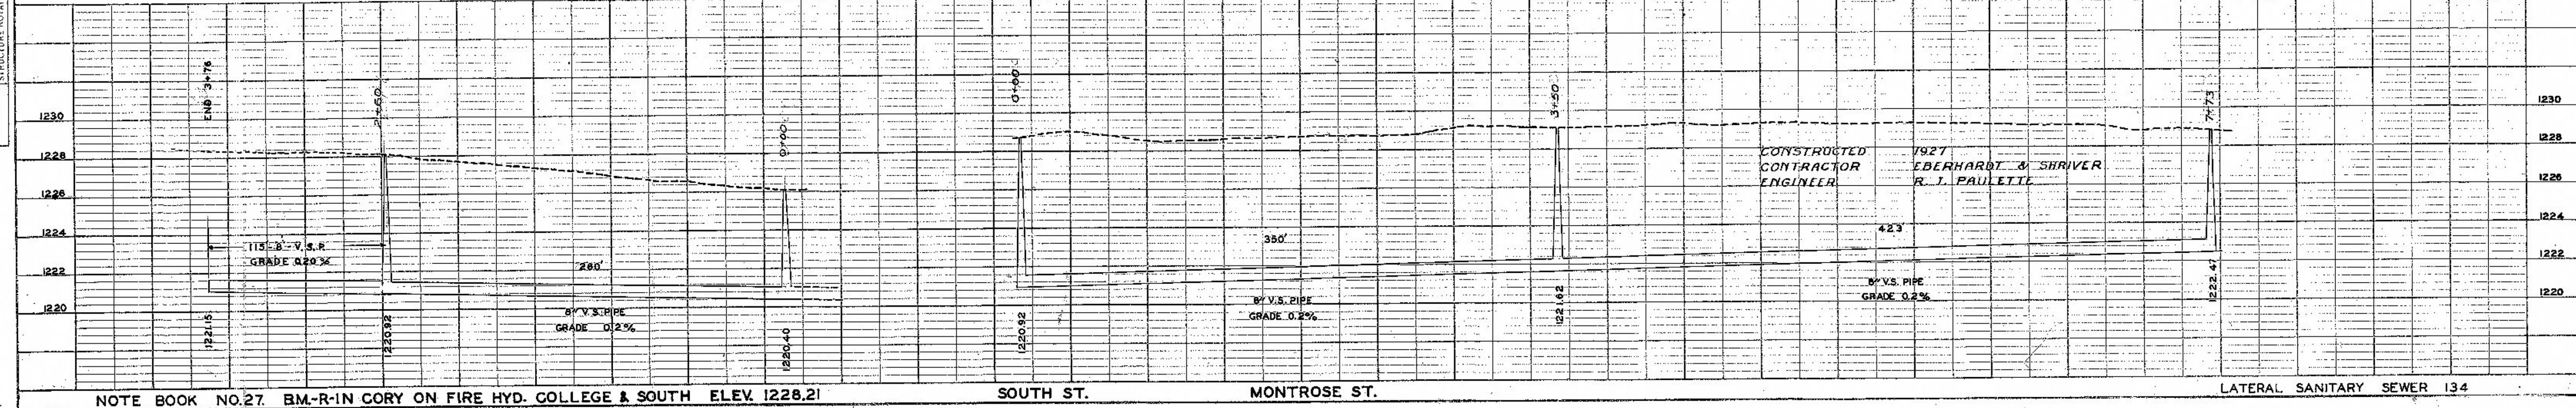

NOTE BOOK NO.27 B.M. FOOTING WHITEWAY POST S.W. COR. 12TH & IRON ELEV. 1225.98 TWELFTH ST. LATERAL SANITARY SEWER 135

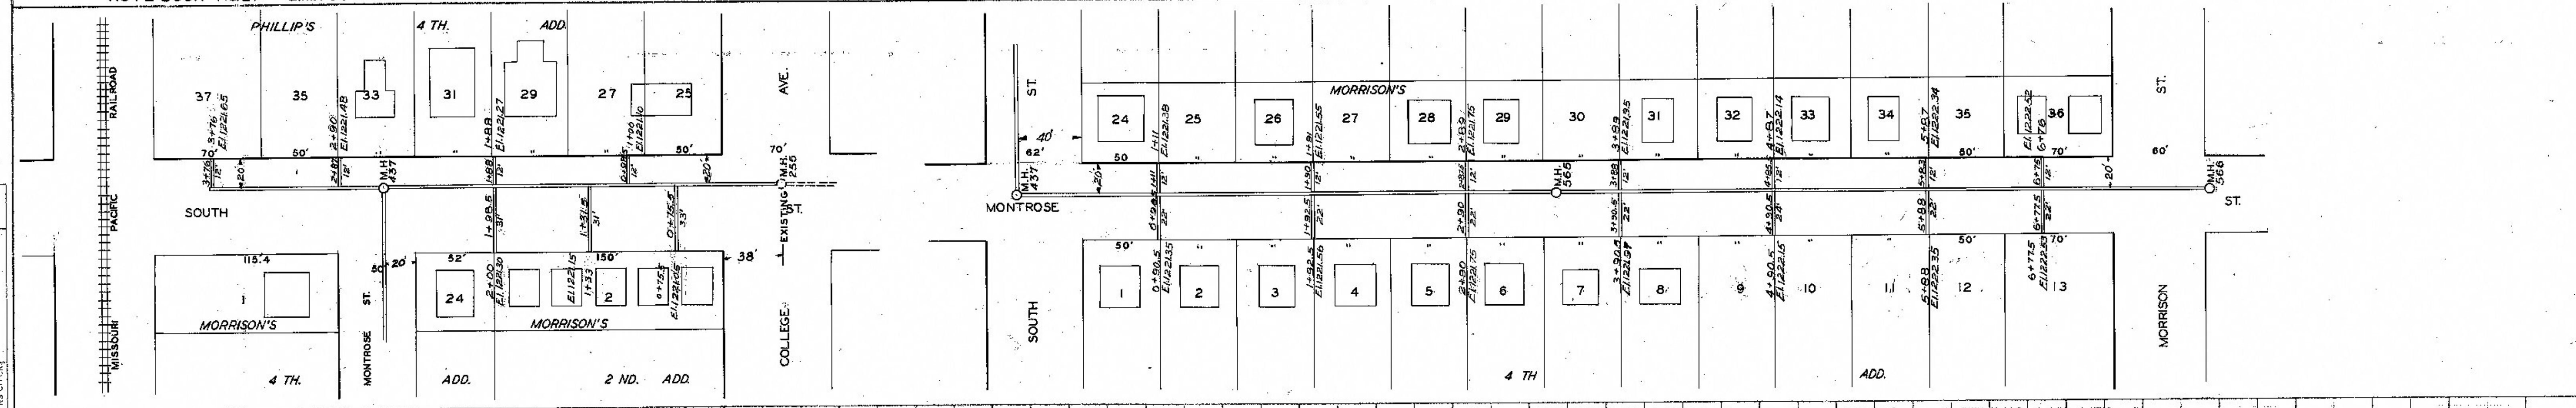

NOTE BOOK NO.27 B.M.-R-IN CORY ON FIRE HYD. COLLEGE & SOUTH ELEV. 1228.21 SOUTH ST. MONTROSE ST. LATERAL SANITARY SEWER 134