
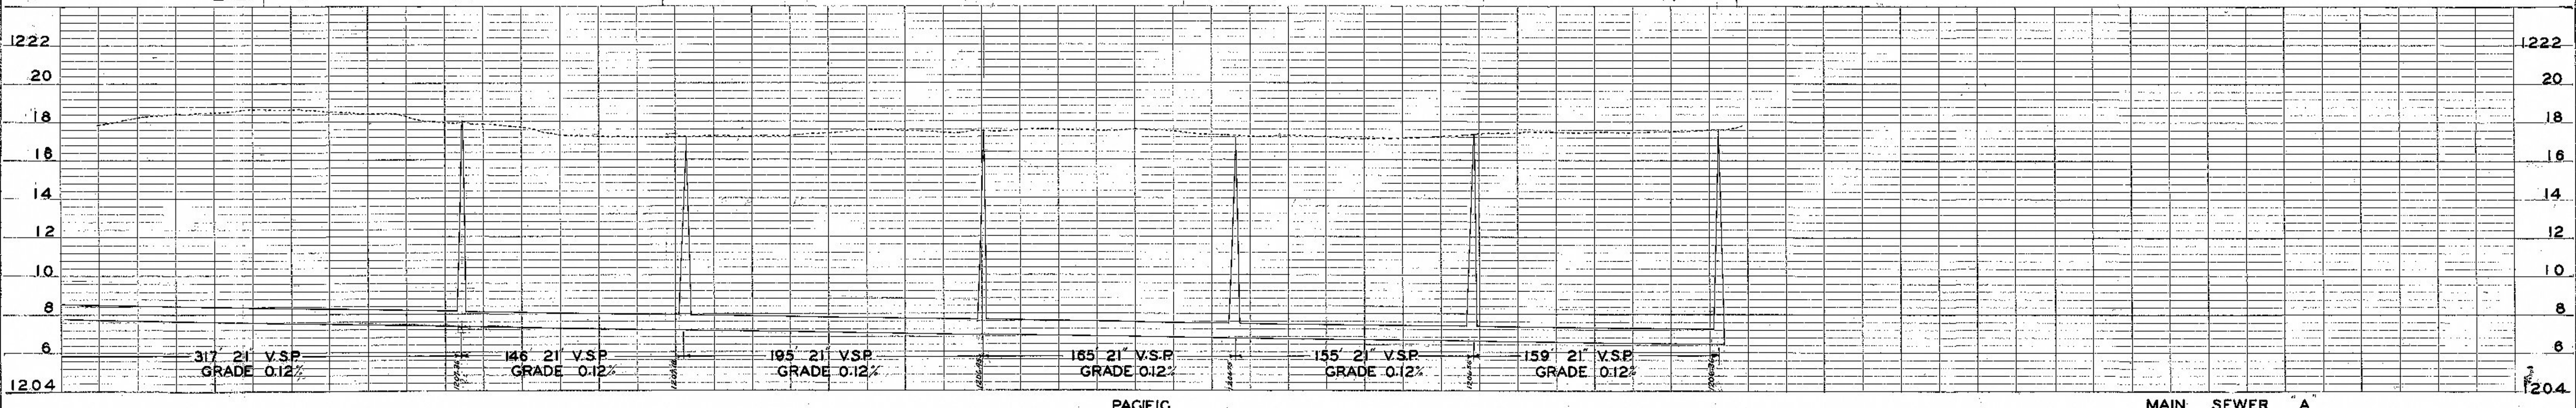
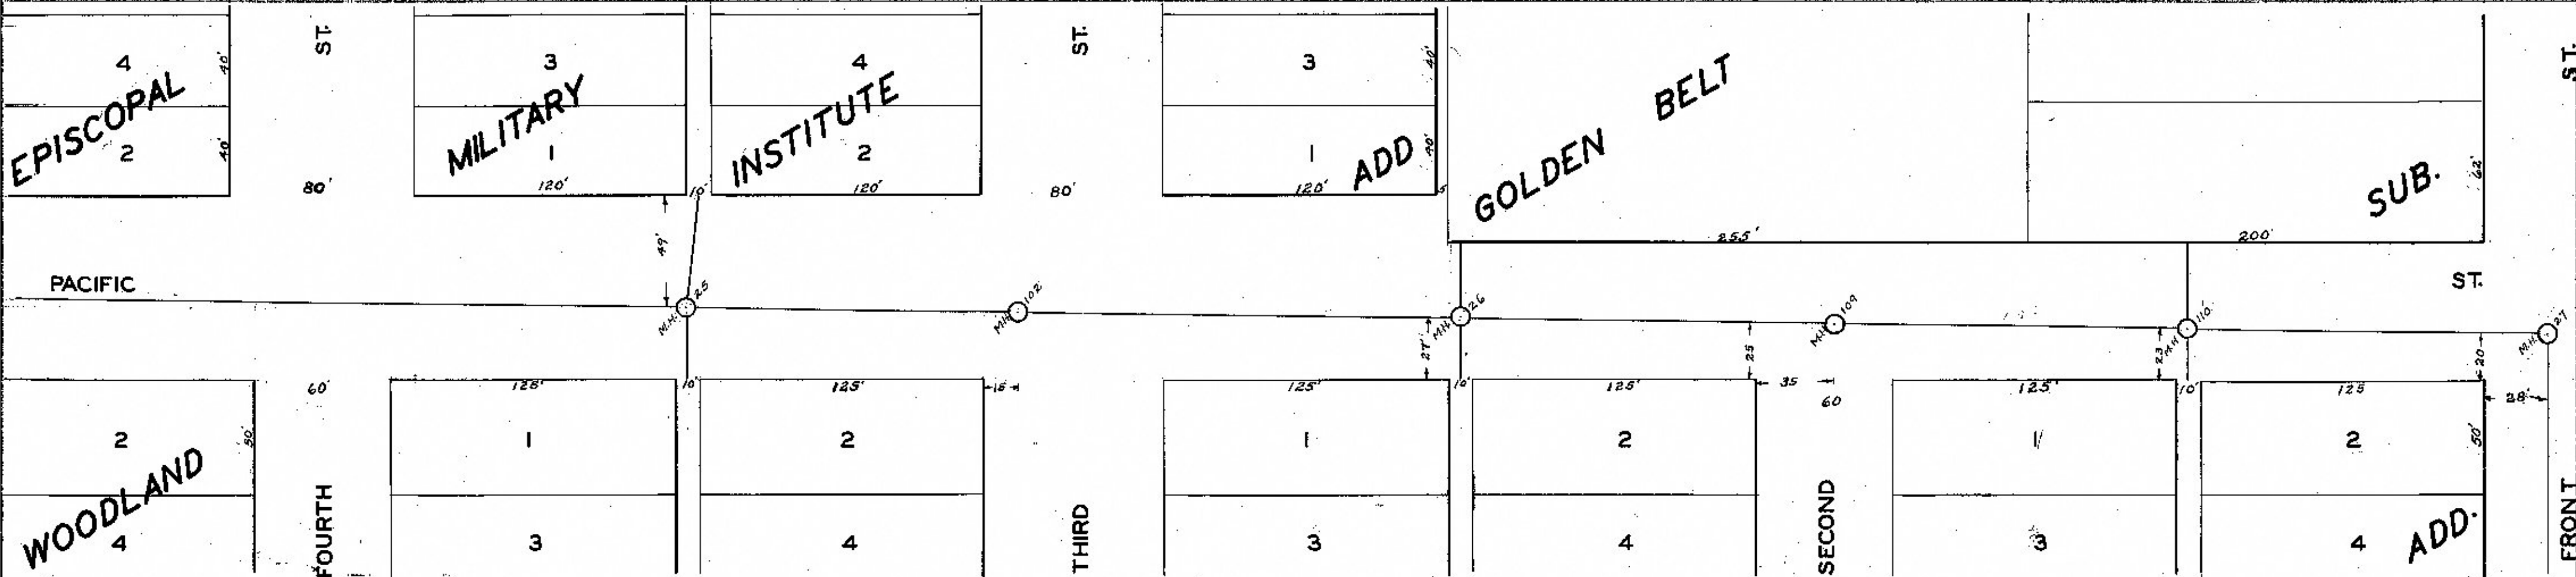
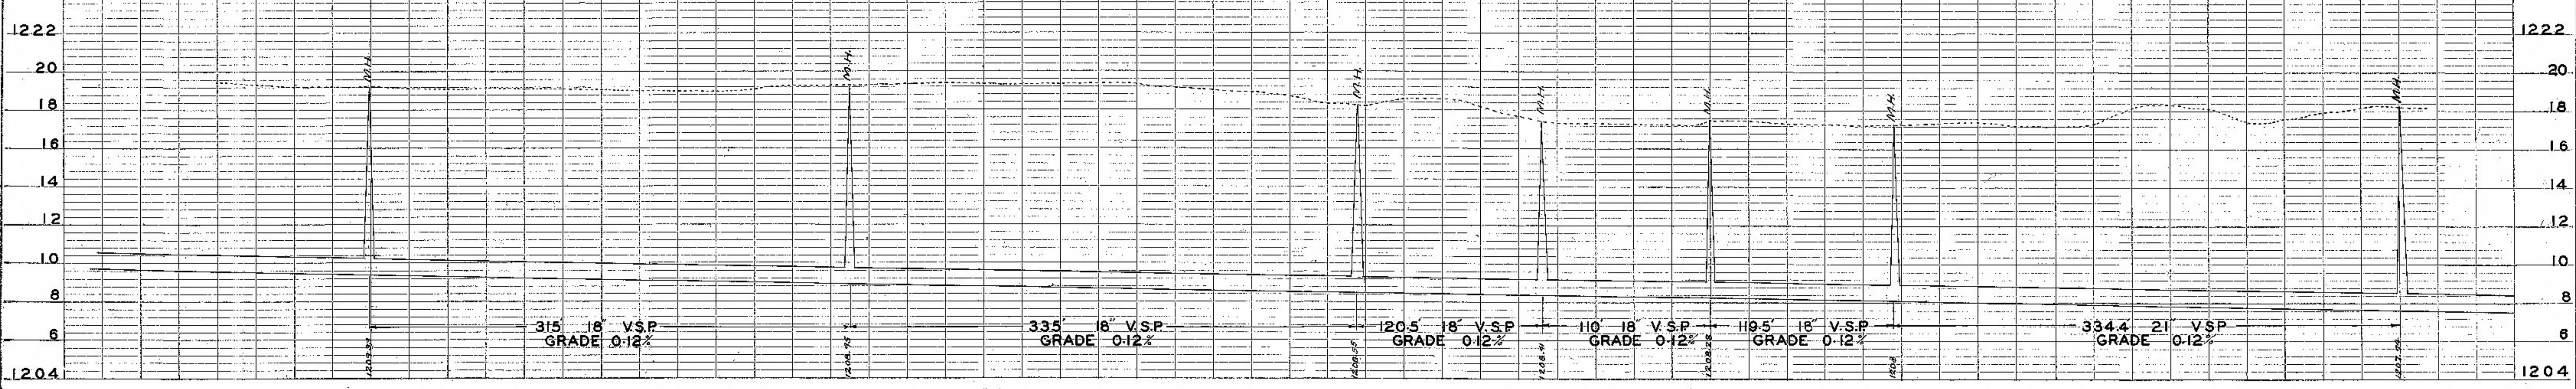
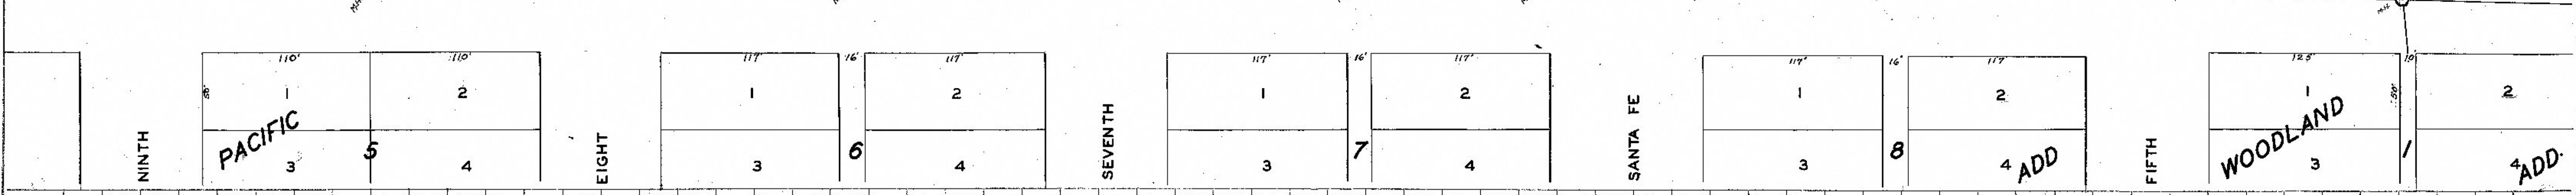


PLAN  
 SURVEYED...  
 PLOTTED...  
 CHECKED...  
 DATE...  
 BY...  
 NO.

PROFILE  
 SURVEYED...  
 PLOTTED...  
 CHECKED...  
 DATE...  
 BY...  
 NO.

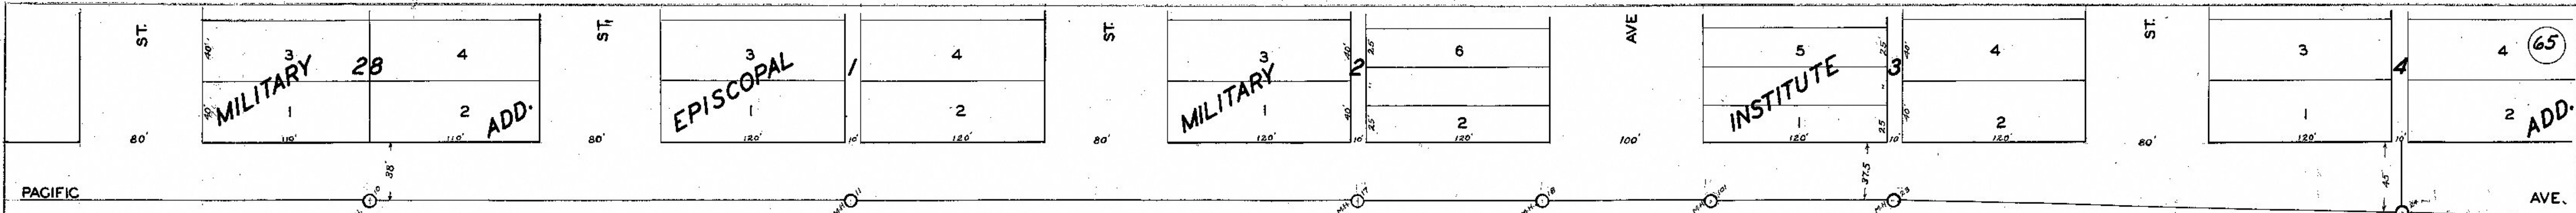

**LEGEND**

SEWER WAS BUILT BY AMERMAN & SNYDER 1918  
 NO WYES-SEWER WAS CONSTRUCTED FOR STORM  
 SEWER-LATER USED AS SANITARY SEWER.

PG. WAKENHUT CITY ENGINEER  
 REVISED 1928  
 R.J. PAULETTE CITY ENGINEER