



PLAN
 SURVEYED
 NOTE BOOK NO. _____
 PLOTTED
 ALIGNMENT CHECKED
 RT. OF WAY CHECKED
 BY
 H.E.B.
 DATE

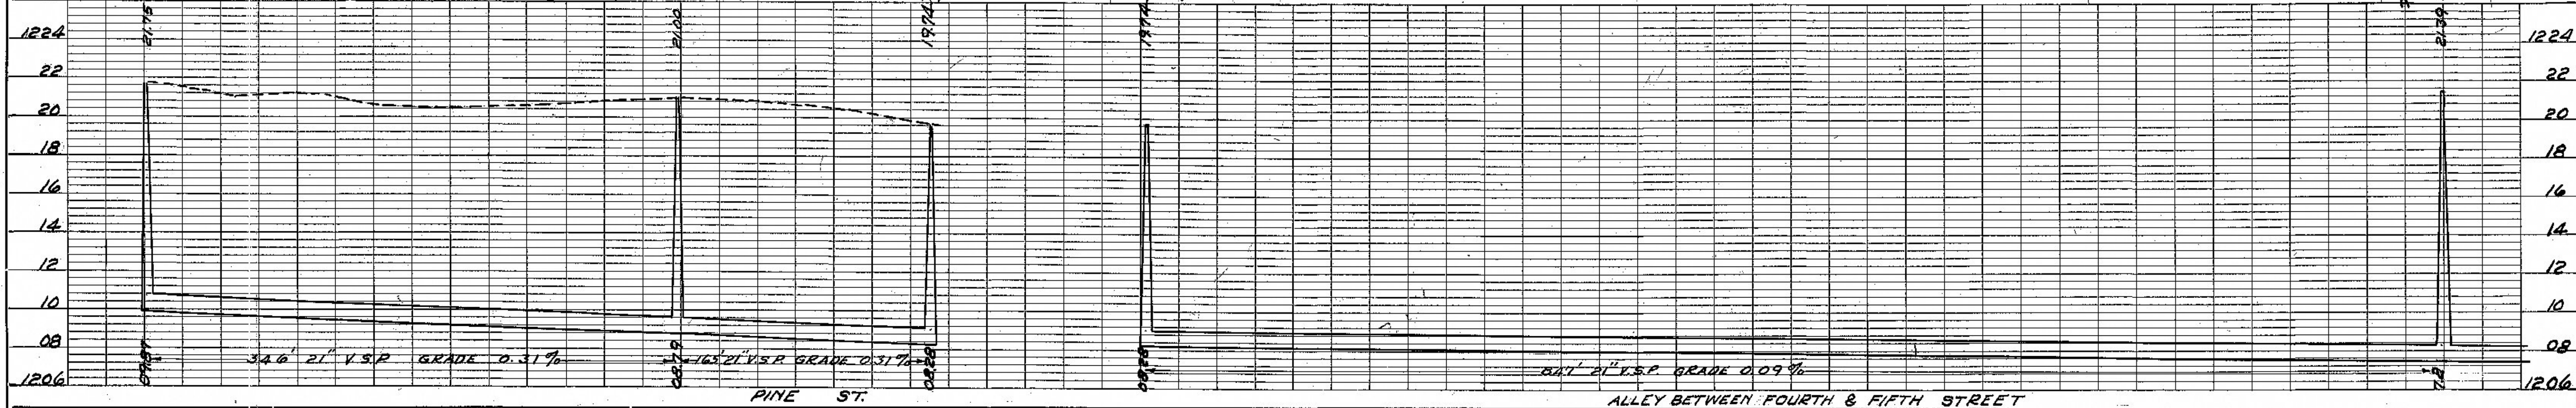

PROFILE
 SURVEYED
 NOTE BOOK NO. _____
 PLOTTED
 GRADES CHECKED
 E.M. NOTED
 STRUCTURE NOTARIS CHRG.
 BY
 H.E.B.
 DATE

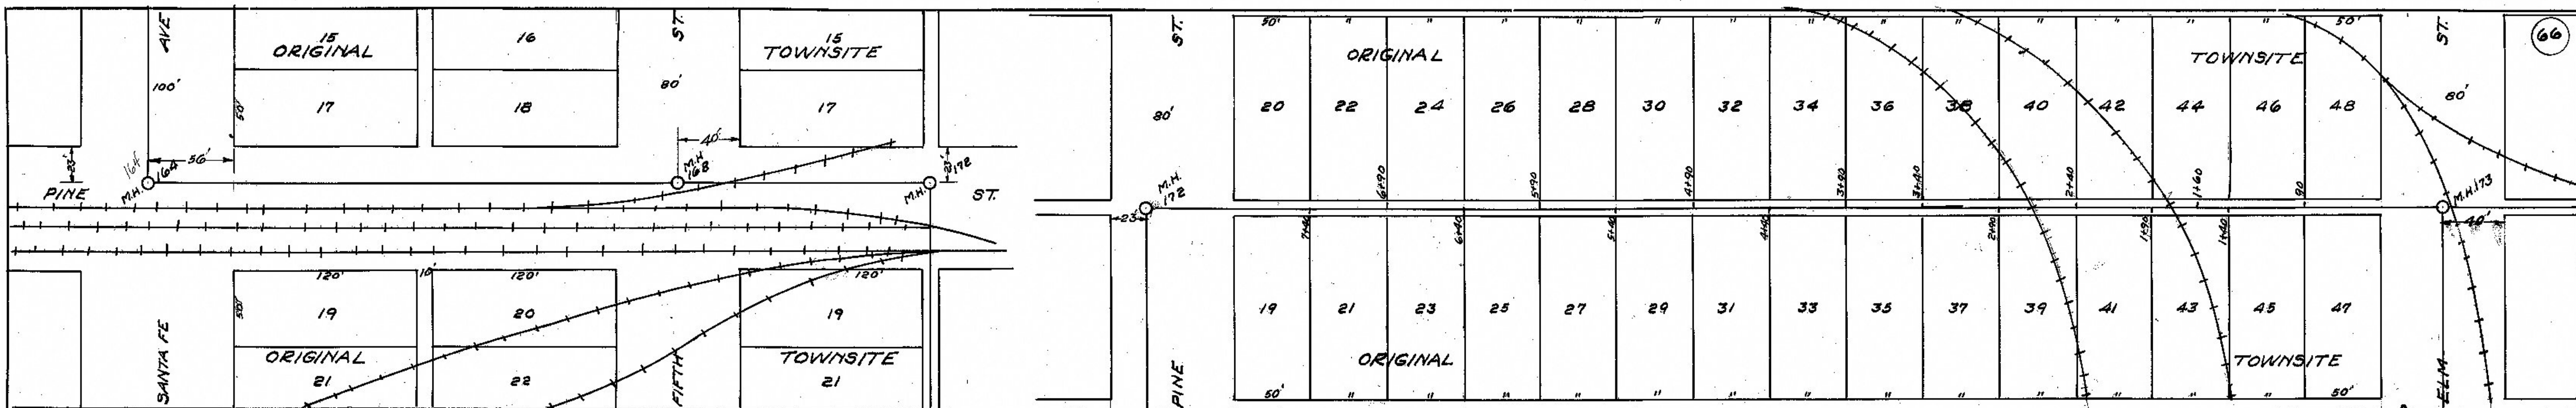