
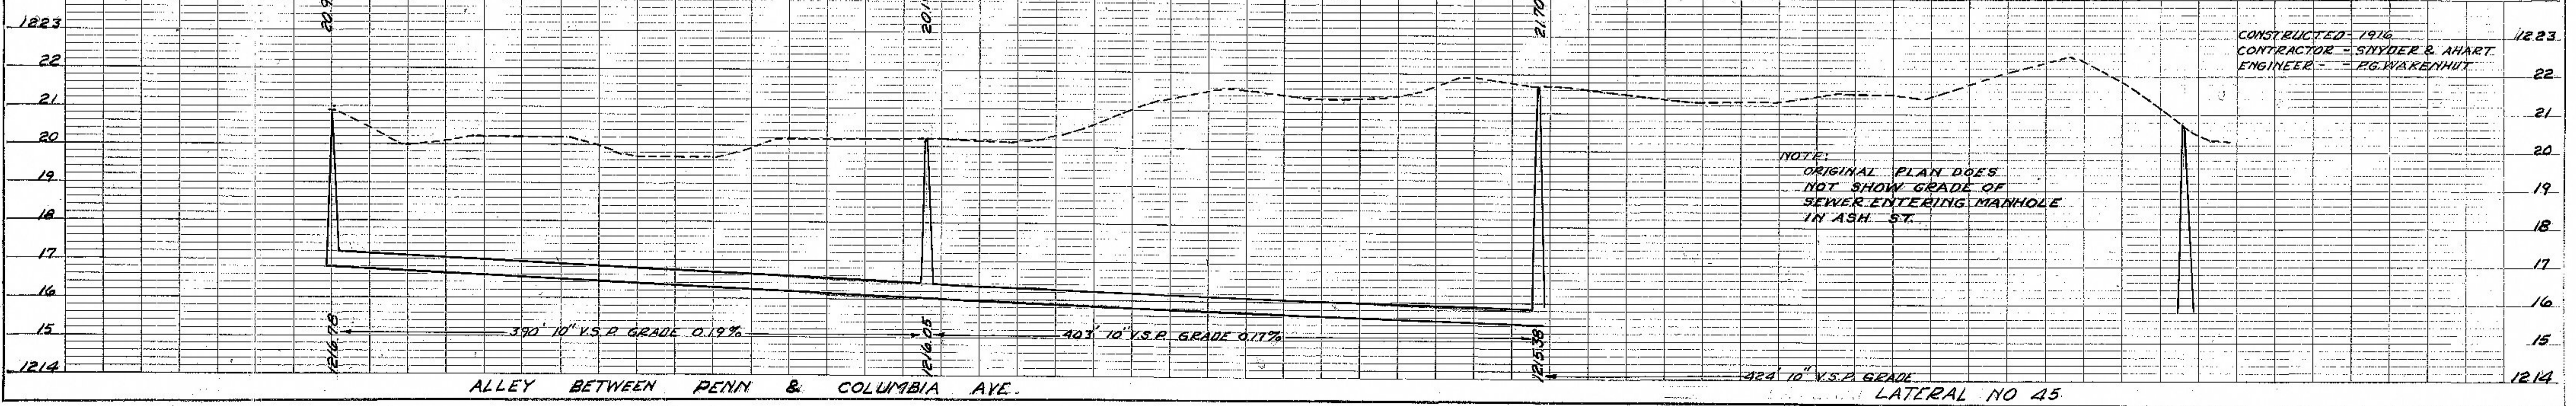
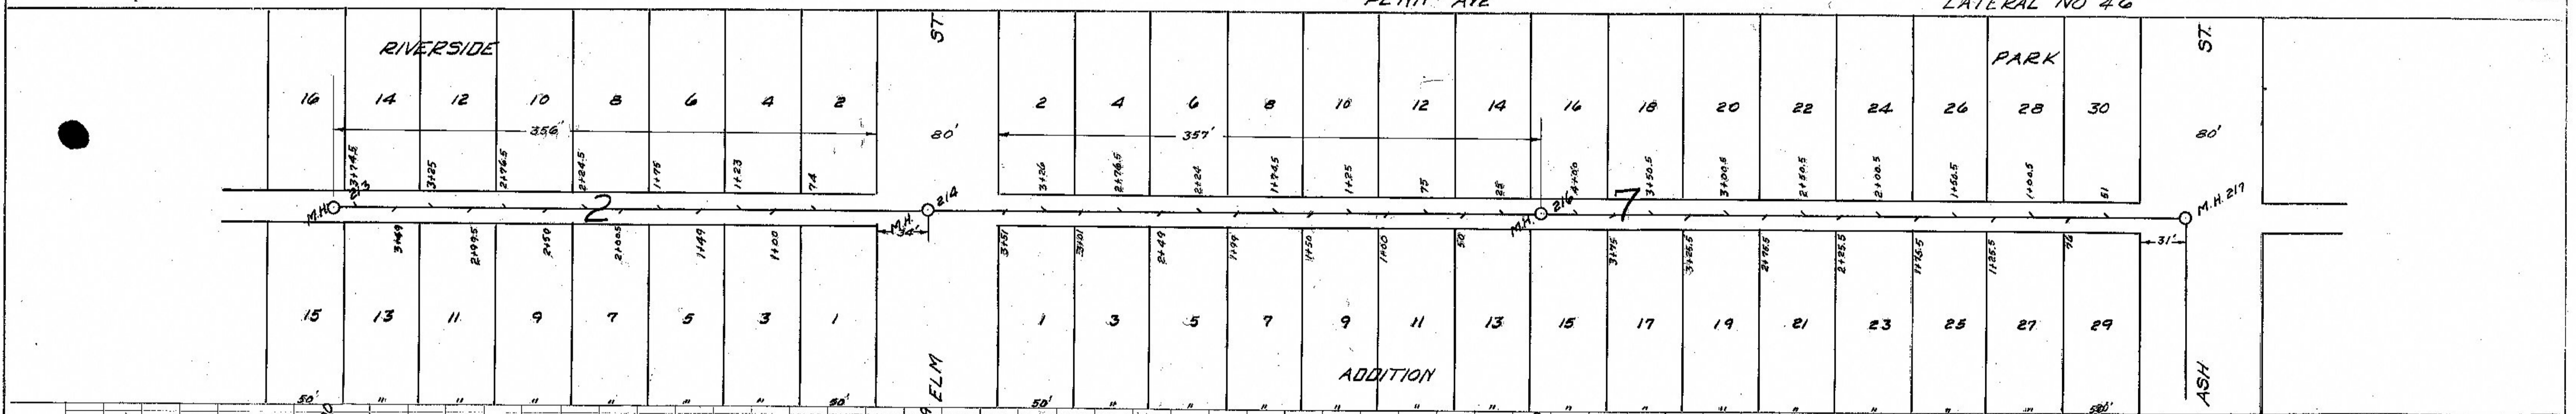
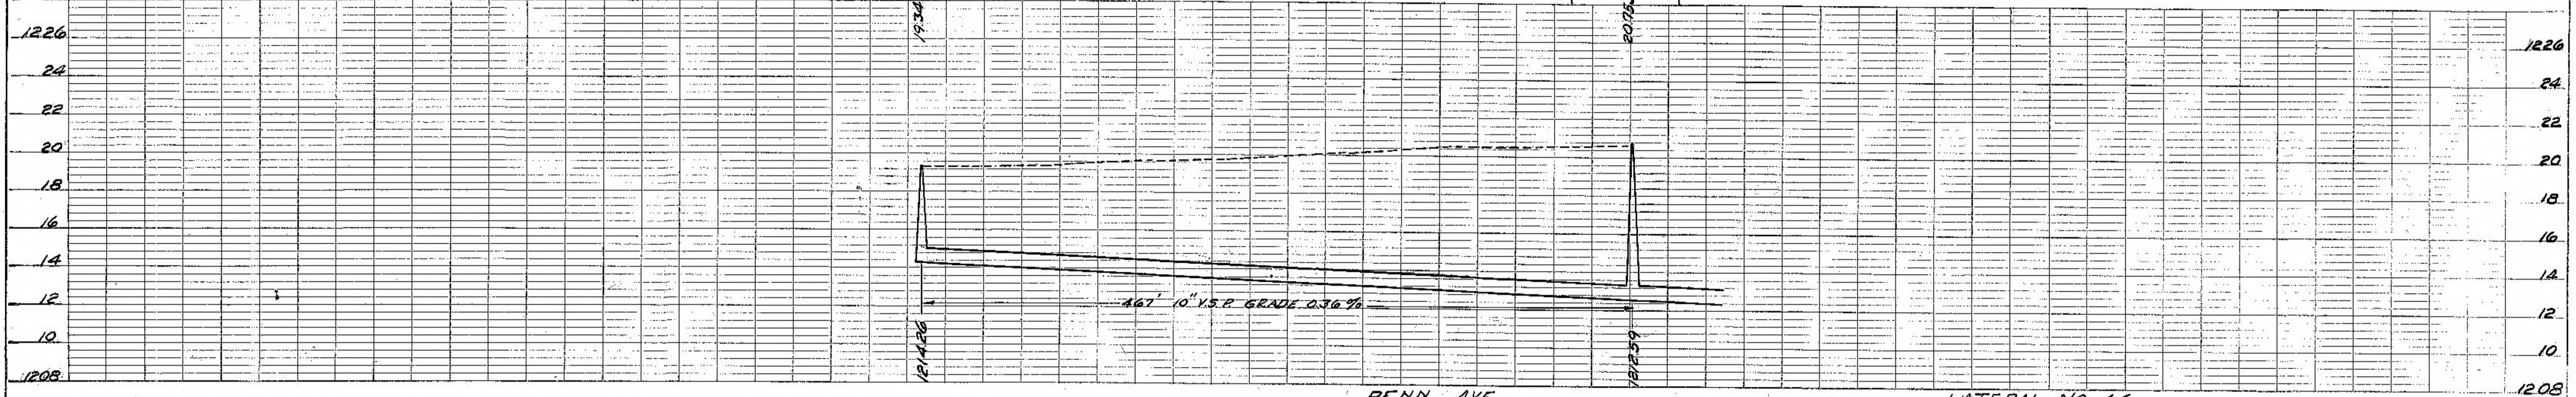


PLAN SURVEYED BY: **HEM**
 PLOTTED BY: **HEM**
 CHECKED BY: **HEM**
 NOTE BOOK NO. _____
 DATE _____

PROFILE SURVEYED BY: **HEM**
 PLOTTED BY: **HEM**
 CHECKED BY: **HEM**
 NOTE BOOK NO. _____
 DATE _____

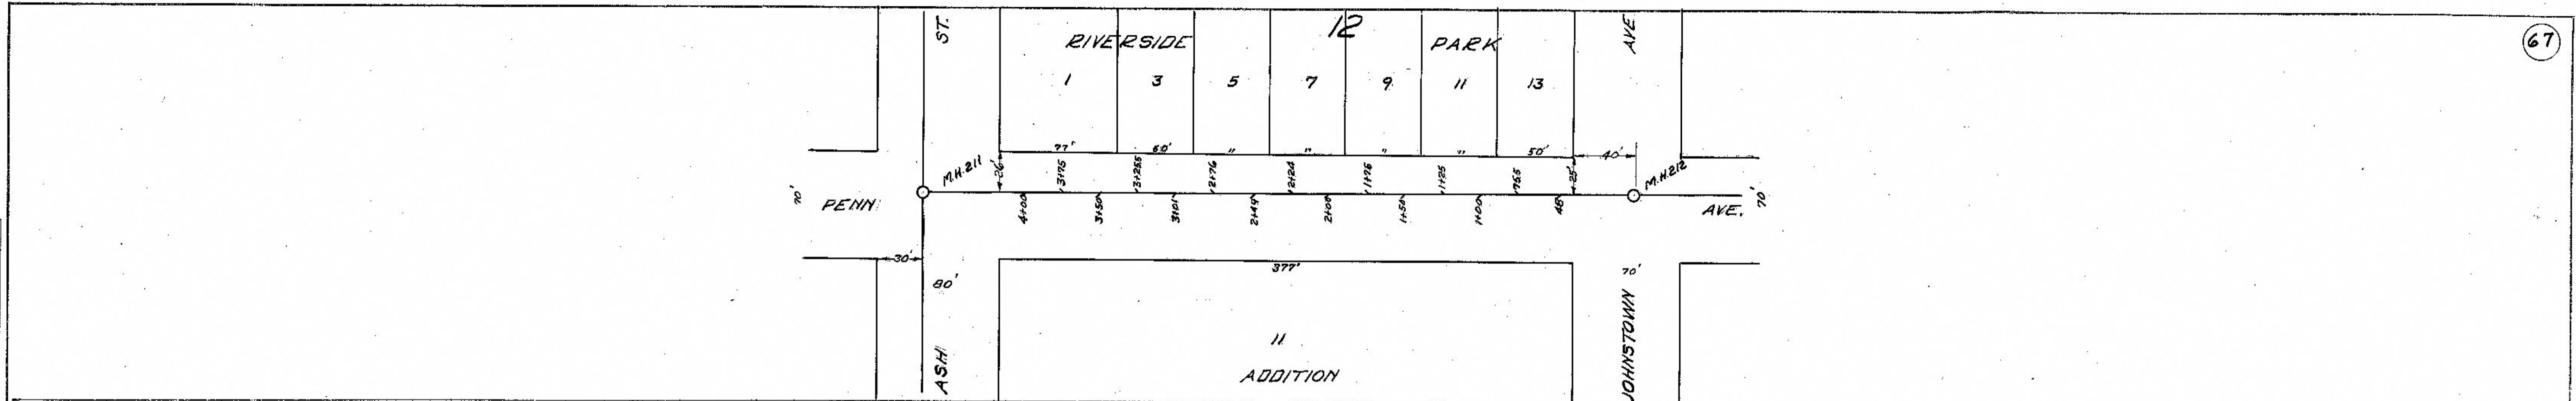

CONSTRUCTED - 1916
 CONTRACTOR - SNYDER & AHART
 ENGINEER - R.G. WARENHUT