


PLAN  
SURVEYED  
PLOTTED  
CORRECTED  
BY  
NEW  
A.E.B.



PROFILE  
SURVEYED  
PLOTTED  
CORRECTED  
BY  
NEW  
A.E.B.

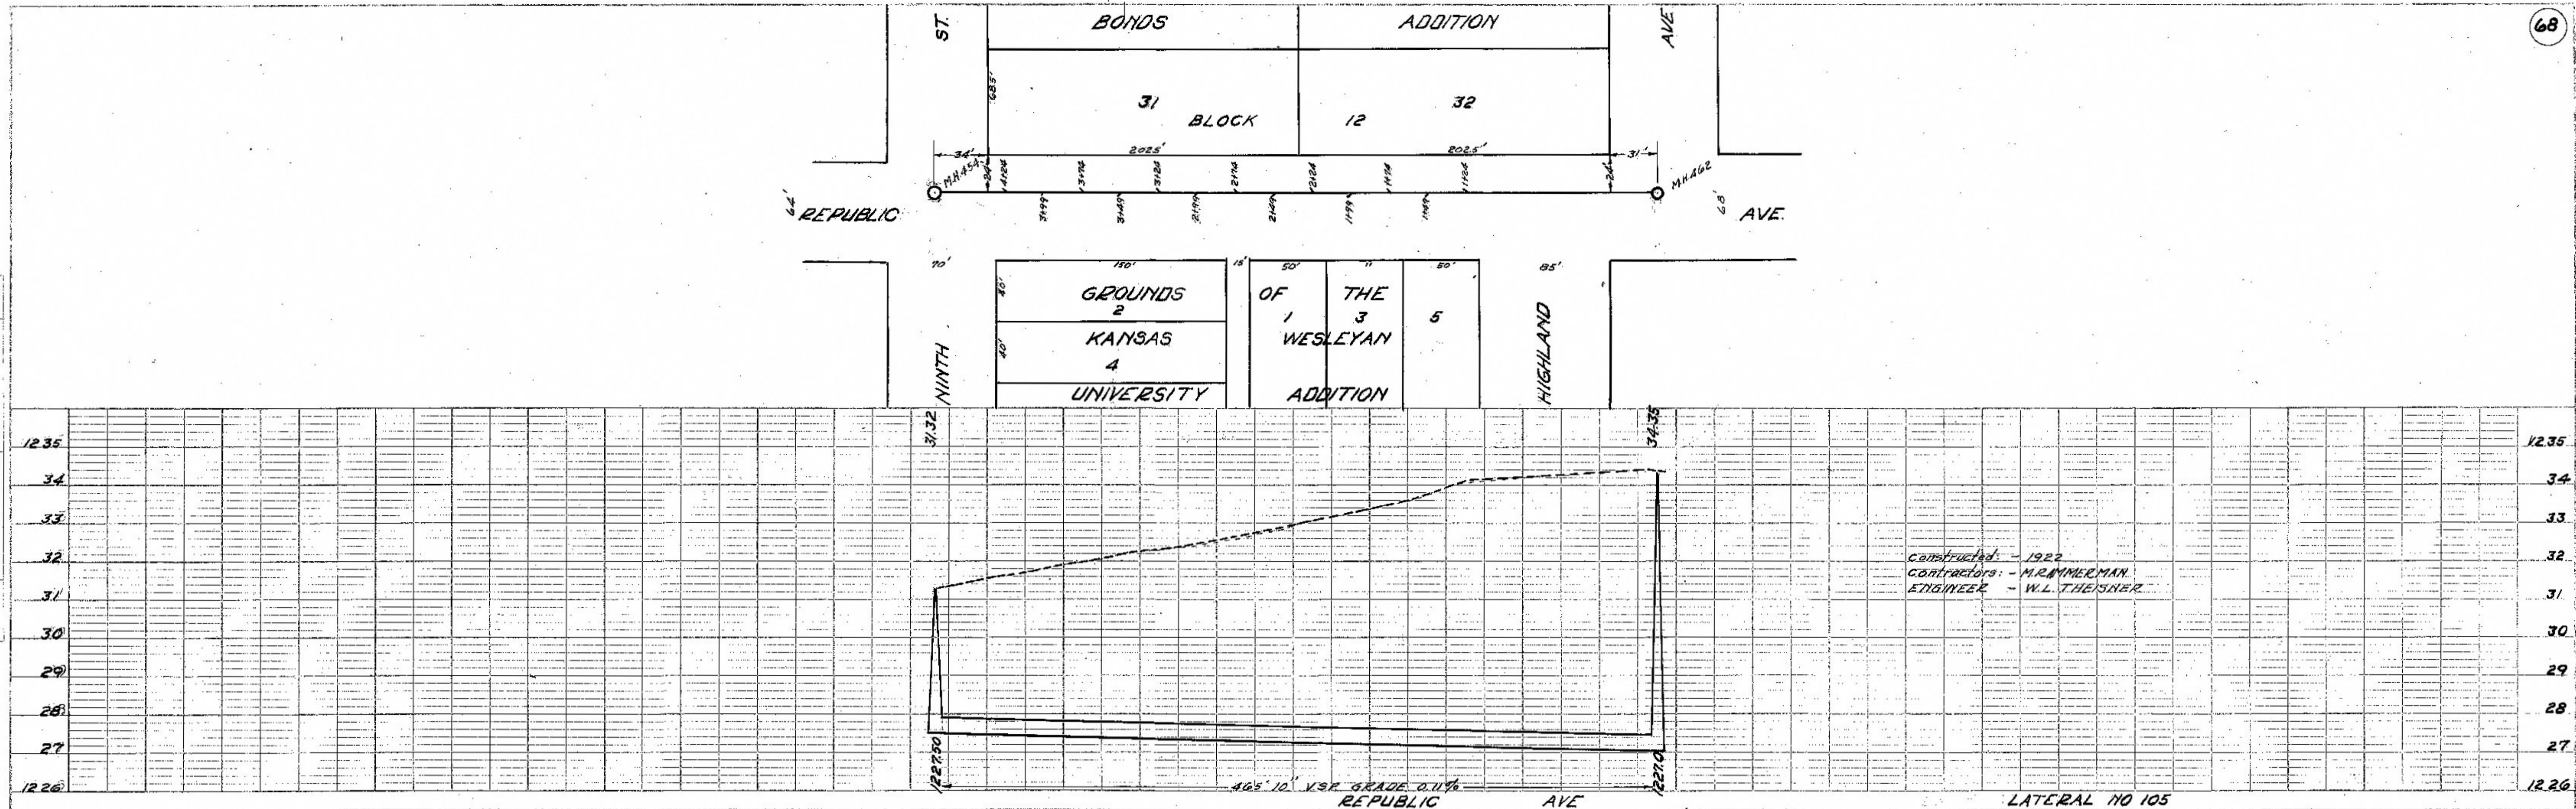