

DATE
BY
HEB
HEB
SURVEYED
PLOTTED
ALIGNED CHECKED
NOTE BOOK
NO.

DATE
BY
HEB
HEB
SURVEYED
PLOTTED
GRADES CHECKED
STRUCTURE NOTATION CHD
No.

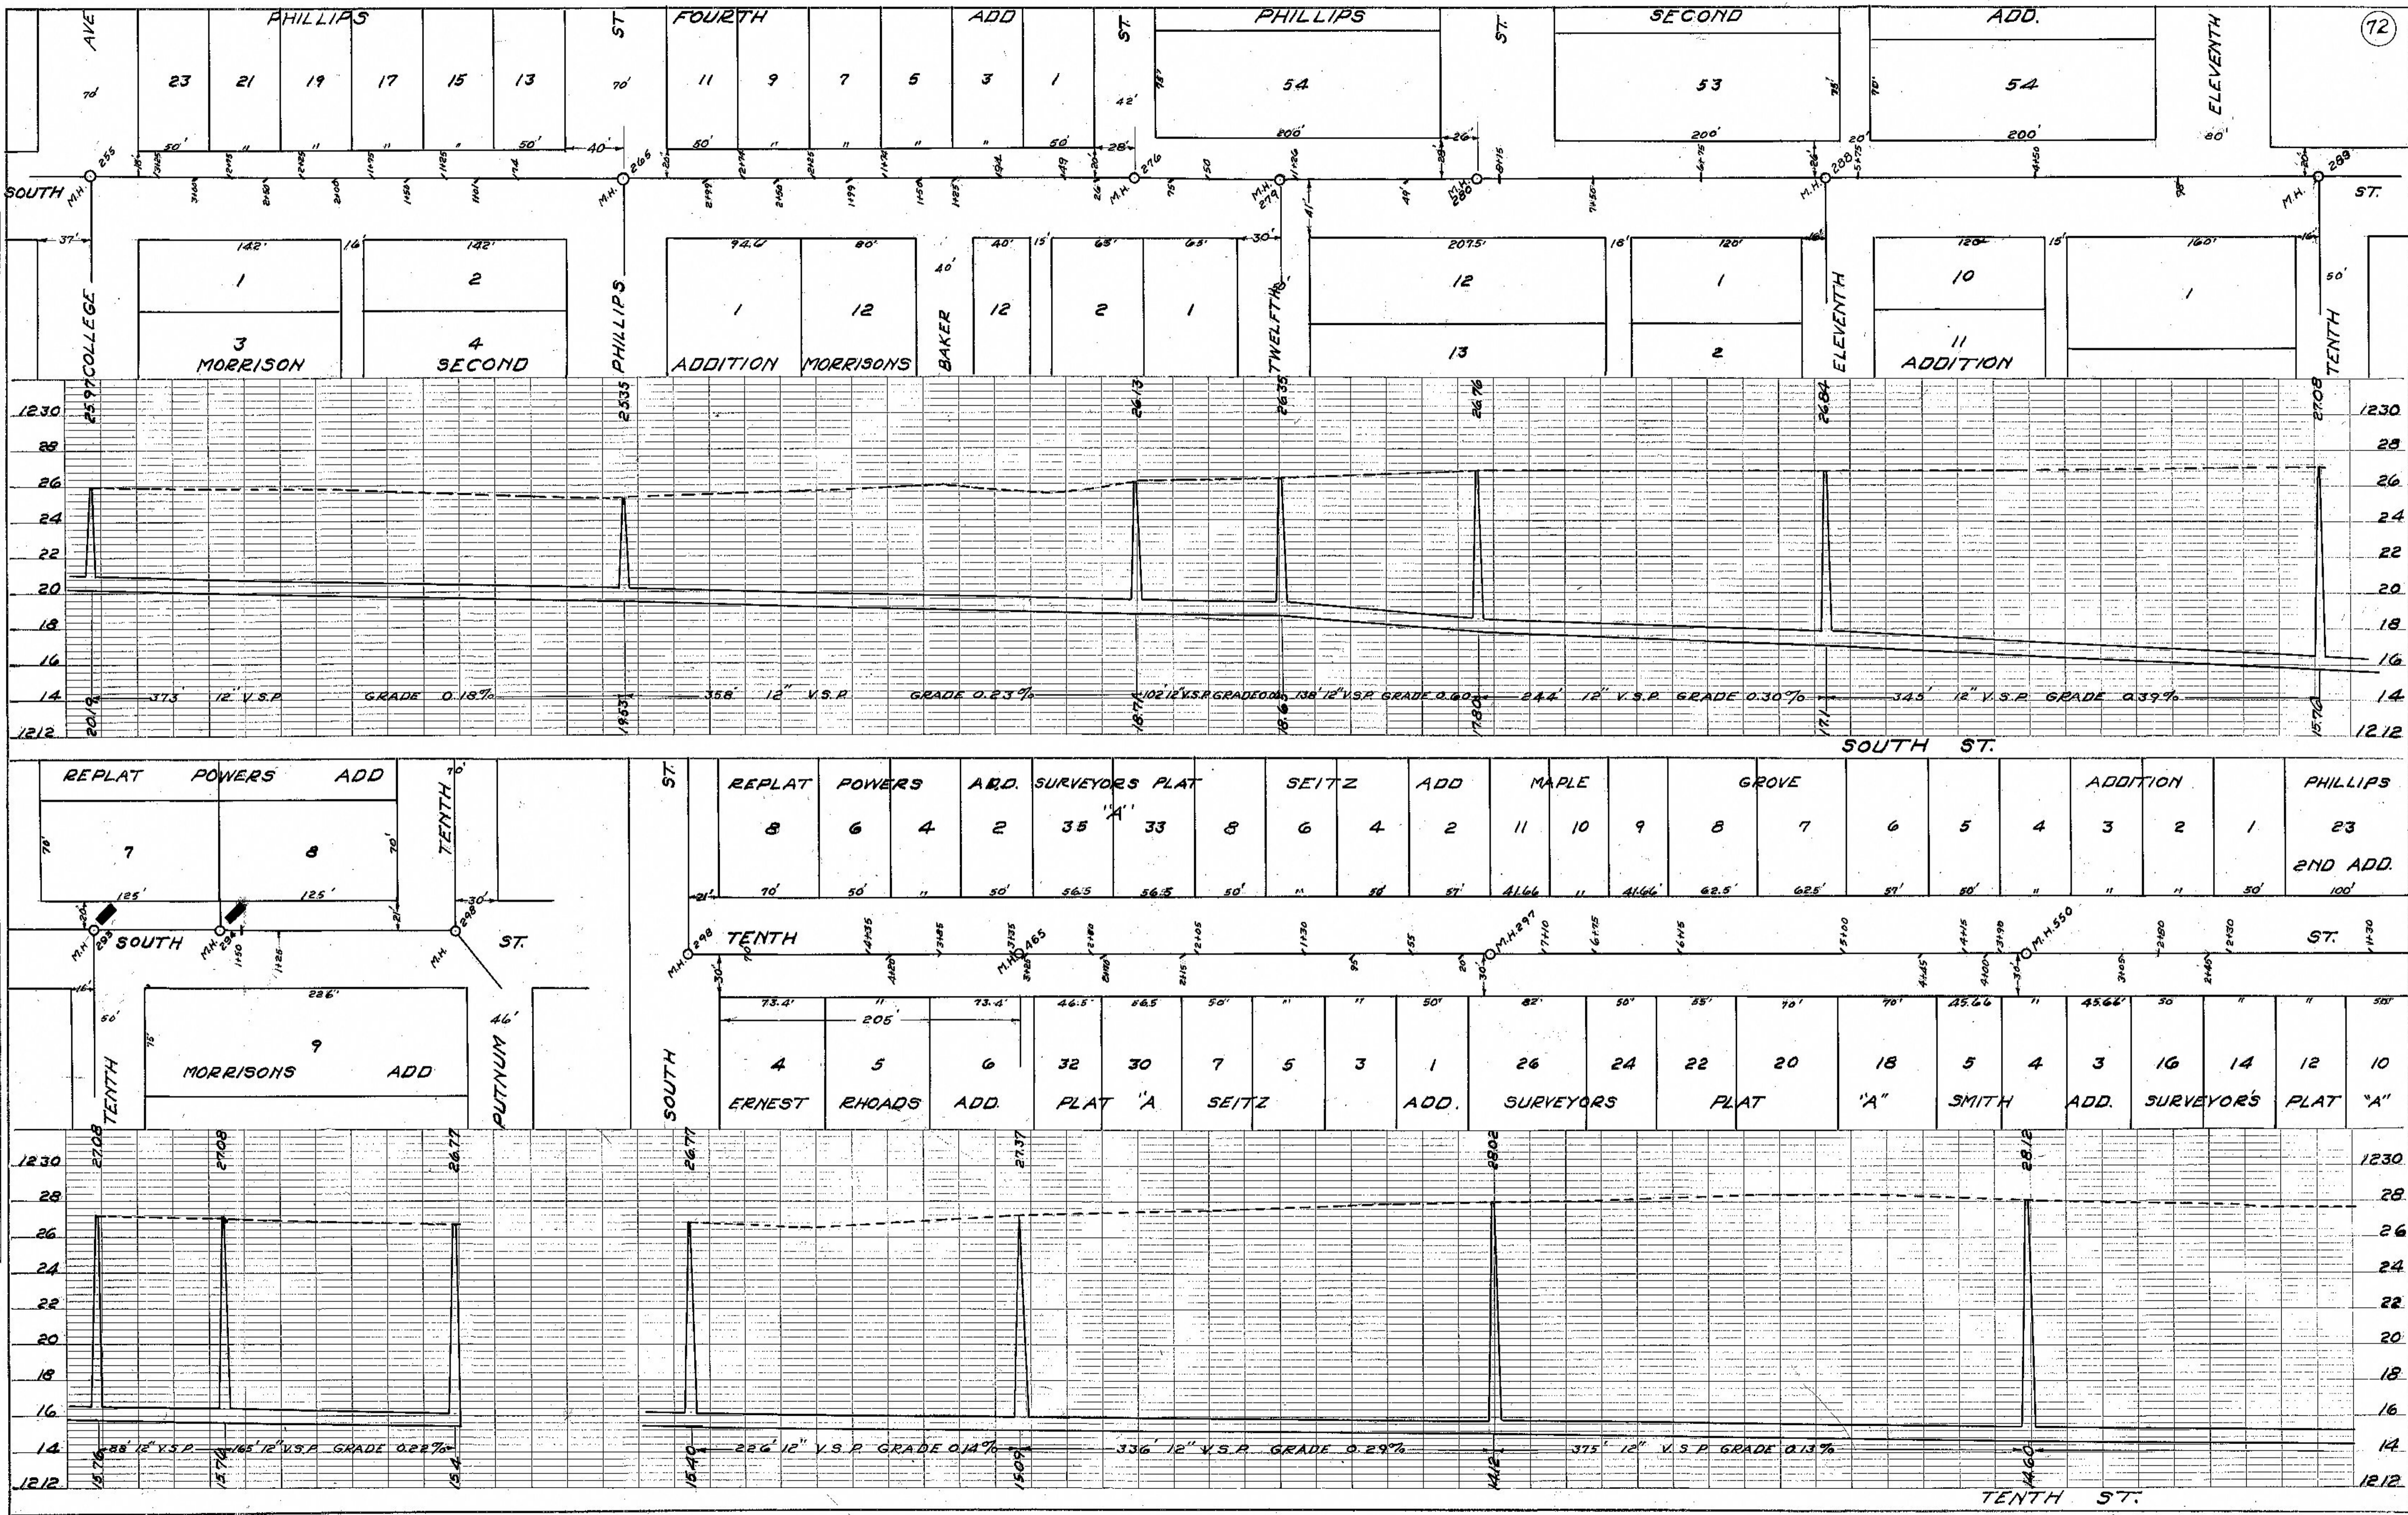


PLATE 2-PLAN-PROFILE D. P. R. STANDARD

TENTH ST.
MAIN SEWER "16"