
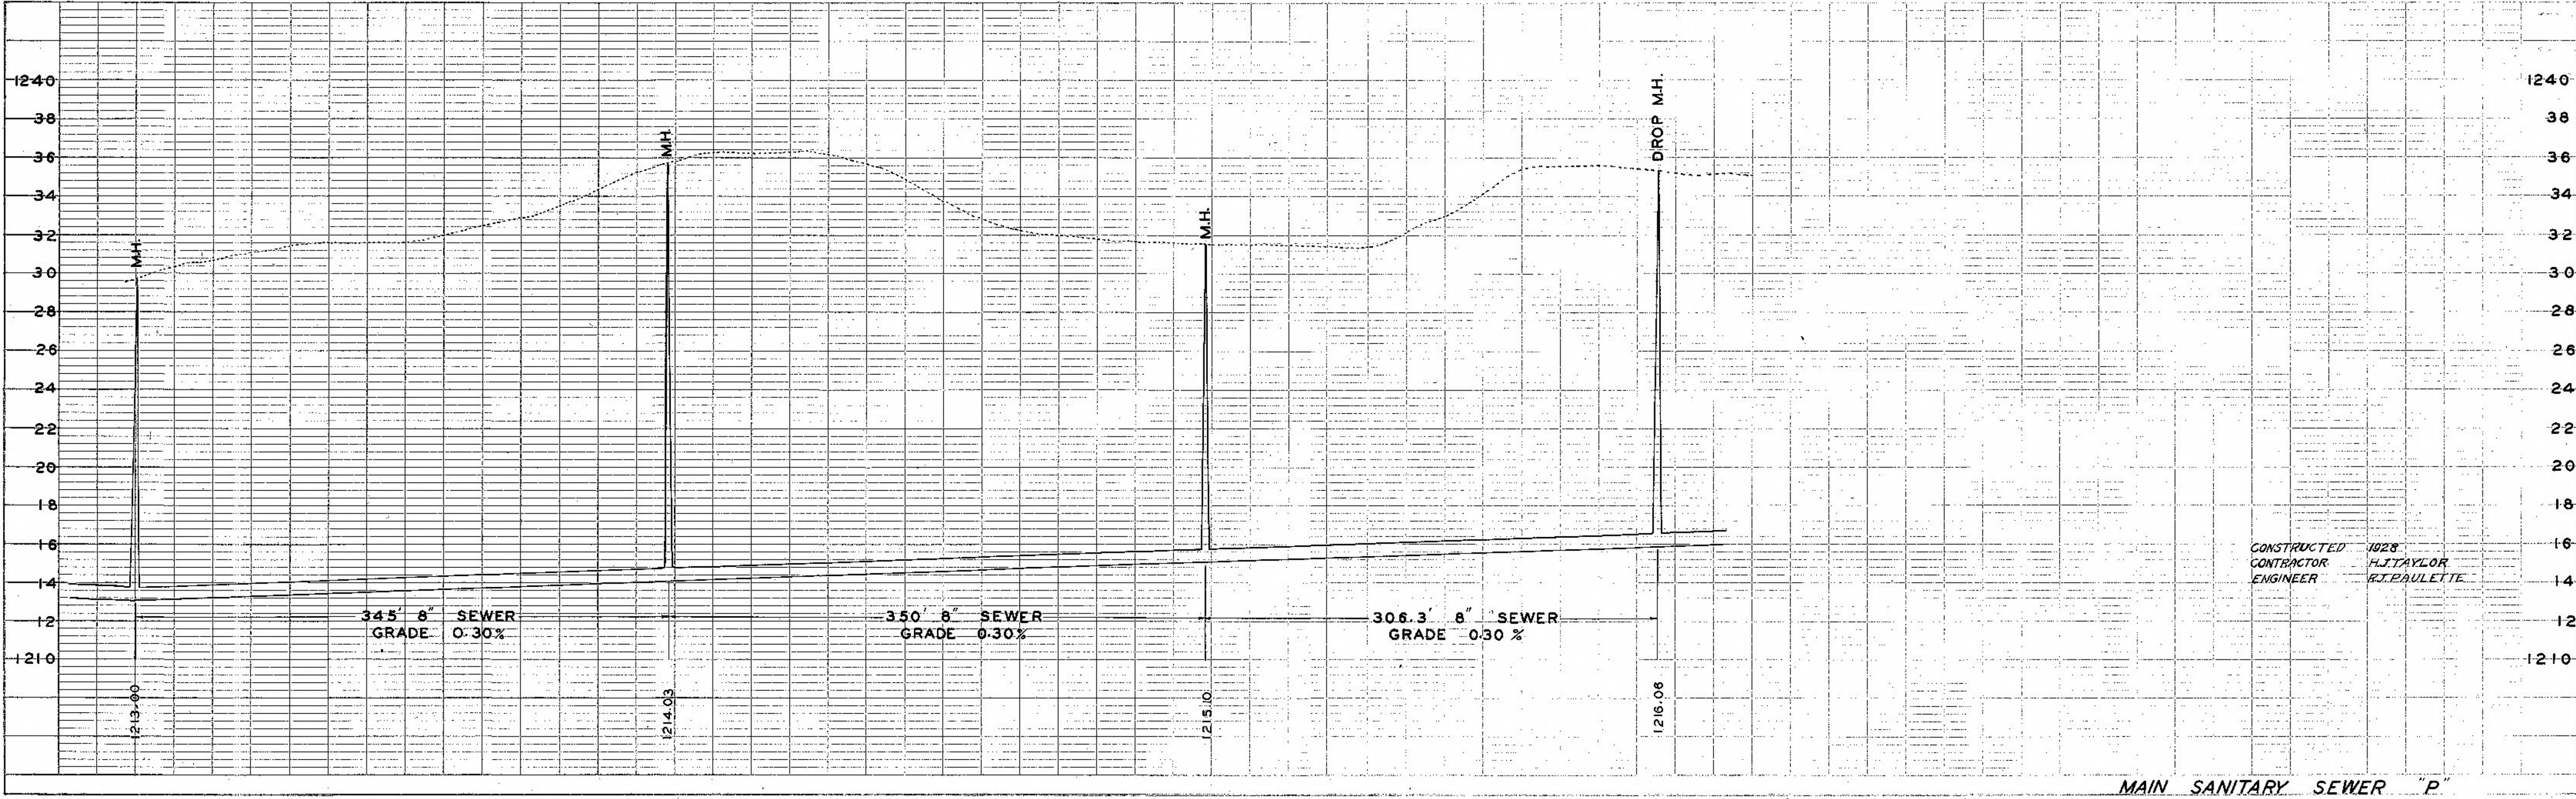


PLAN SURVEYED BY DATE
 NOTE BOOK PLOTTED BY
 GRADES CHECKED BY
 STRUCTURE NOTATION CHECKED BY

PROFILE SURVEYED BY DATE
 NOTE BOOK PLOTTED BY
 GRADES CHECKED BY
 STRUCTURE NOTATION CHECKED BY

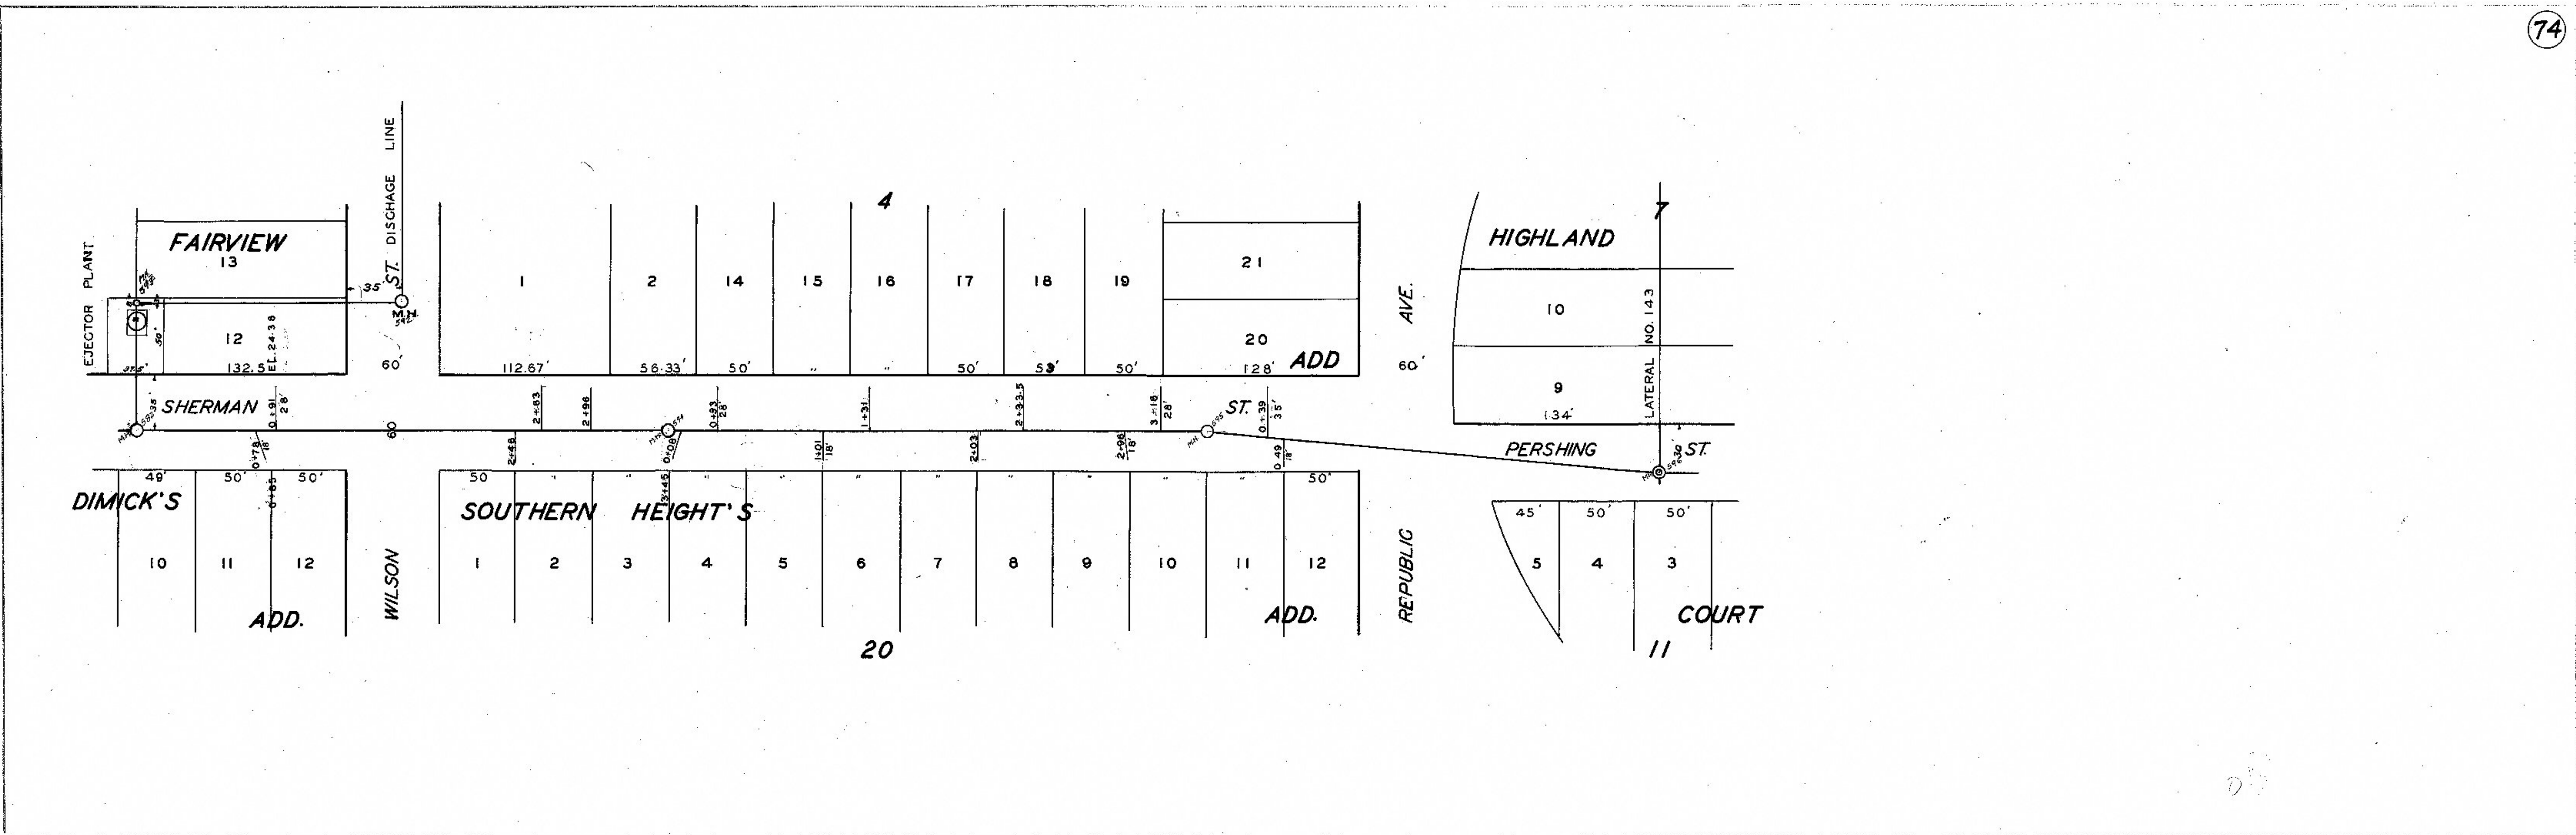

CONSTRUCTED 1928
 CONTRACTOR H. TAYLOR
 ENGINEER R. J. PAULETTE