



PLAN
 DESIGNED: _____ DATE: _____
 NOTE BOOK: PLOTTED: _____
 ALIGNMENT CHECKED: _____
 RT. OF WAY CHECKED: _____
 NO. _____

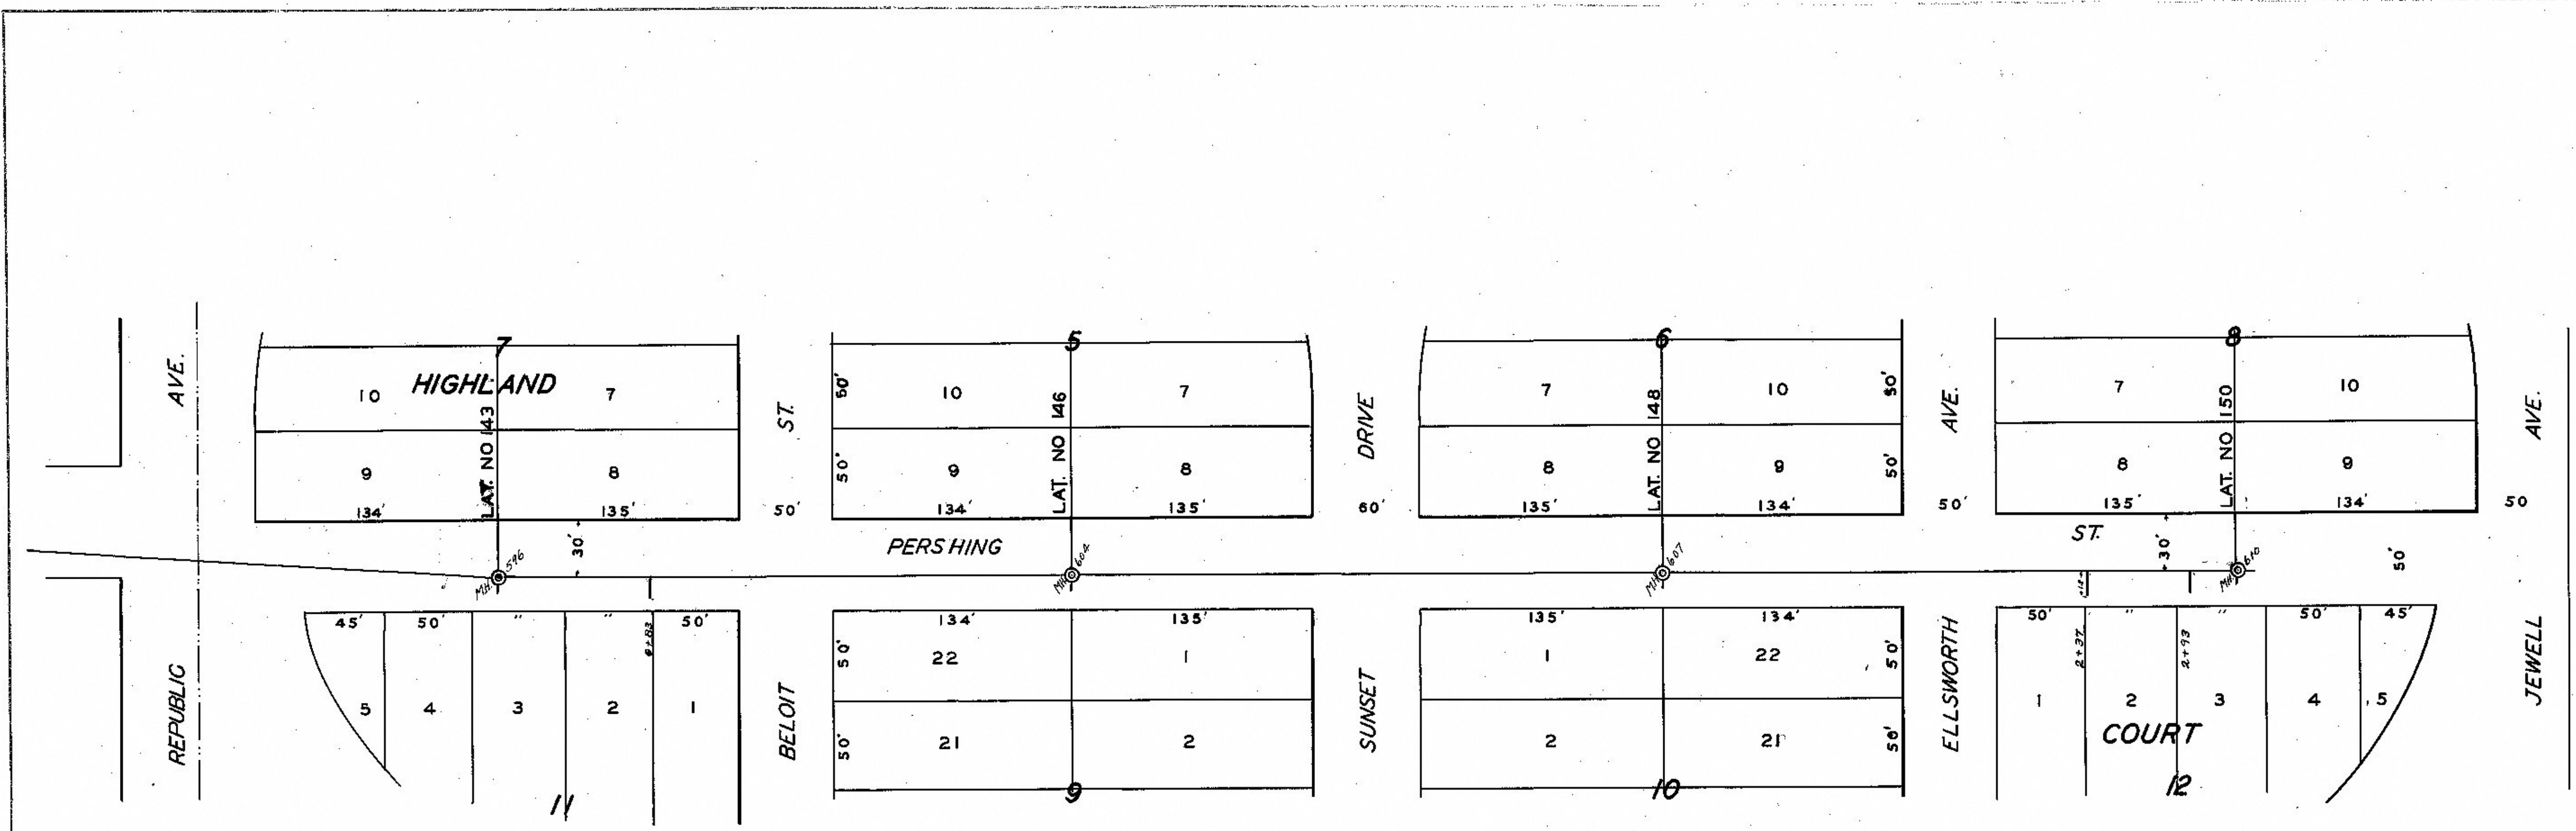

BM. "M" ON HYD. BELOIT
 HIGHLAND CIRCLE
 ELEV. 1235.90

PROFILE
 DESIGNED: _____ DATE: _____
 NOTE BOOK: PLOTTED: _____
 GRADES CHECKED: _____
 B.M. NOTES: _____
 NO. 35

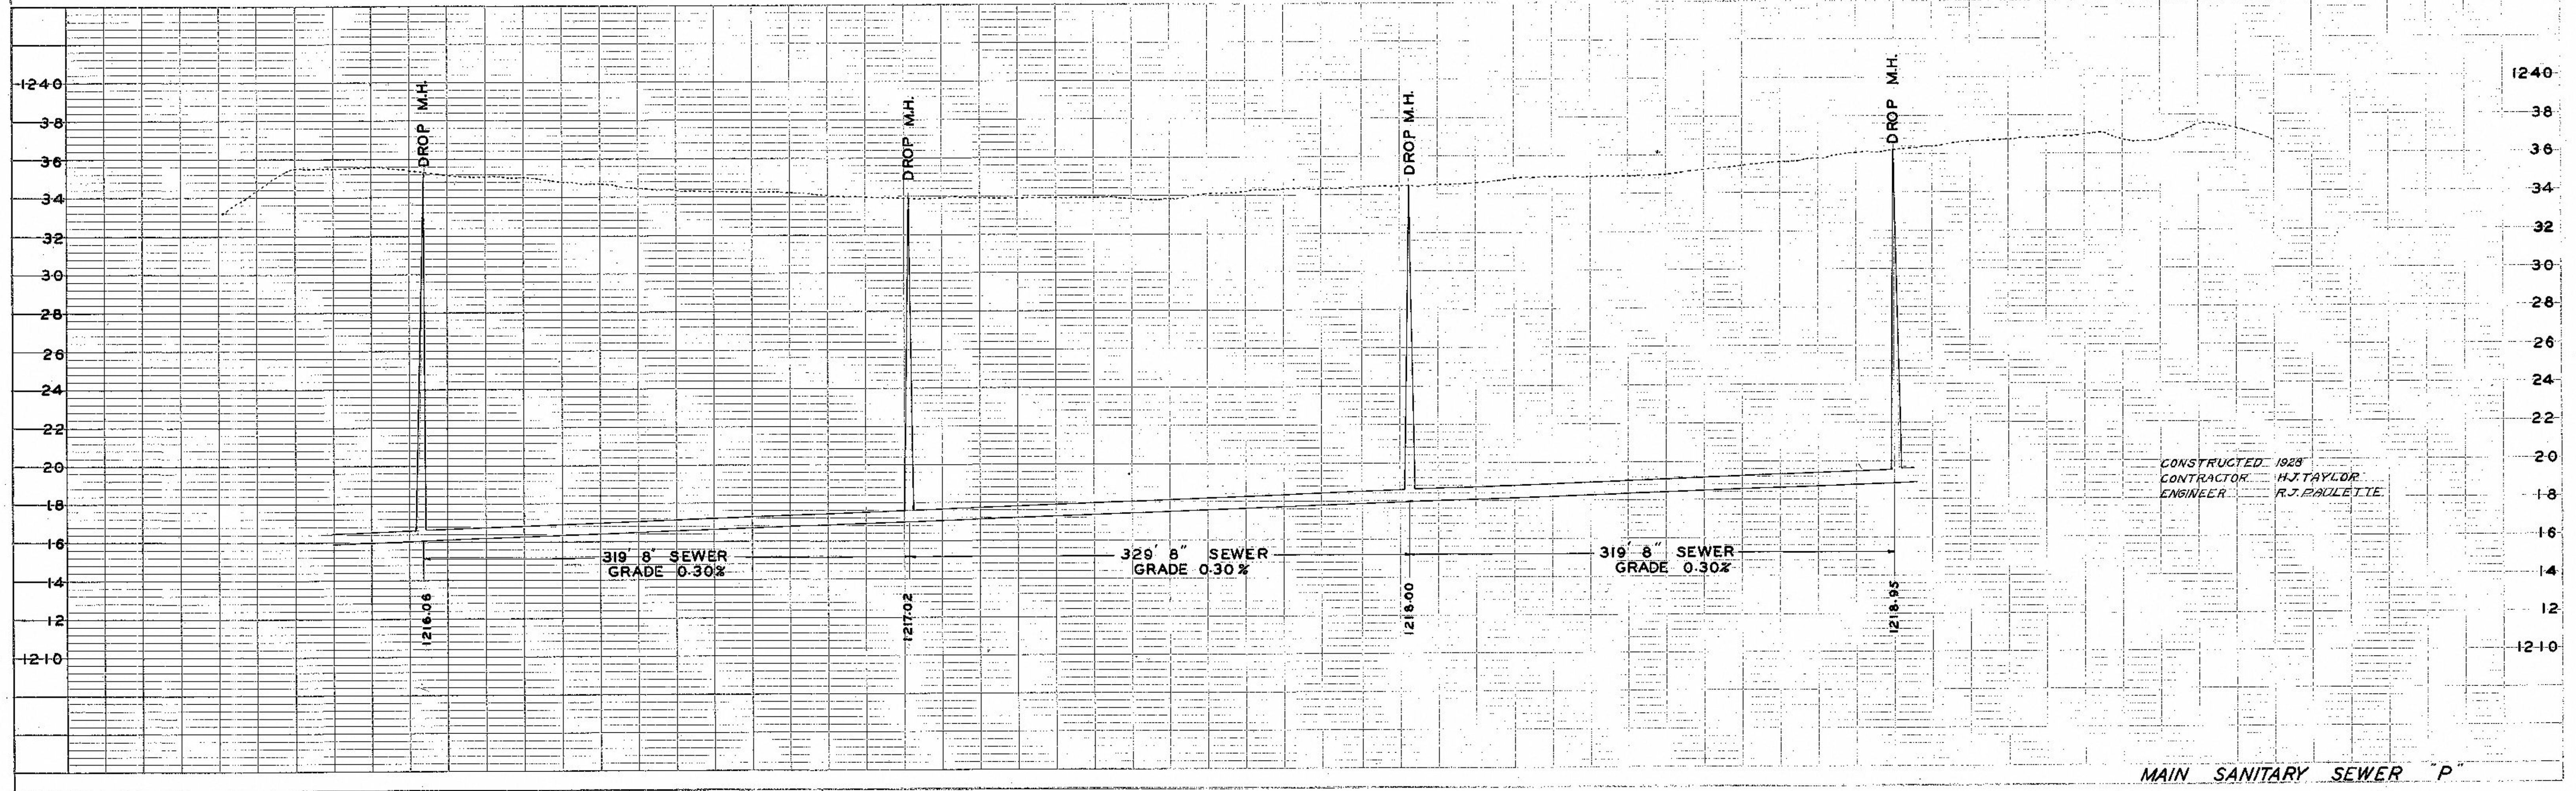

CONSTRUCTED 1928
 CONTRACTOR H.J. TAYLOR
 ENGINEER R.J. PAULETTE

MAIN SANITARY SEWER "P"