
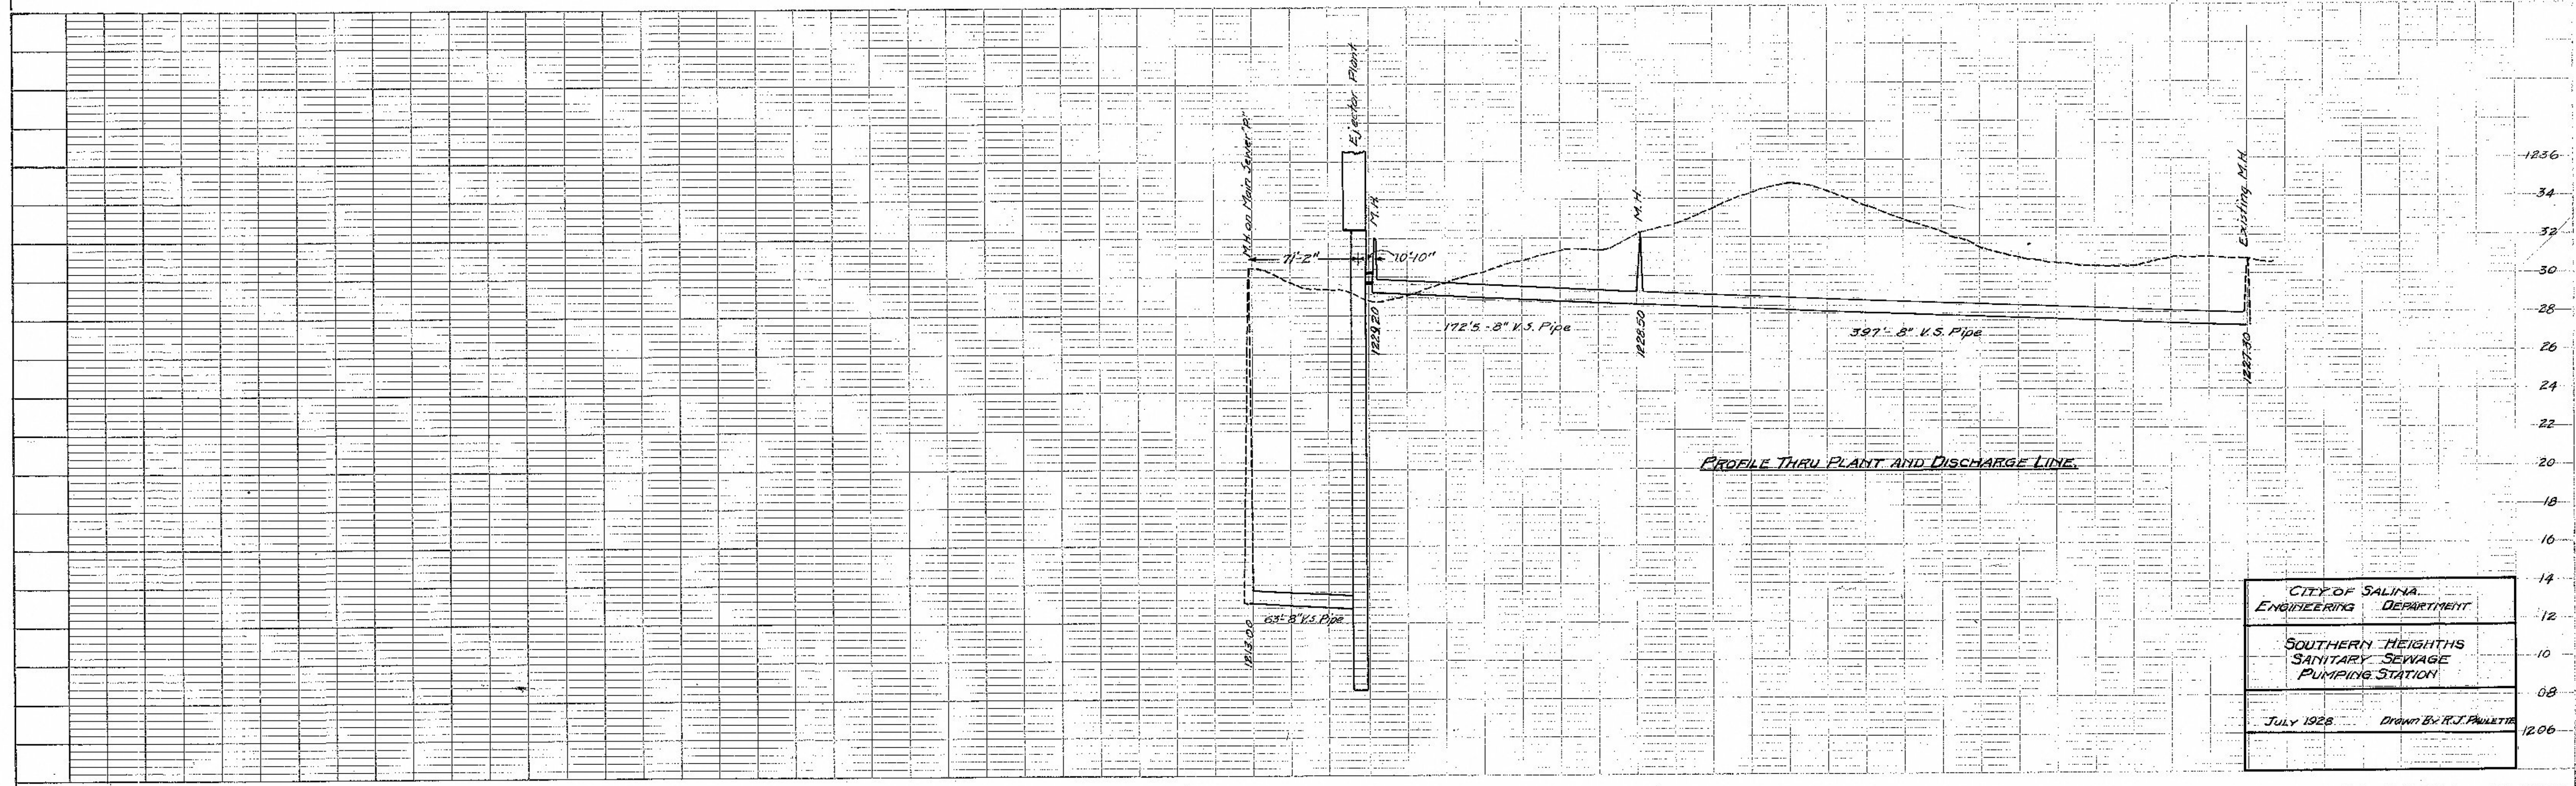


PLAN	SUBMITTED	DATE
NOTE BOOK	PLOTTED	
	ALIGNMENT CHECKED	
	RT. OF WAY CHECKED	
NO.		

B.M. 1232.89
12' on Hydrant, S. of Franklin

PROFILE	SUBMITTED	DATE
NOTE BOOK	PLOTTED	6-27-28
	GRADE CHECKED	
	VERT. CURVATURE CHECKED	
NO.		35

Frank
Paquette

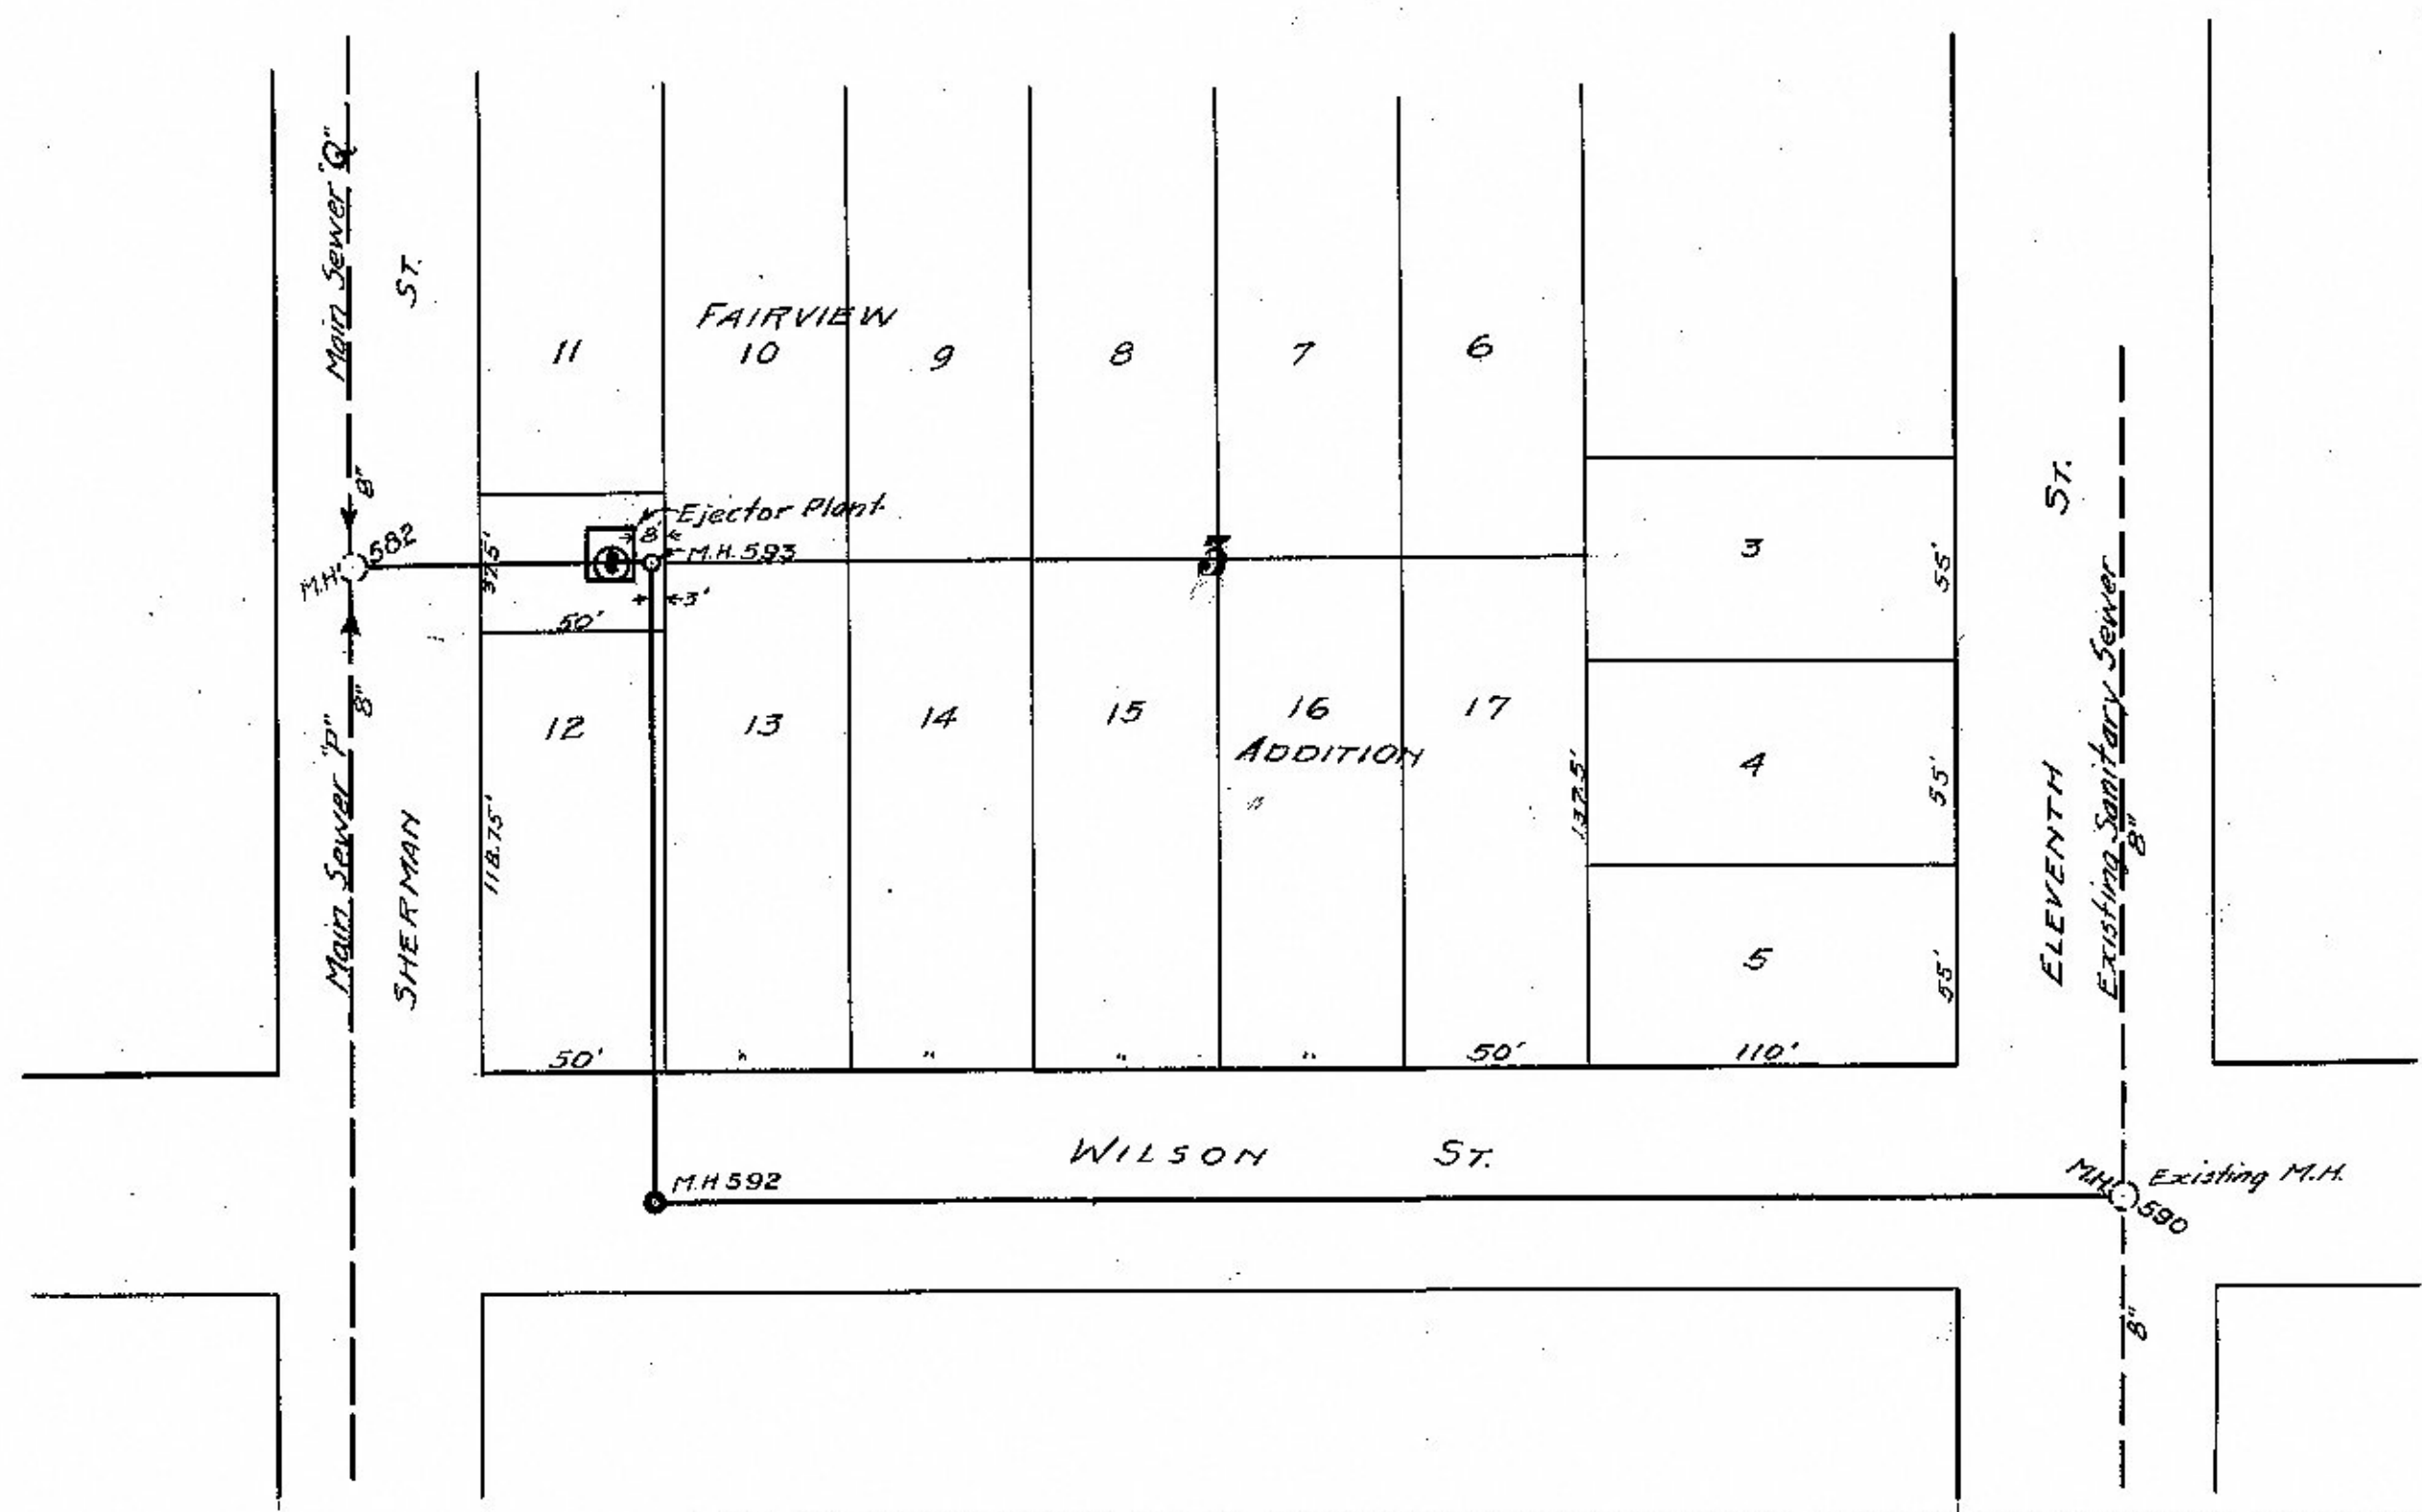

PROFILE THRU PLANT AND DISCHARGE LINE.

CITY OF SALINA ENGINEERING DEPARTMENT	
SOUTHERN HEIGHTS SANITARY SEWAGE PUMPING STATION	
JULY 1928	DRAWN BY R.J. PAULLETTE