
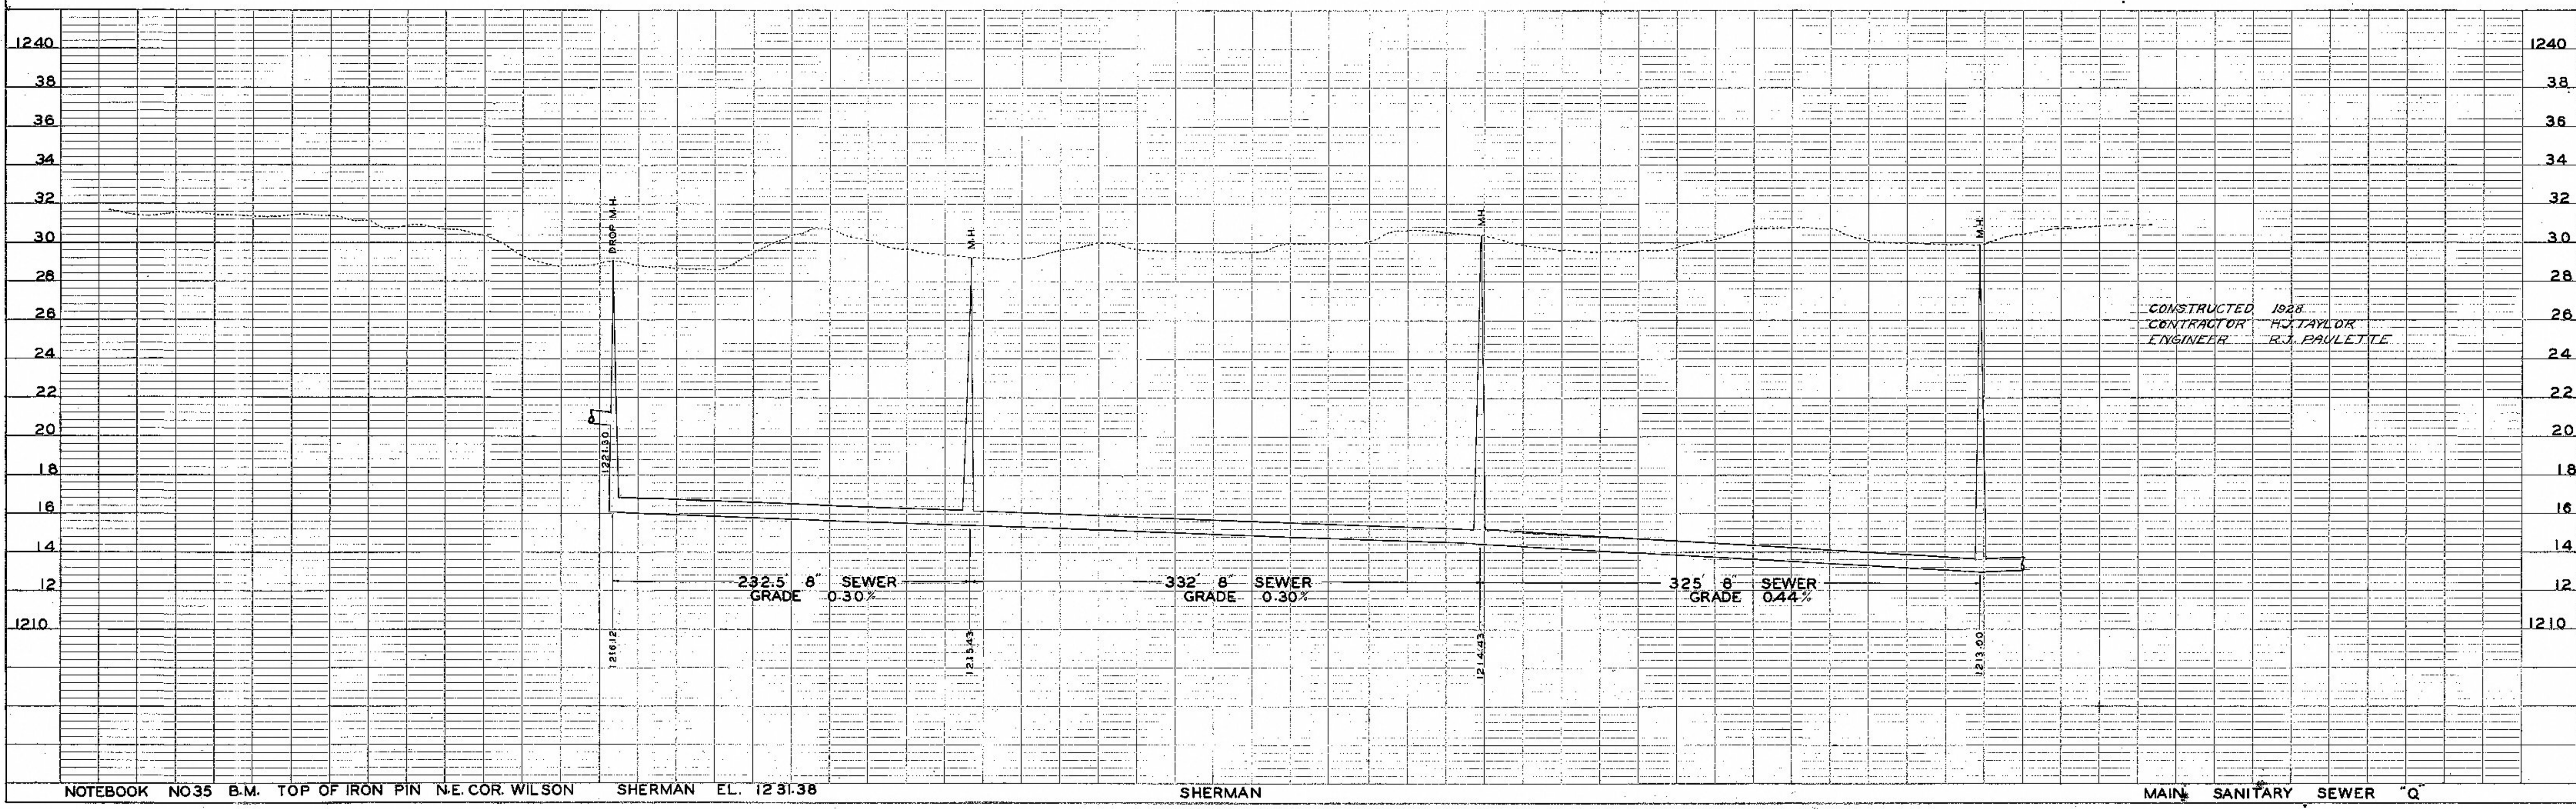


PLAN
 SURVEYED BY L.M. SRACK
 PLOTTED BY L.A. CAMPBELL
 CHECKED BY R.M. FORTNEY
 DATE 12/31/38

PROFILE
 SURVEYED BY L.M. SRACK
 PLOTTED BY L.A. CAMPBELL
 CHECKED BY R.M. FORTNEY
 DATE 12/31/38

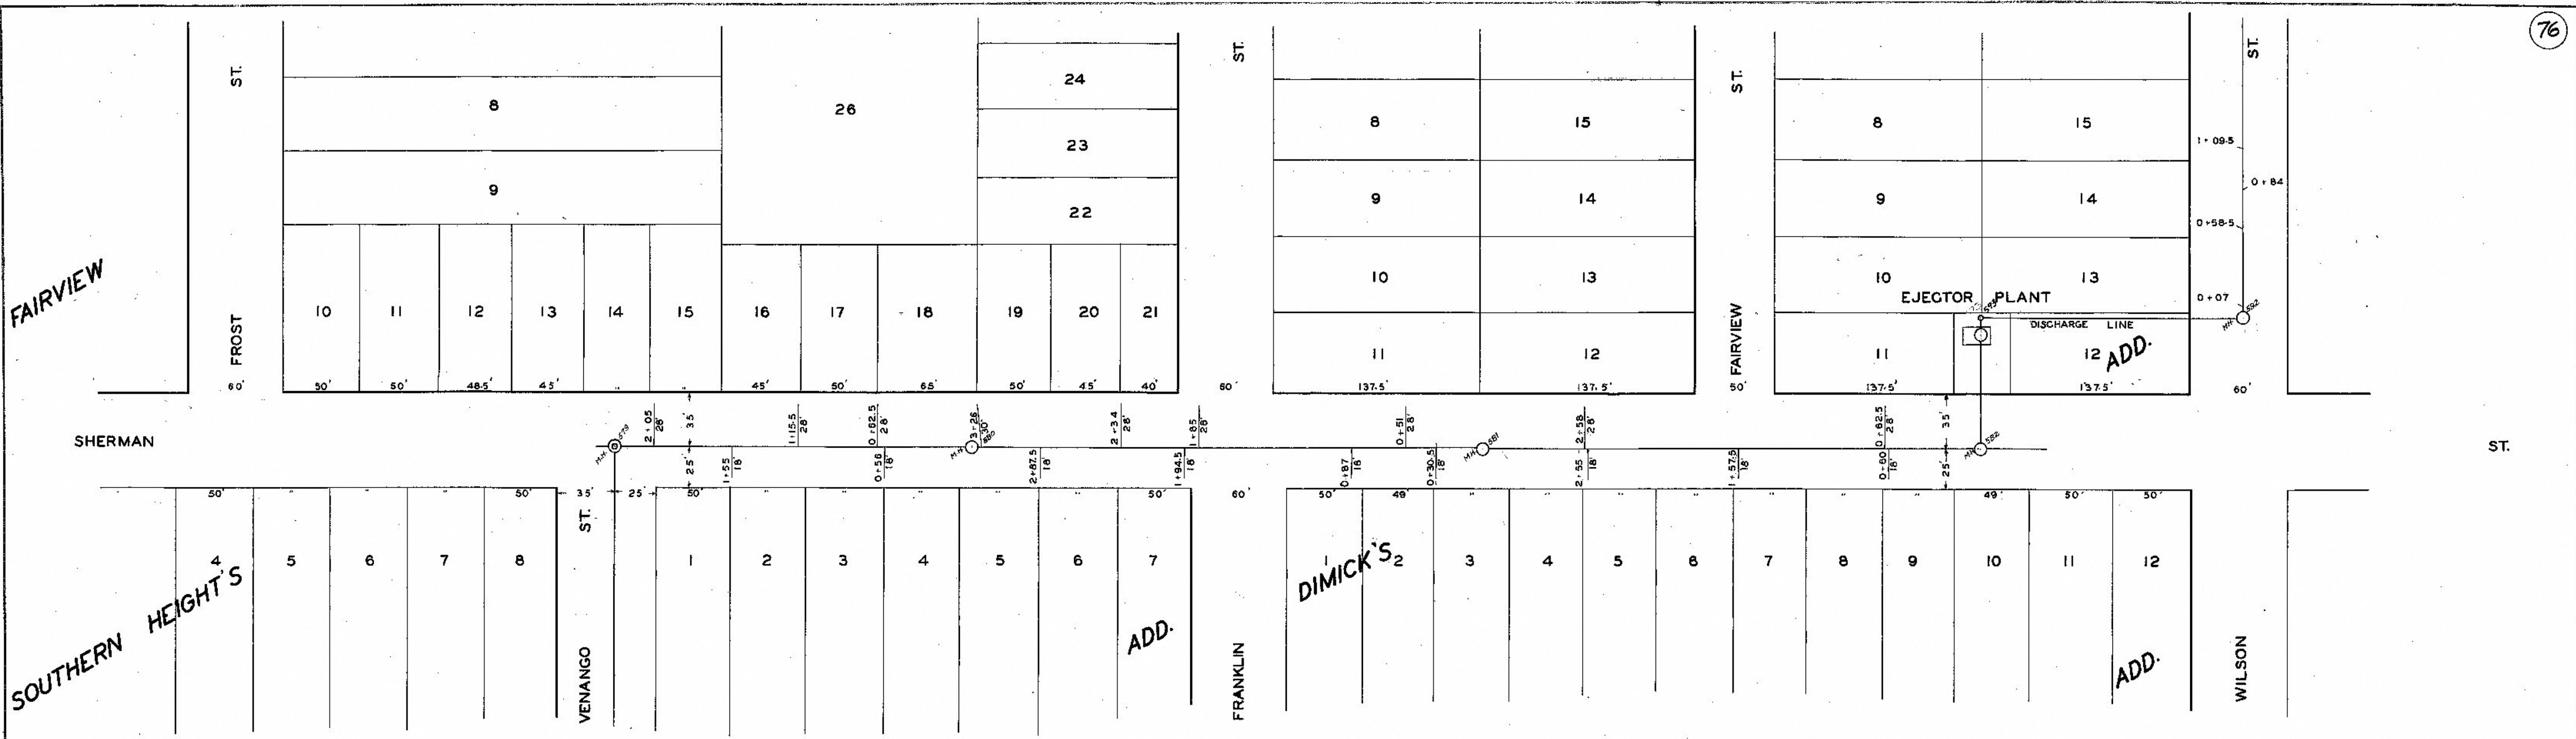

NOTEBOOK NO35 B.M. TOP OF IRON PIN N.E. COR. WILSON SHERMAN EL. 1231.38 SHERMAN MAIN SANITARY SEWER "Q"

EUGENE DIETZGEN CO., CHGO., N. Y.

PLATE 1-PLAN-PROFILE W. P. B. STANBRO

TRIM TO THIS LINE