

DATE	
BY	HEW R.F.B.
PLANNED	
NOTED	
ALIGNED	
CHECKED	
NO.	

DATE	
BY	HEW R.F.B.
PROFILE	
NOTED	
GRABES	
CHECKED	
NO.	

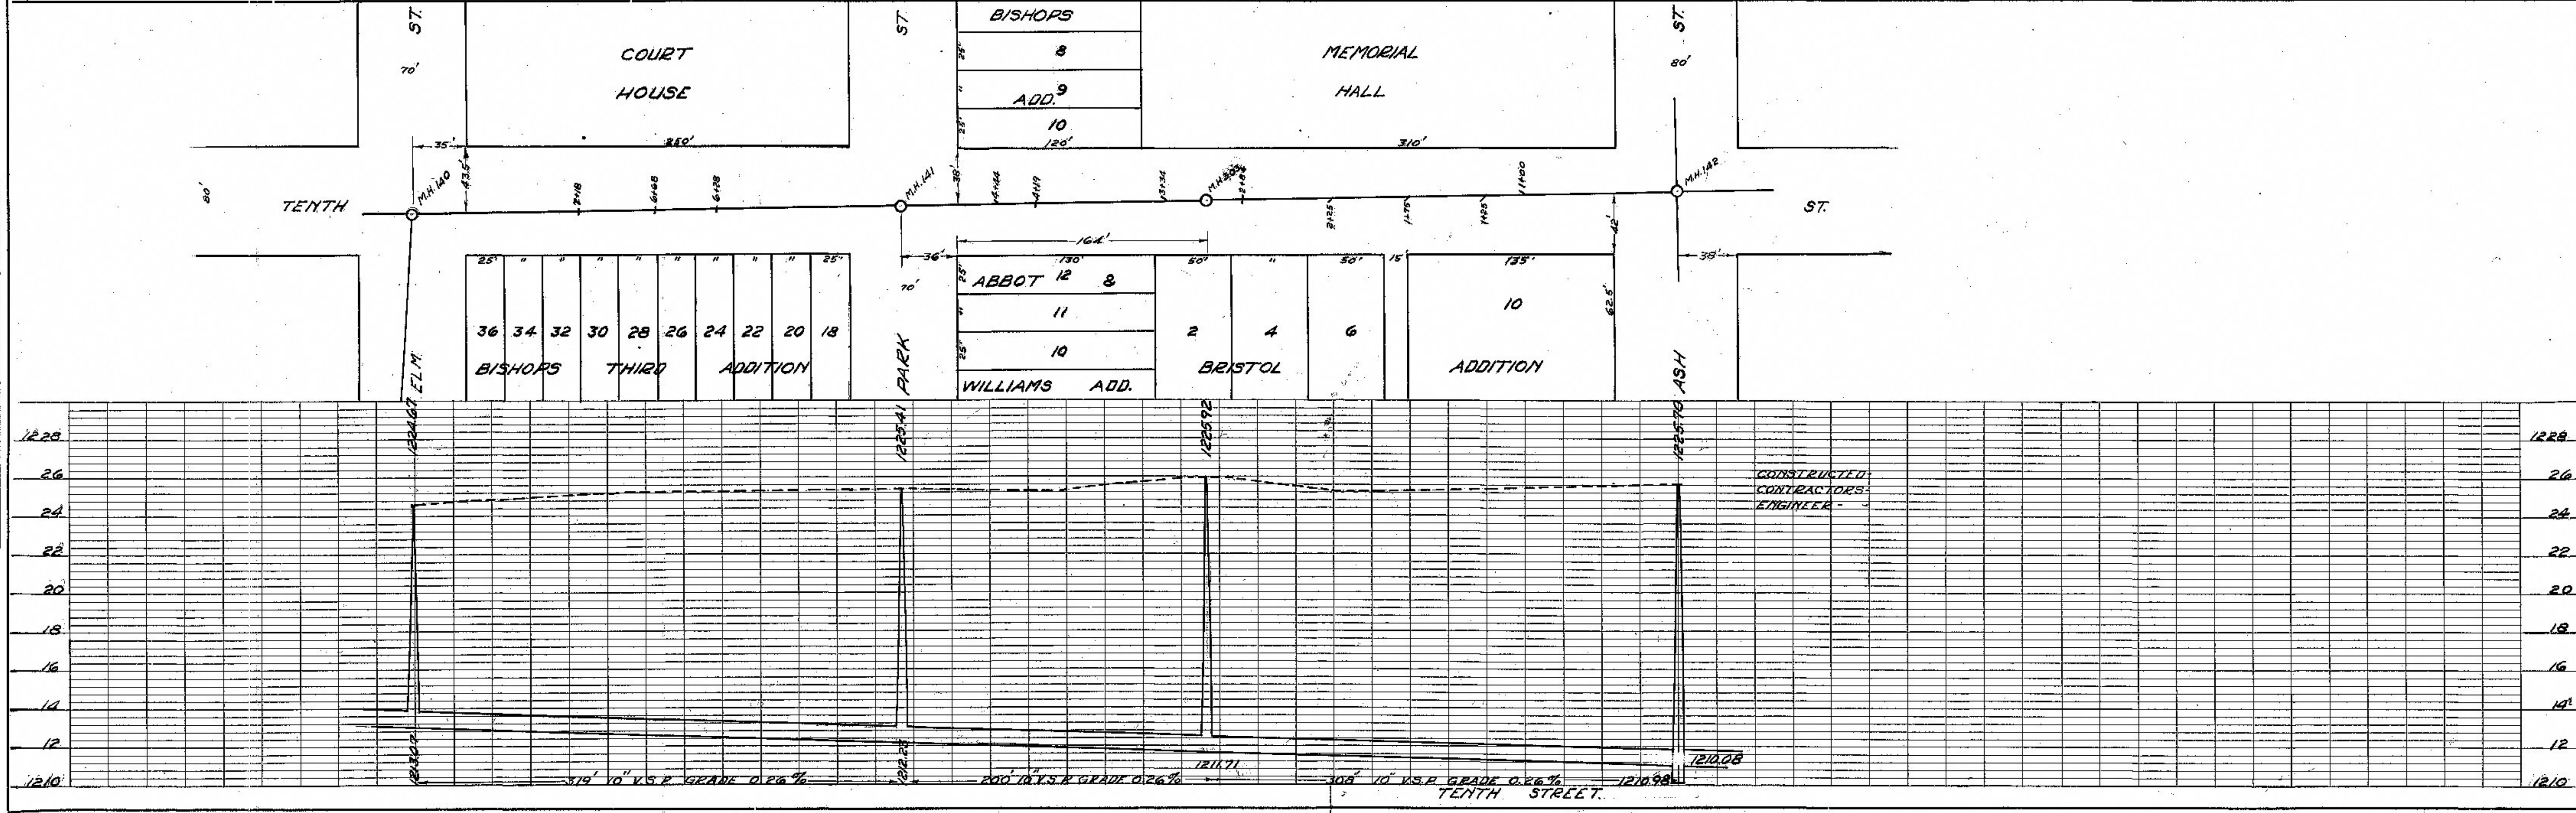
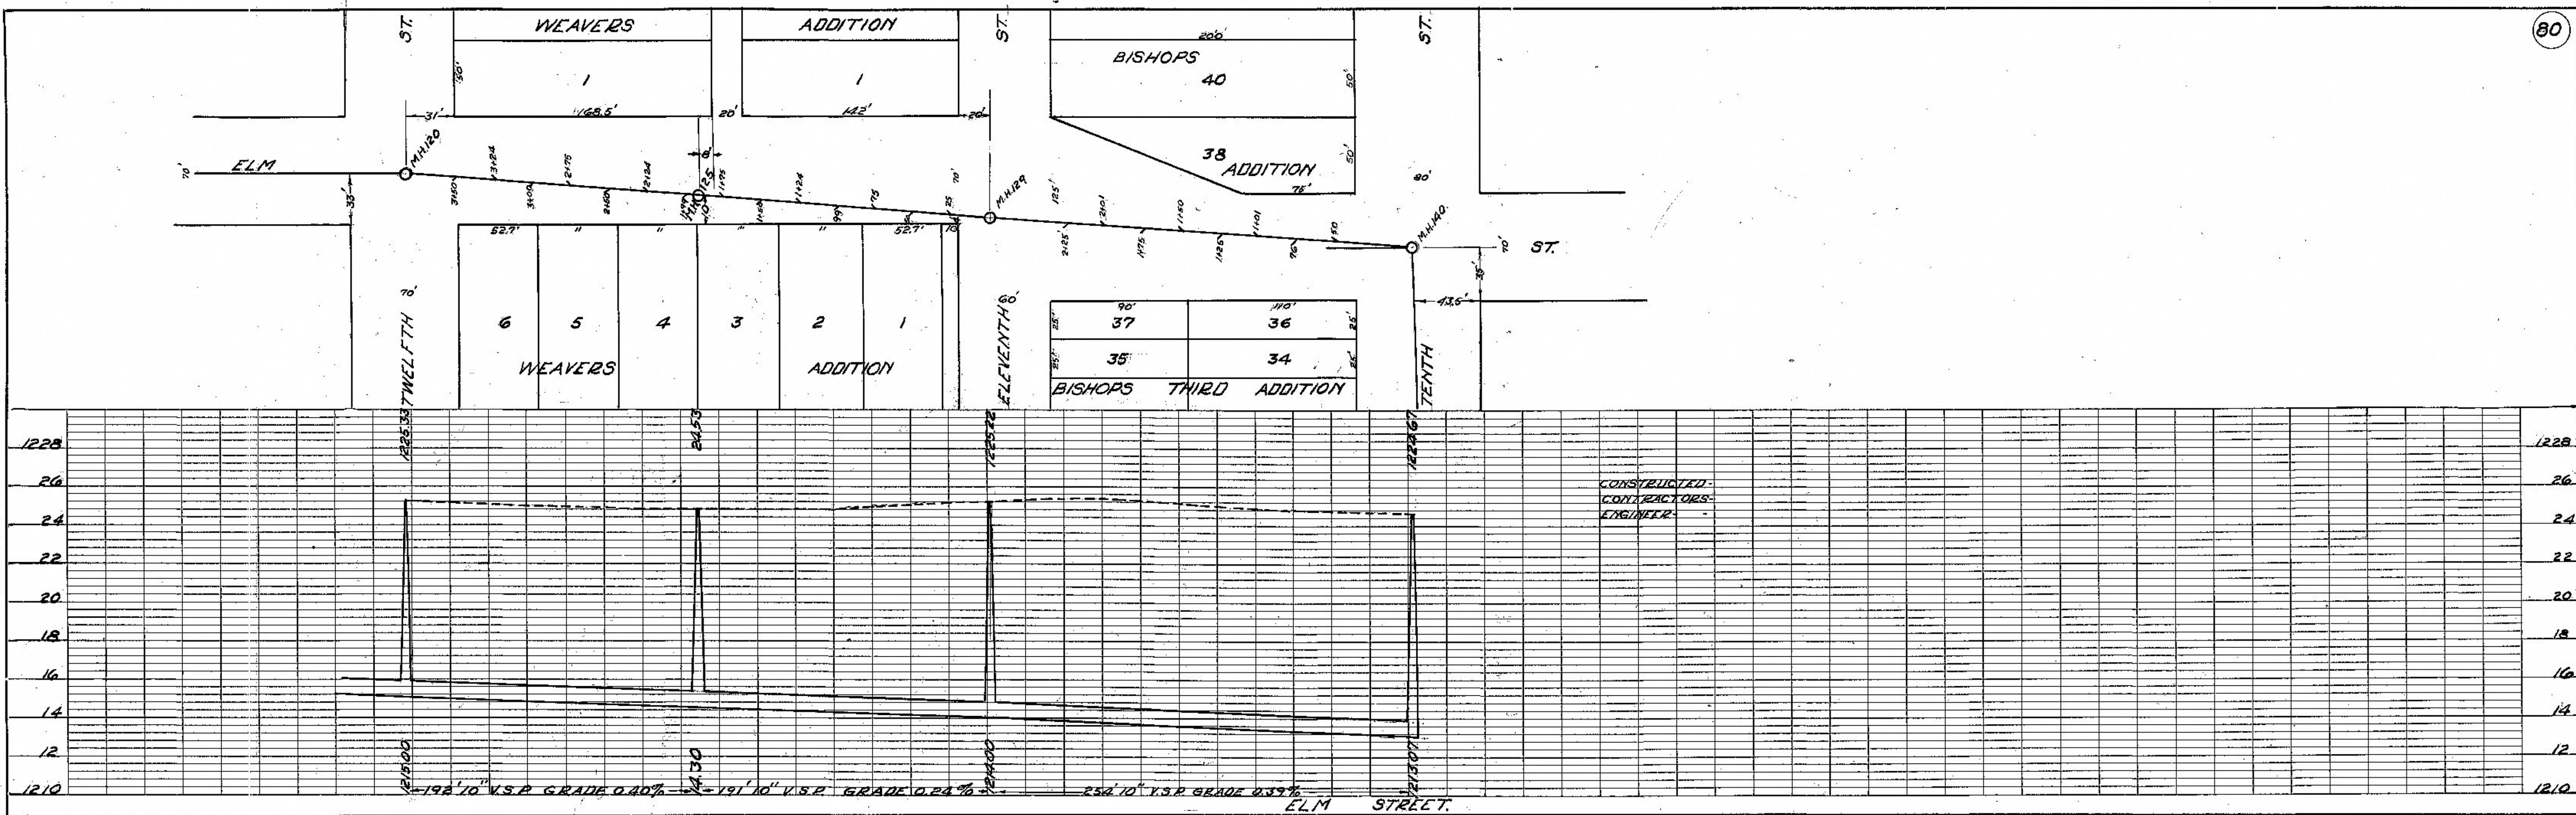


PLATE 2-PLAN-PROFILE B. P. R. STANDARD

MAIN SEWER "D"