
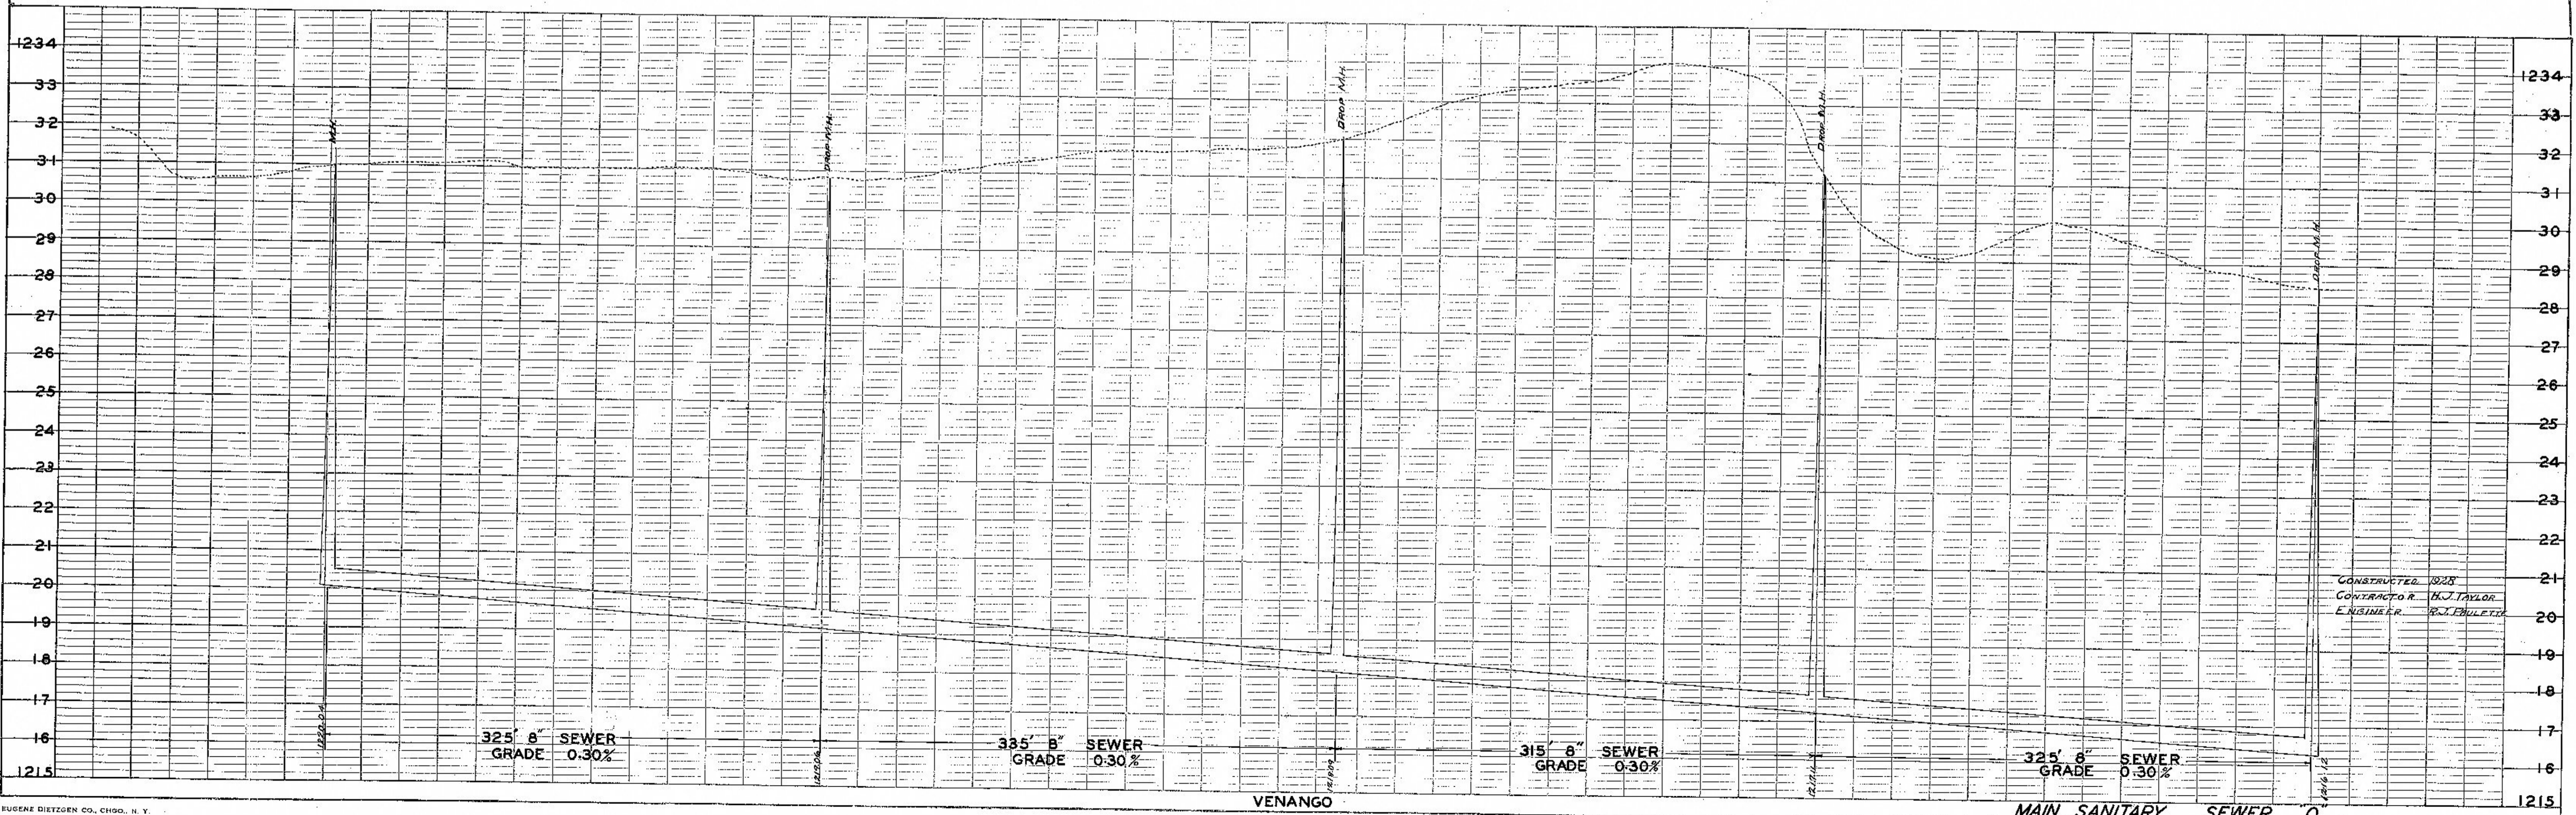


PLAN	DATE
NO.	
BY	
CHECKED	
APPROVED	
NOTE BOOK	
ALIGNED	
RT. OF WAY	

PROFILE	DATE
NO.	
BY	
CHECKED	
APPROVED	
NOTE BOOK	
ALIGNED	
RT. OF WAY	

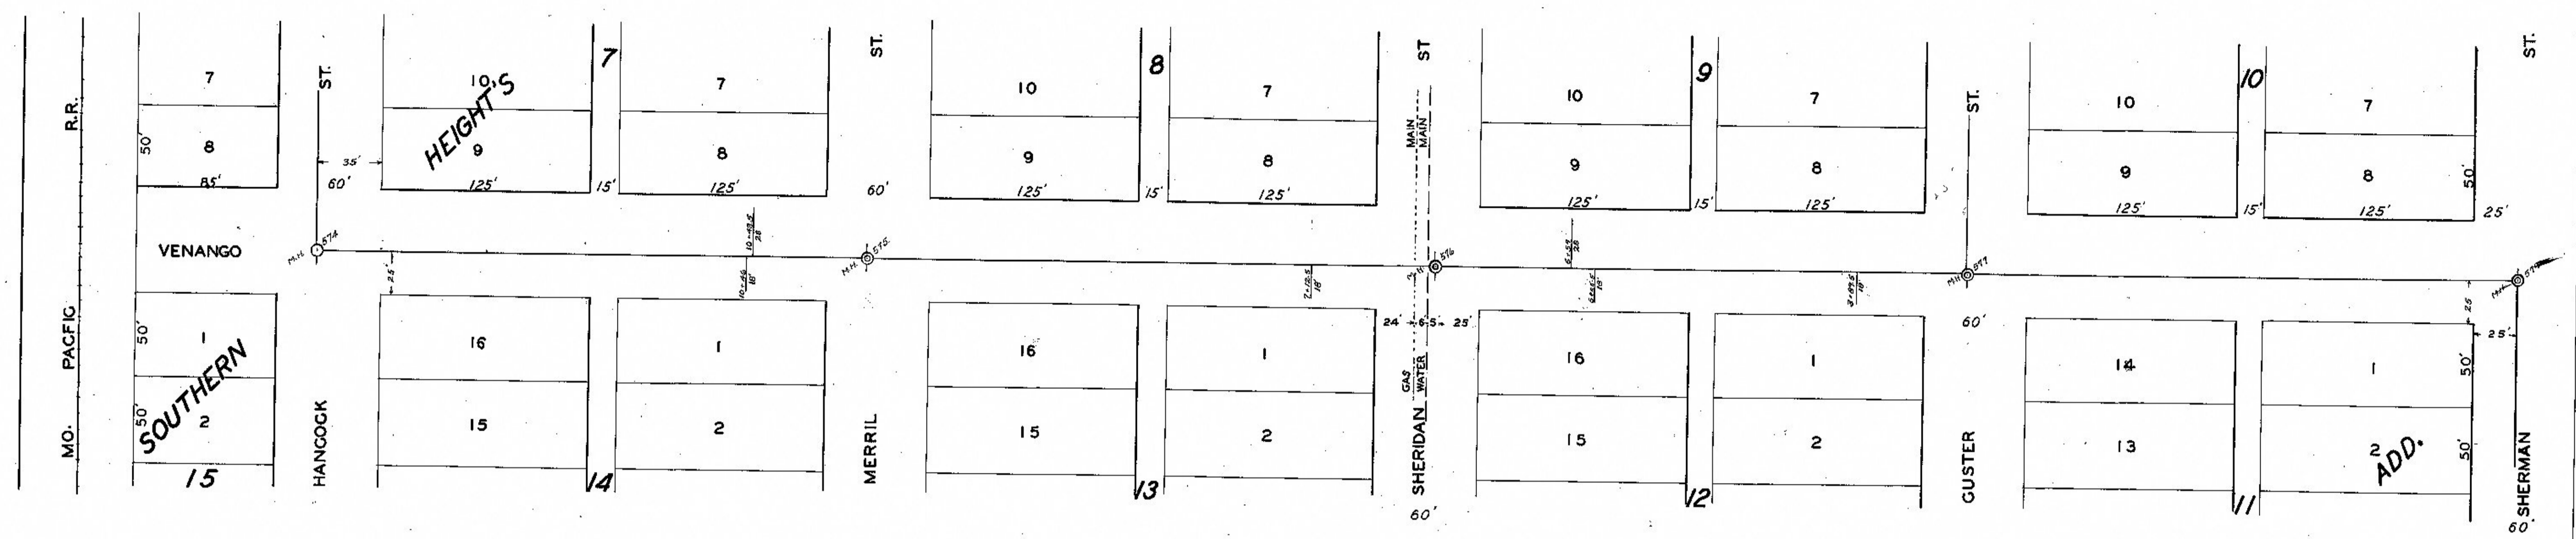

CONSTRUCTED 1928
 CONTRACTOR H.J. TAYLOR
 ENGINEER R.J. FOLETT