


PLAN
 SURVEYED BY H.E.W. R.E.B.
 NOTED BY H.E.W. R.E.B.
 CHECKED BY H.E.W. R.E.B.
 DATE

PROFILE
 SURVEYED BY H.E.W. R.E.B.
 NOTED BY H.E.W. R.E.B.
 CHECKED BY H.E.W. R.E.B.
 DATE

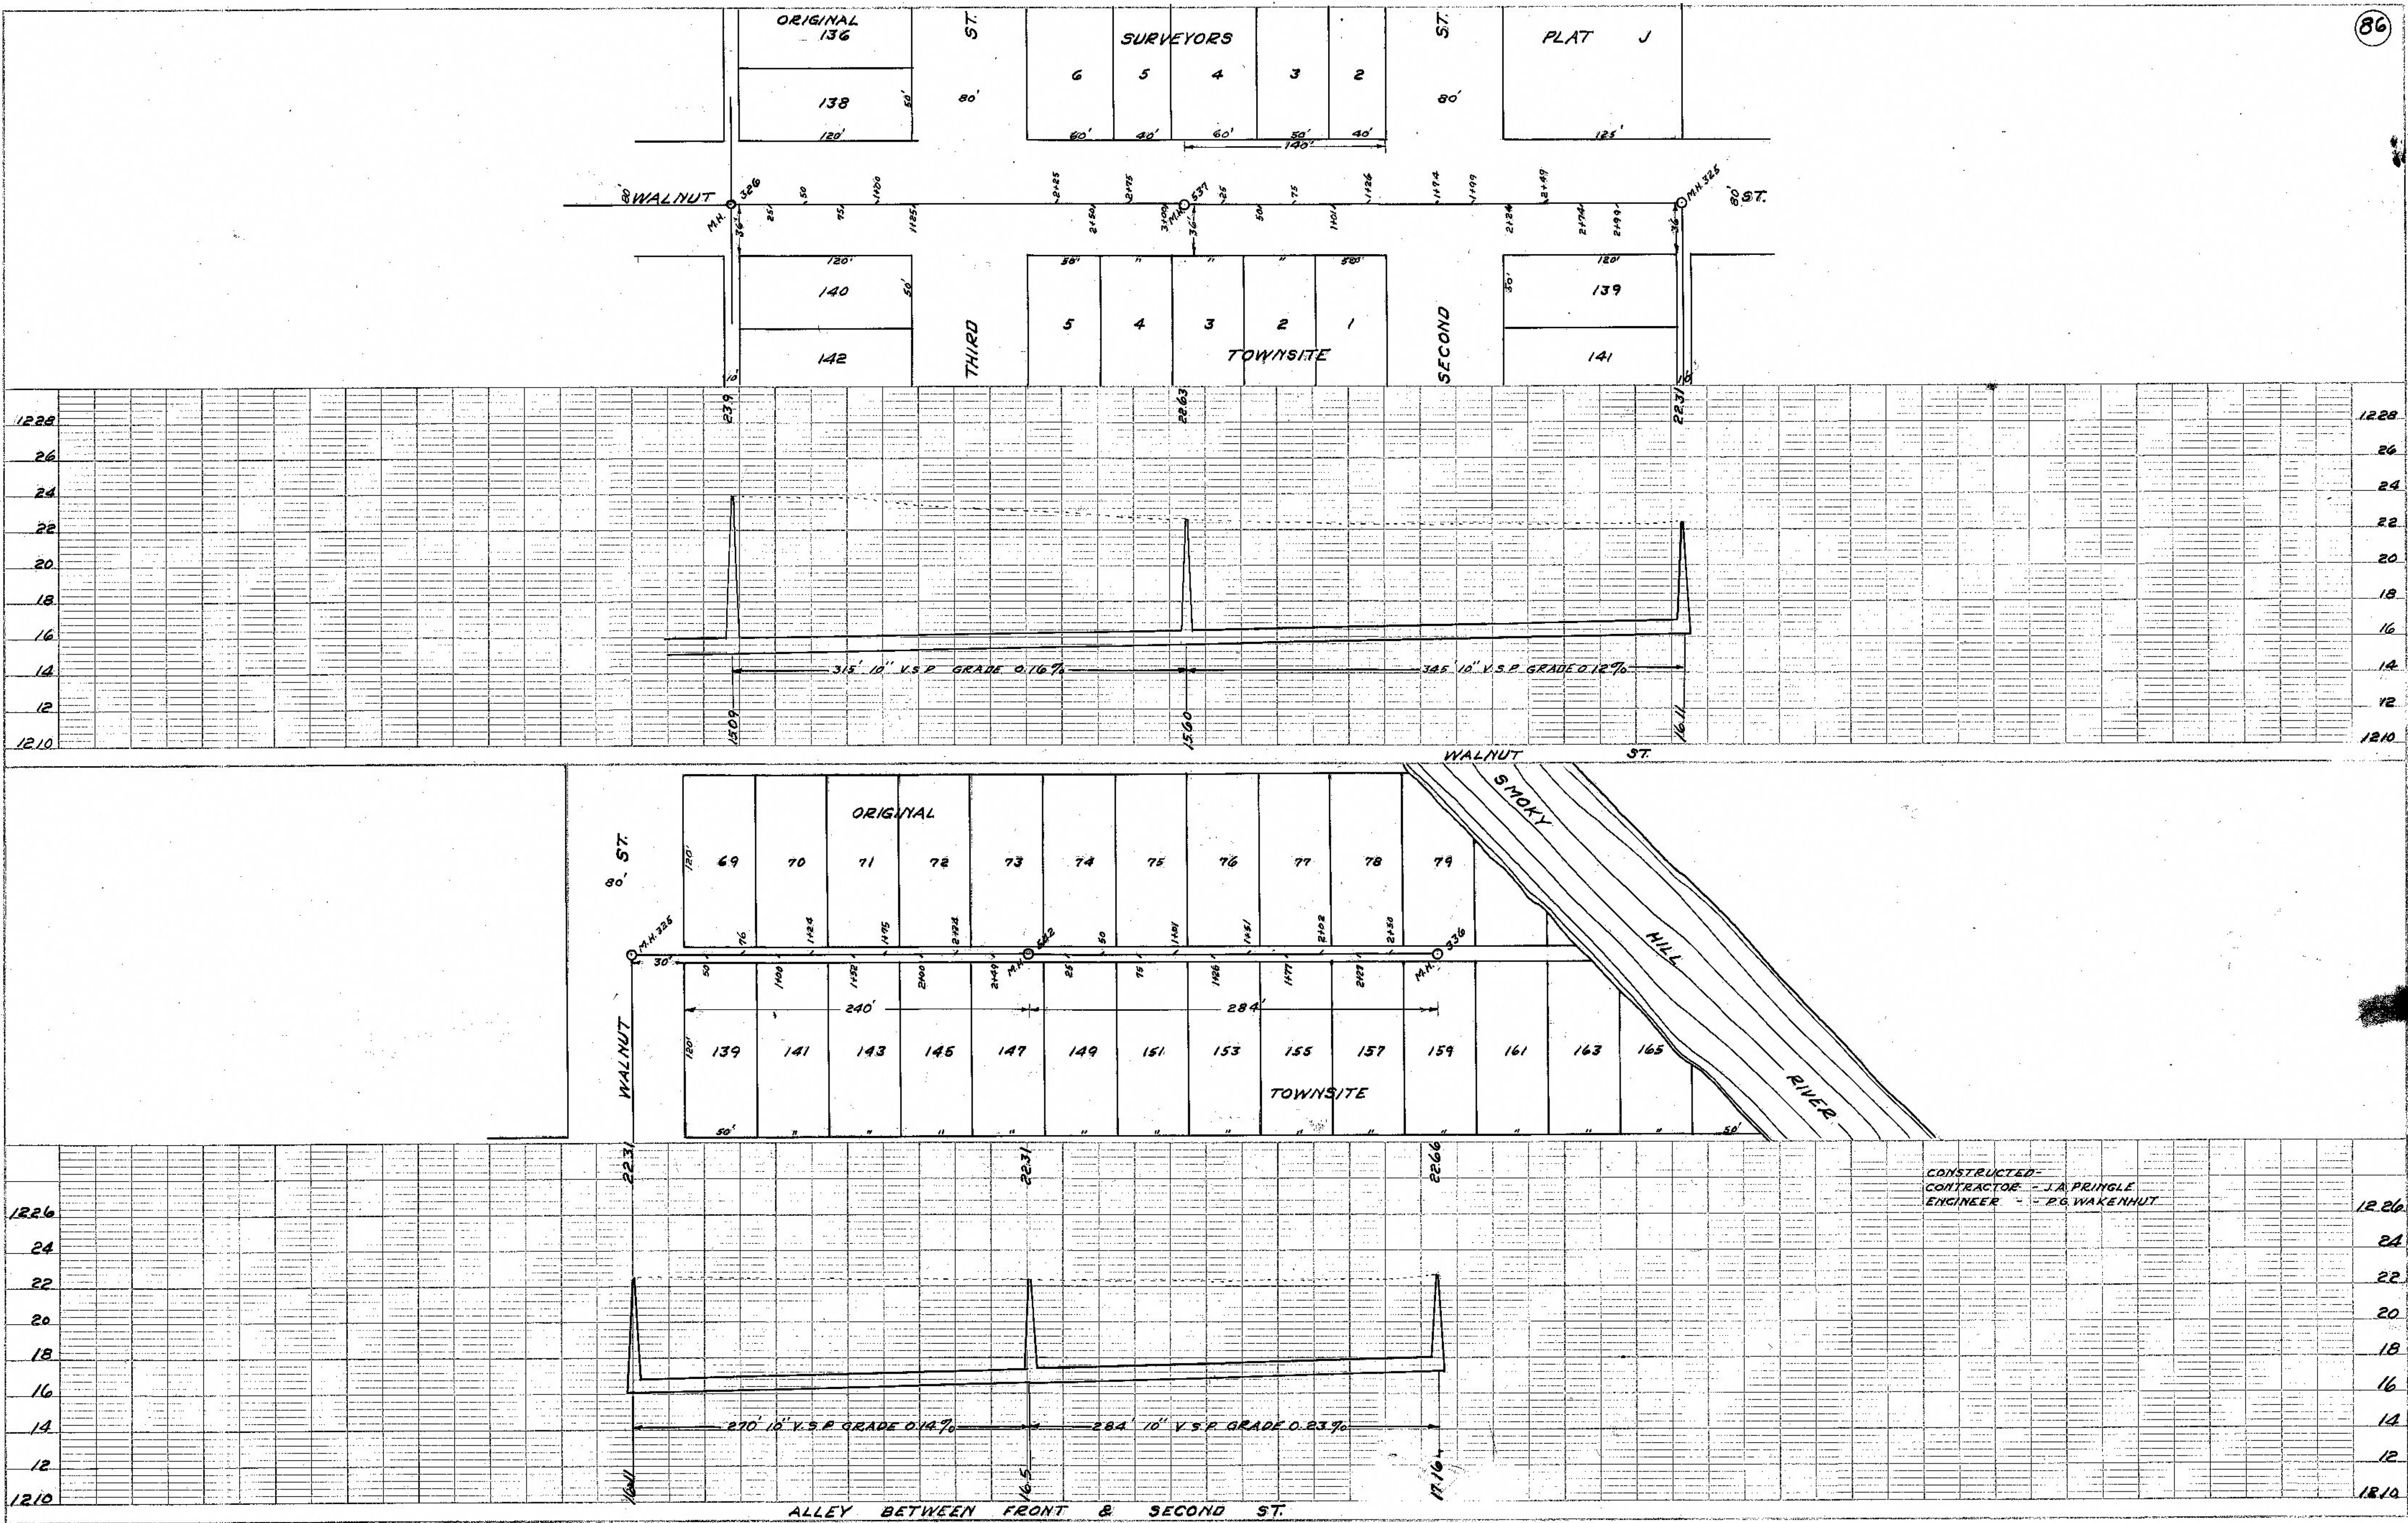

CONSTRUCTED -
 CONTRACTOR - J.A. PRINGLE
 ENGINEER - P.G. WAKENHUT