



DATE: _____
 BY: **HEW**
 SURVEYED: _____
 NOTE BOOK: _____
 ALIGNED: _____
 RET. OF WAY CHECKED: _____
 NO. _____

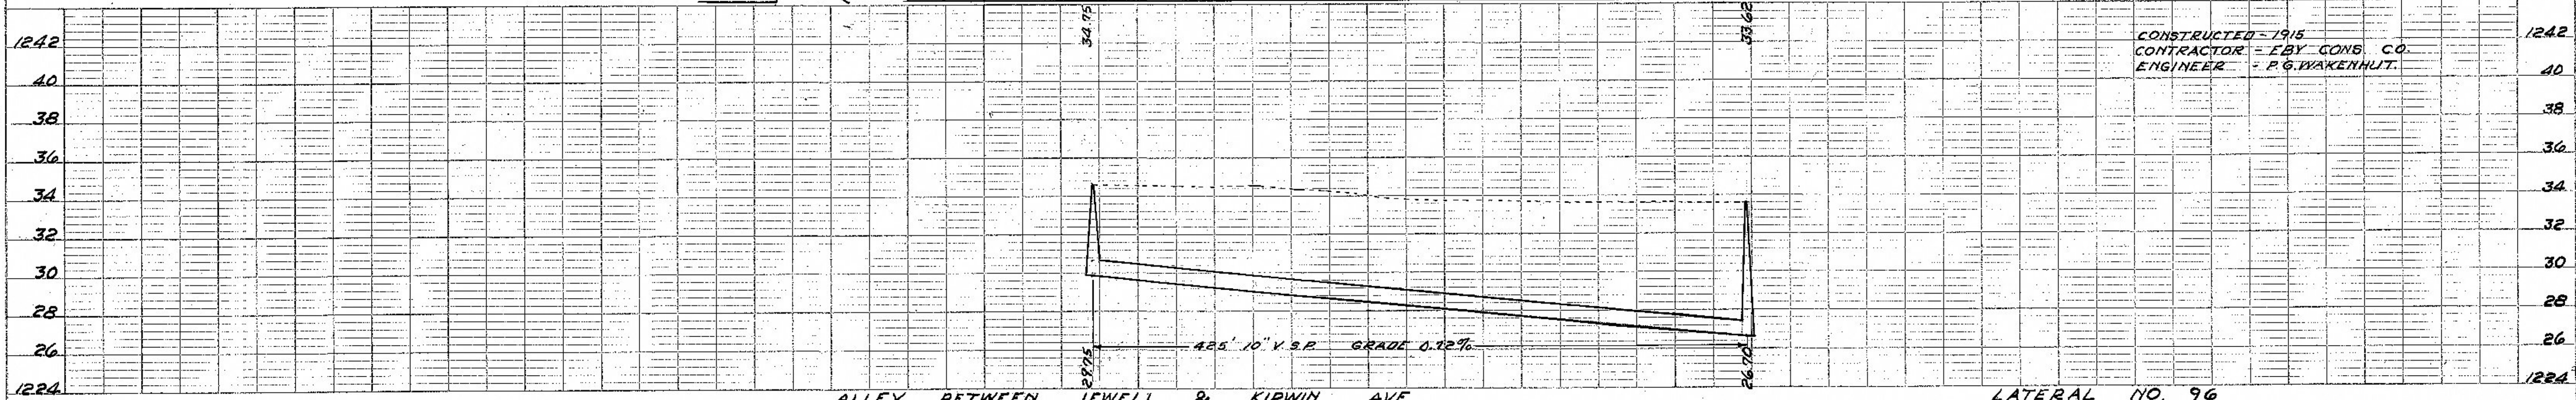

DATE: _____
 BY: **HEW**
 SURVEYED: _____
 NOTE BOOK: _____
 ALIGNED: _____
 RET. OF WAY CHECKED: _____
 NO. _____

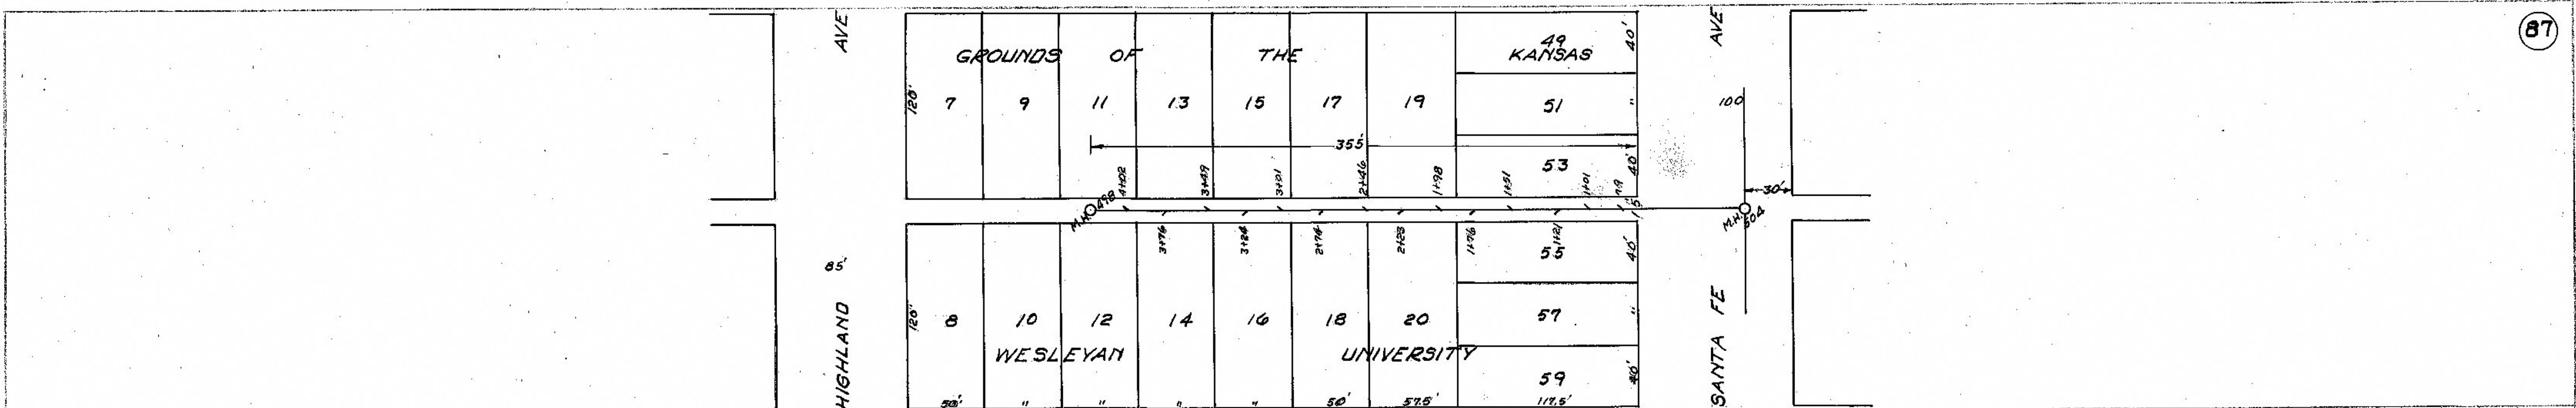