
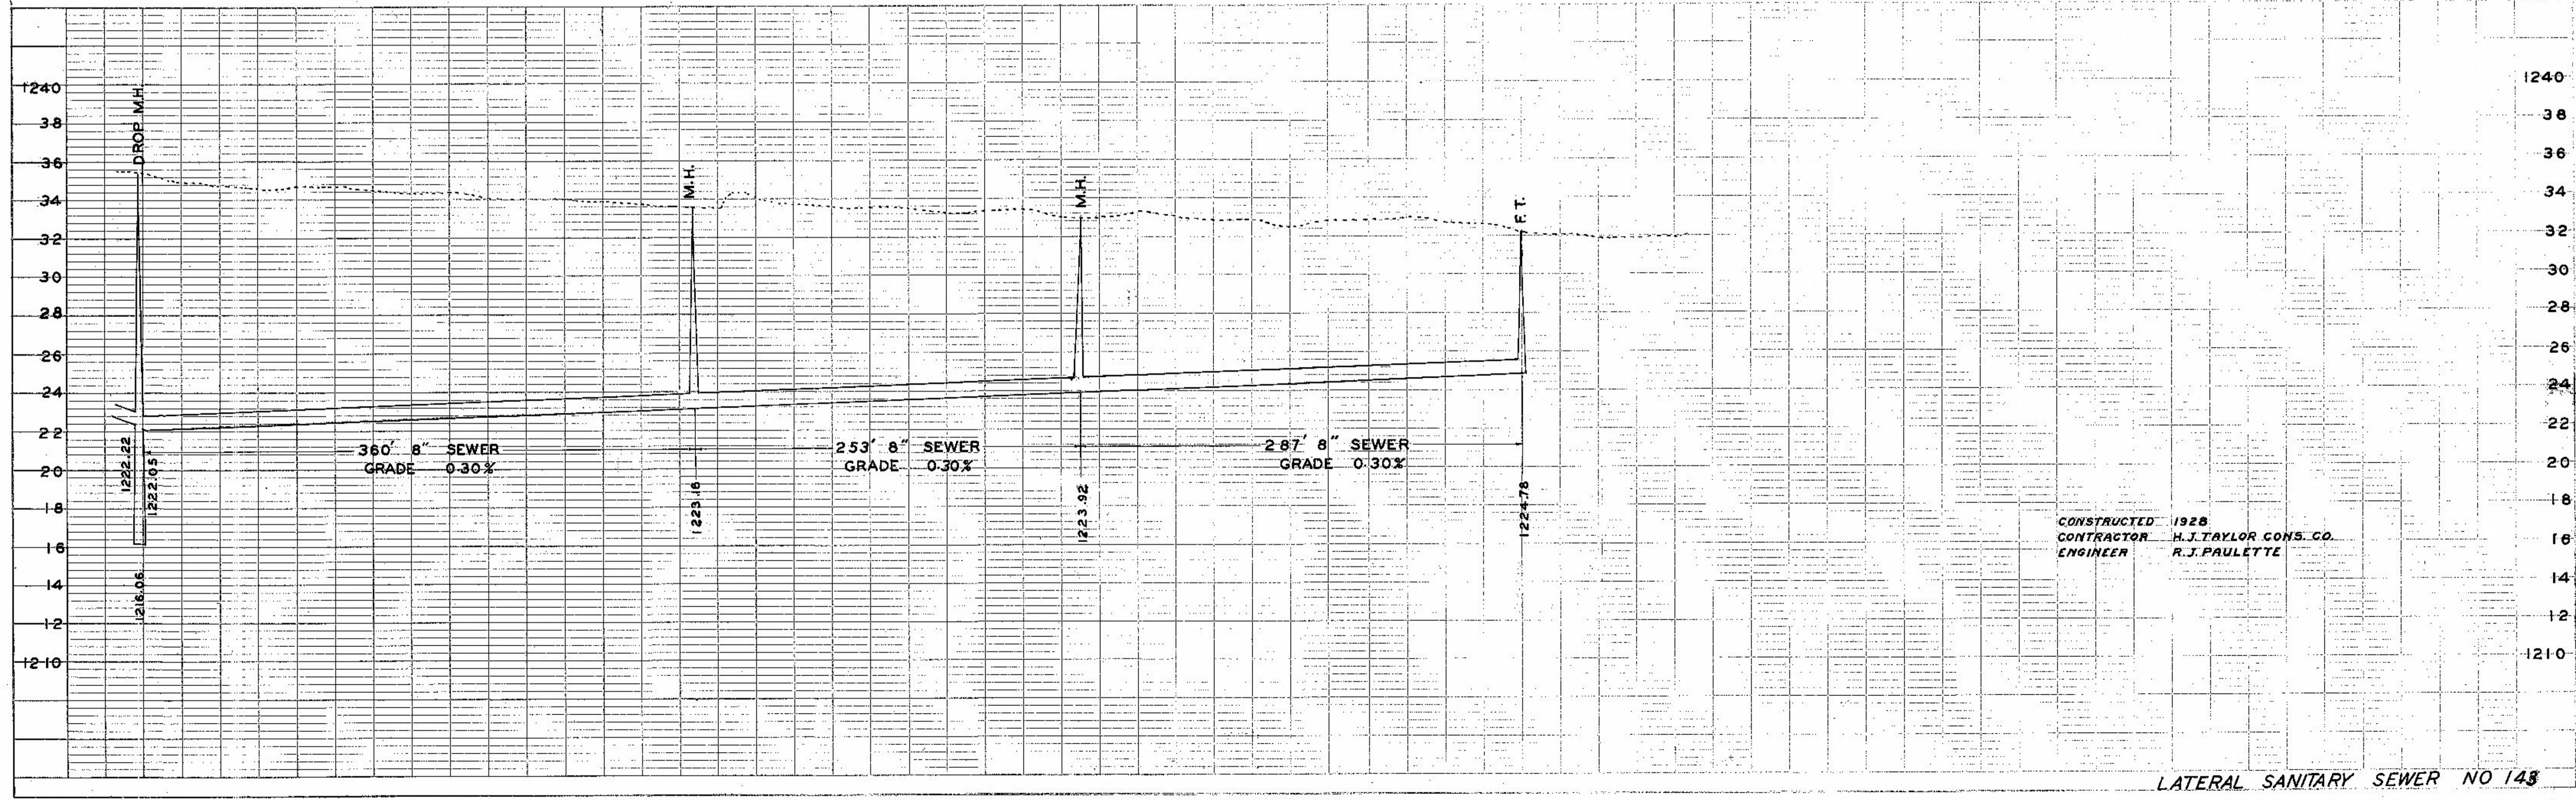


DATE: _____ BY: _____
 PLAN NO. _____
 SURVEYED: _____
 PLOTTED: _____
 ALIGNMENT CHECKED: _____
 RT. OF WAY CHECKED: _____

BM-M ON HYD. BELOIT & HIGHLAND
 CIRCLE ELEV. 1235.90

DATE: _____ BY: _____
 PROFILE NO. _____
 SURVEYED: _____
 PLOTTED: _____
 GRADES CHECKED: _____
 STRUCTURE NOTATIONS: _____

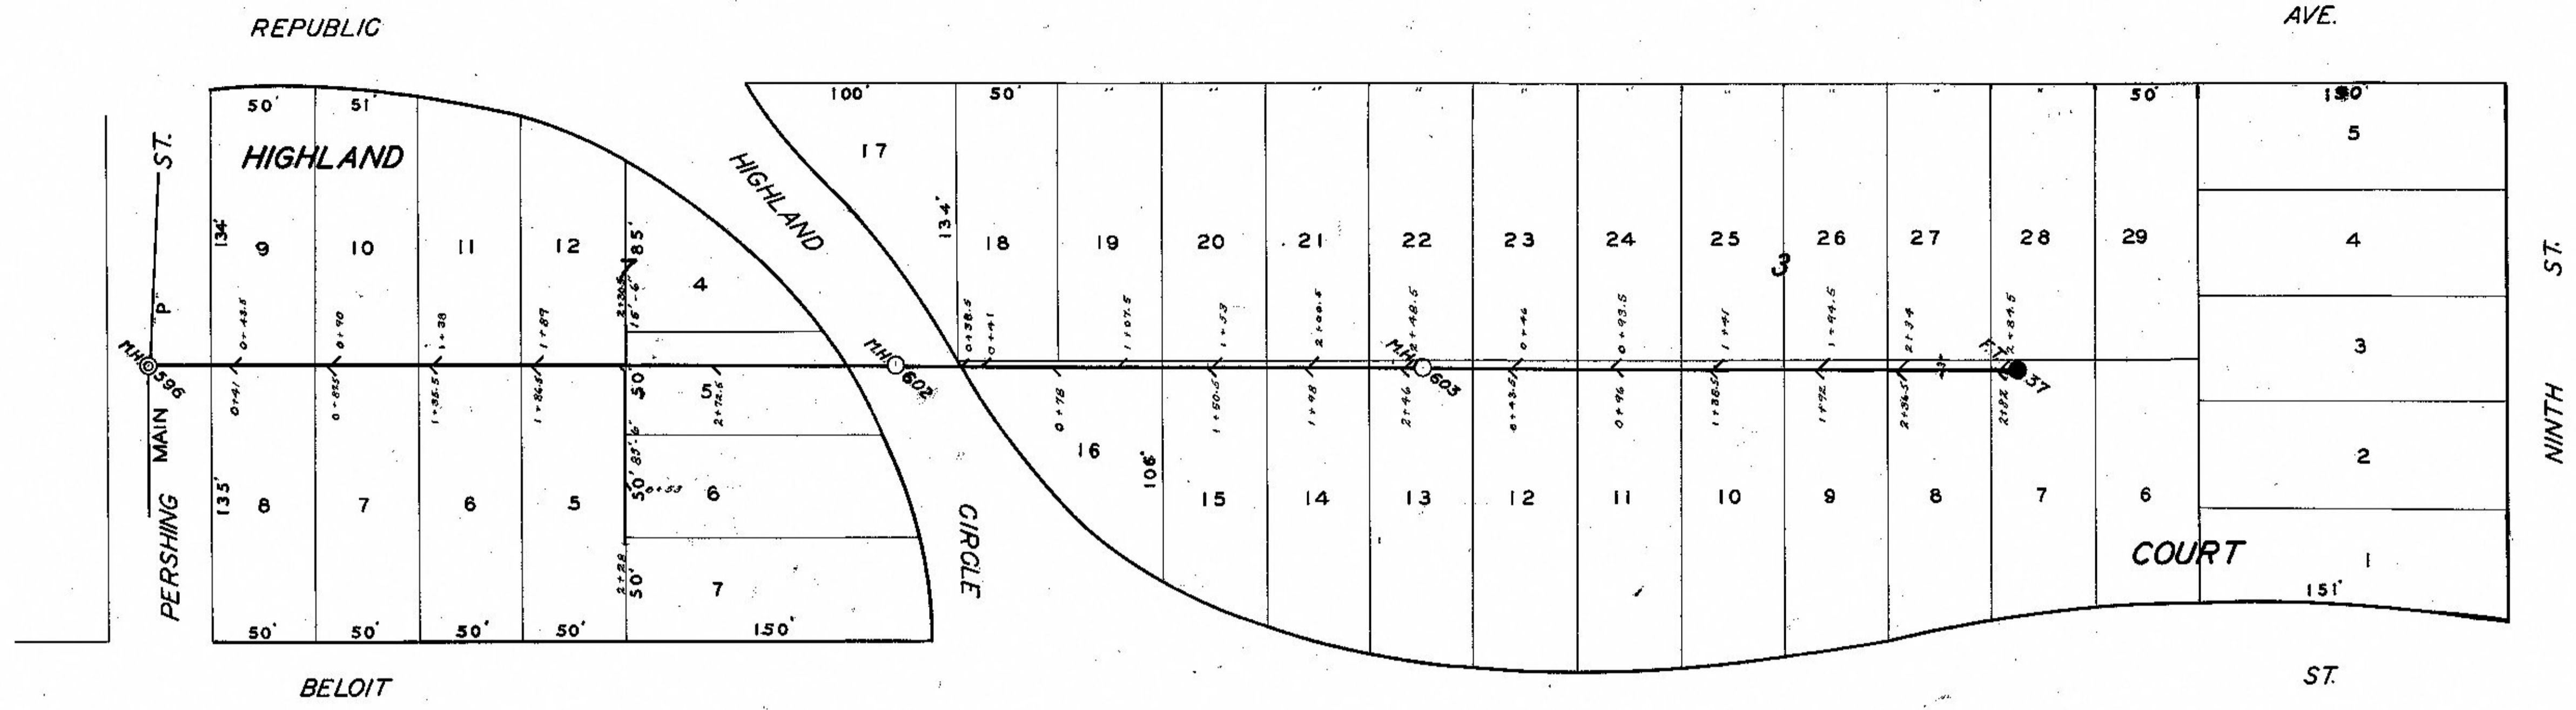

CONSTRUCTED 1928
 CONTRACTOR H.J. TAYLOR CONS. CO.
 ENGINEER R.J. PAULETTE