


PLAN: SURVEYED, PLOTTED, ALIGNED, CHECKED, AT. OF WAY CHECKED.
 H.E.B.
 H.E.B.



PROFILE: SURVEYED, PLOTTED, ALIGNED, CHECKED, AT. OF WAY CHECKED.
 H.E.B.
 H.E.B.

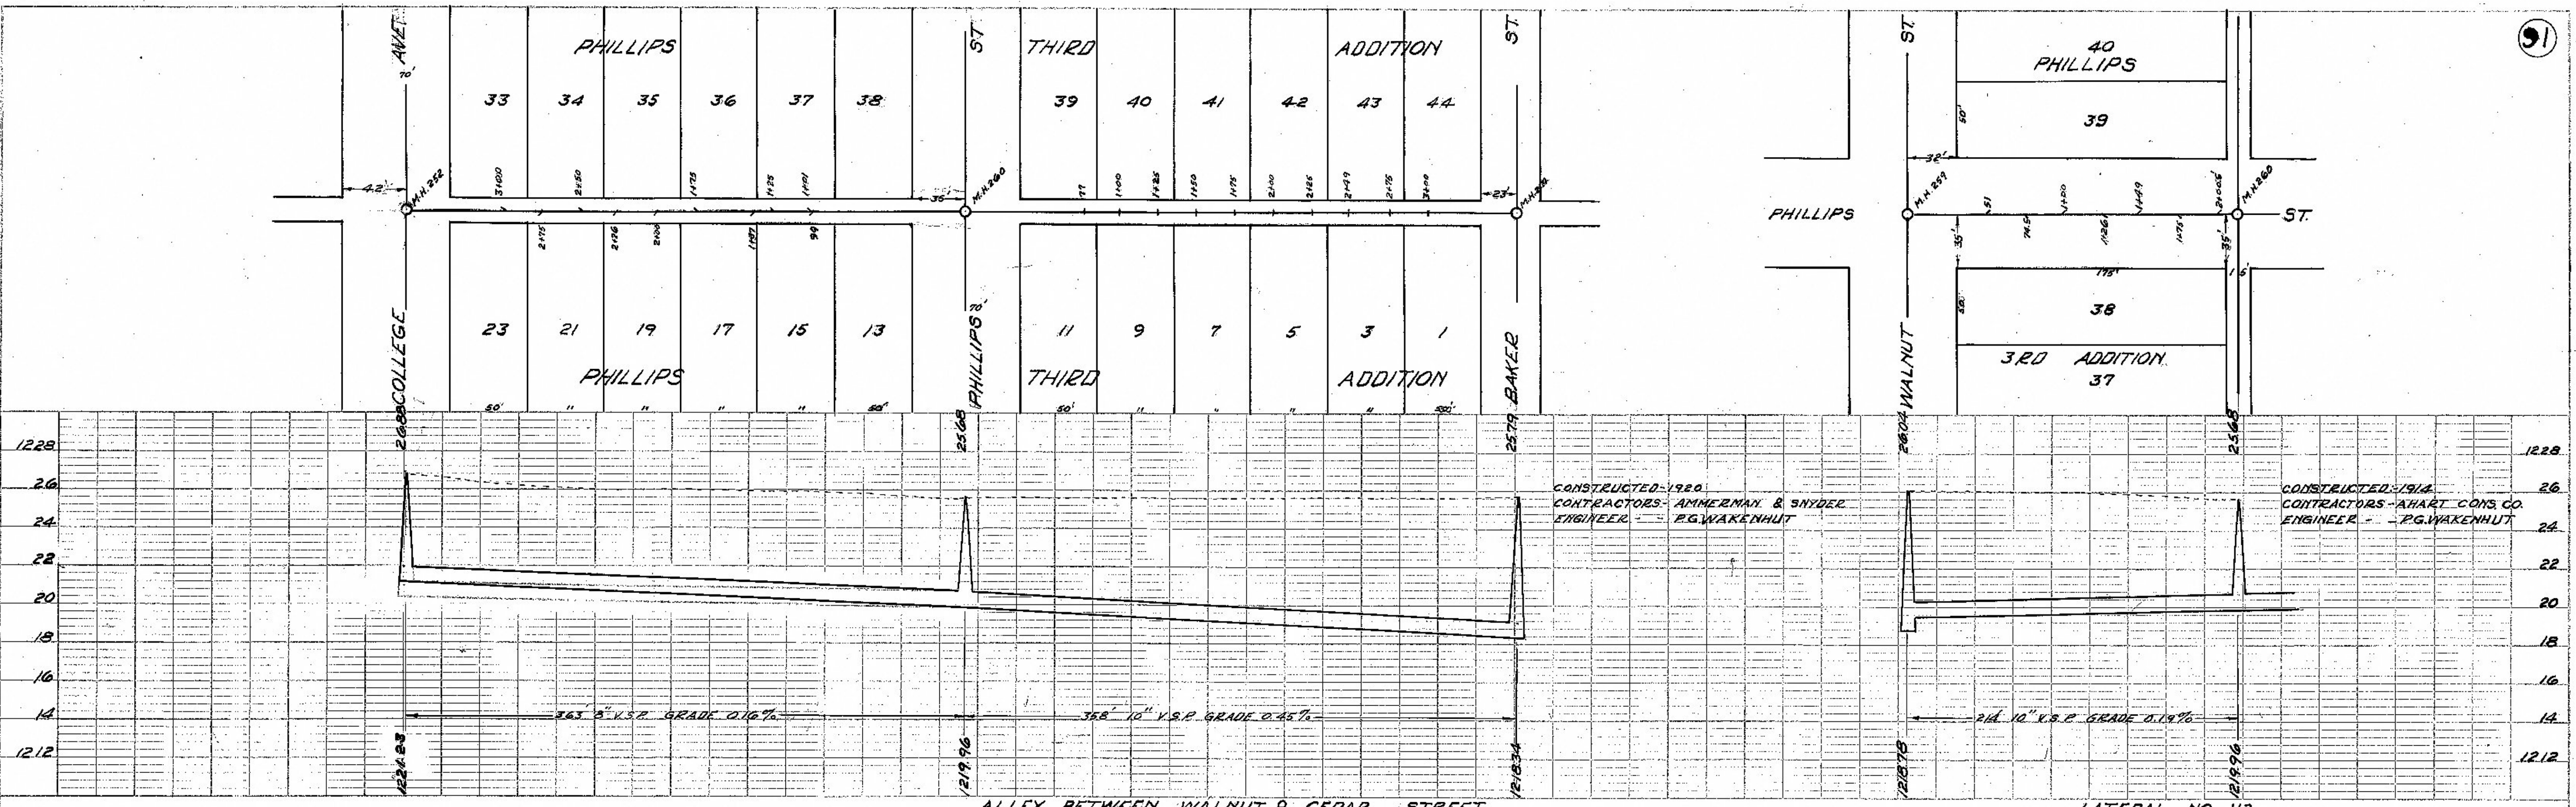