

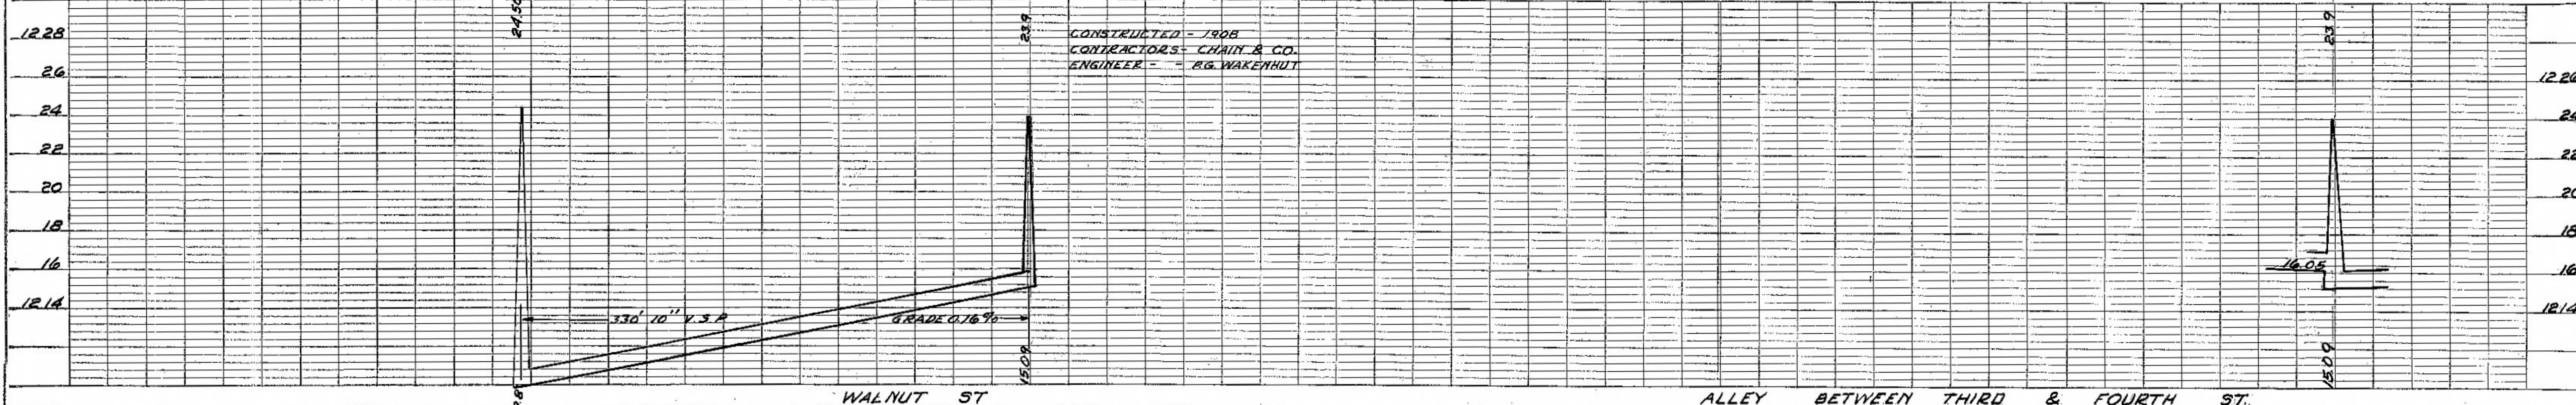
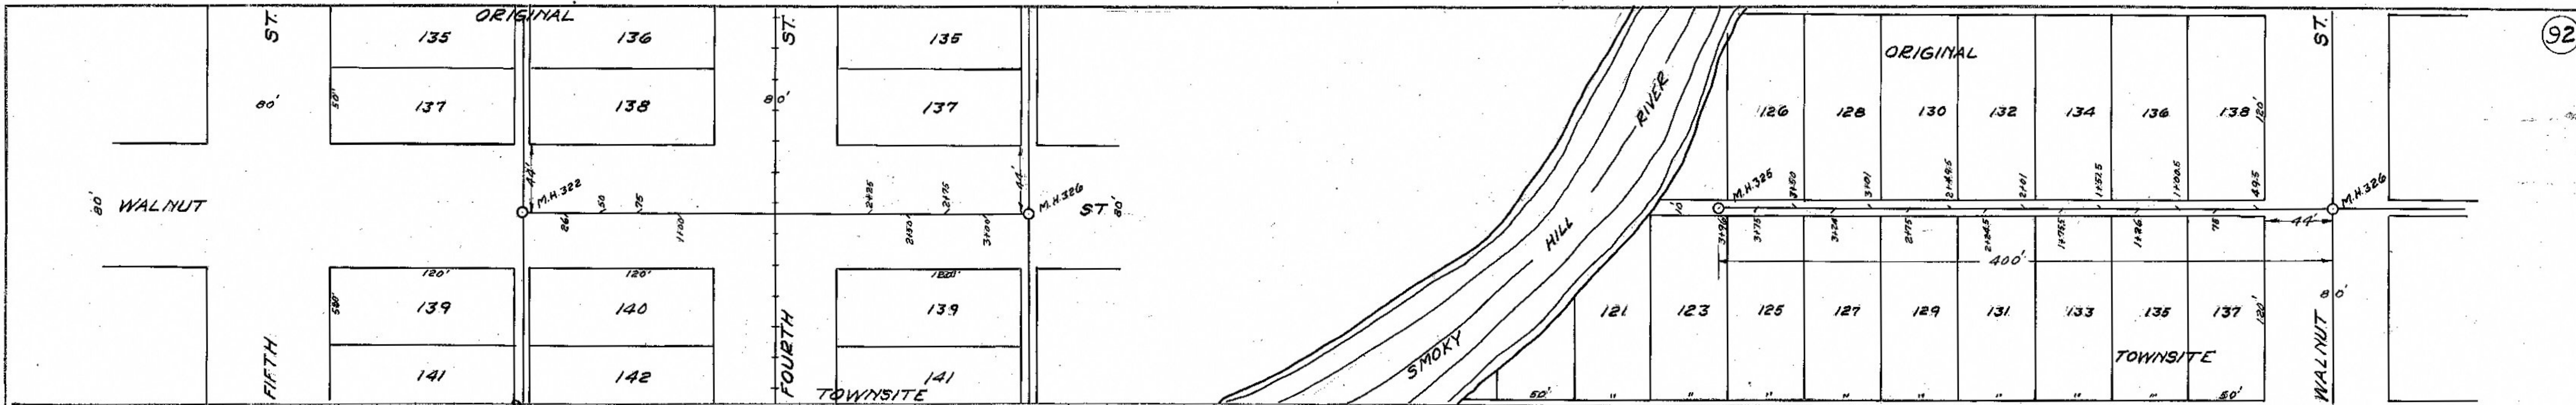


DATE \_\_\_\_\_  
 BY \_\_\_\_\_  
 SURVEYED \_\_\_\_\_  
 PLOTTED \_\_\_\_\_  
 ALIGNED CHECKED \_\_\_\_\_  
 NOTE BOOK \_\_\_\_\_  
 NO. \_\_\_\_\_

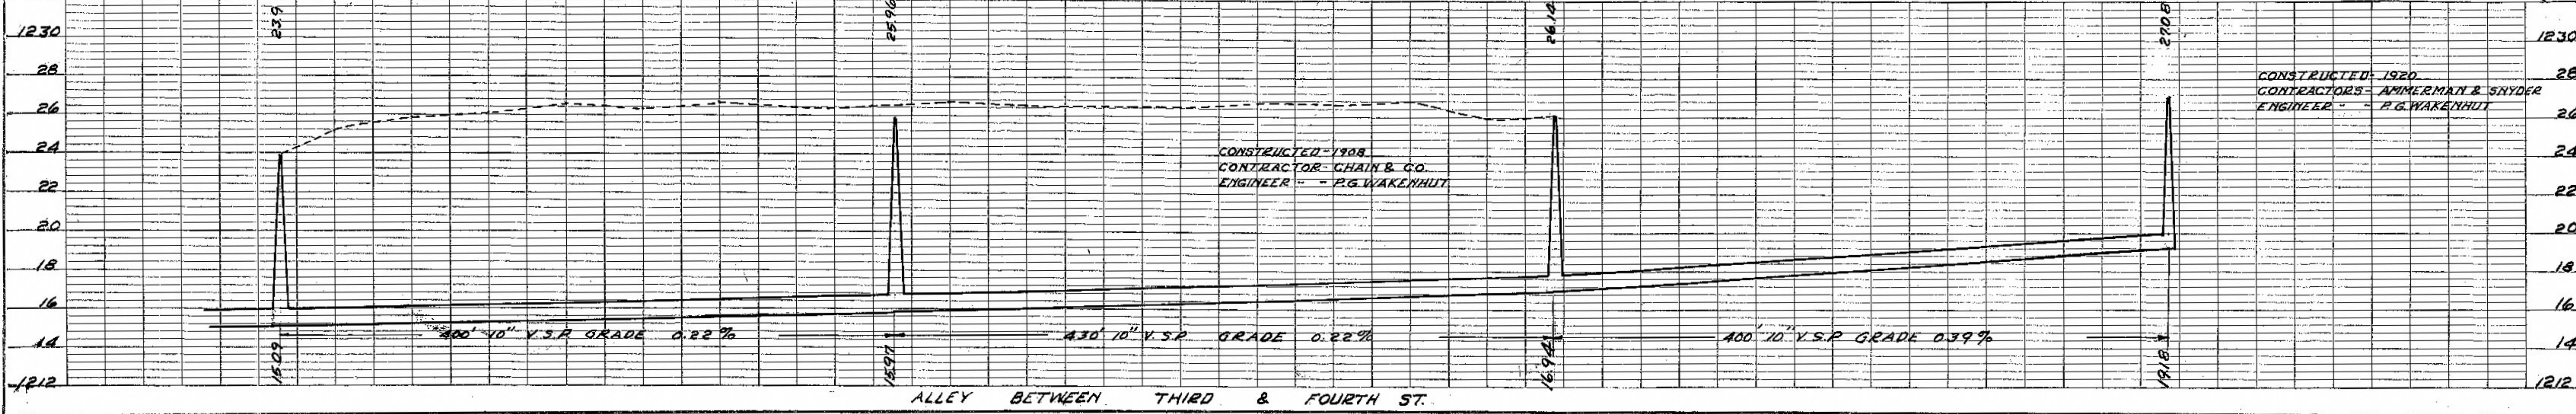

CONSTRUCTED - 1908  
 CONTRACTORS - CHAIN & CO.  
 ENGINEER - P.G. WAKENHUT

DATE \_\_\_\_\_  
 BY \_\_\_\_\_  
 SURVEYED \_\_\_\_\_  
 PLOTTED \_\_\_\_\_  
 ALIGNED CHECKED \_\_\_\_\_  
 NOTE BOOK \_\_\_\_\_  
 NO. \_\_\_\_\_

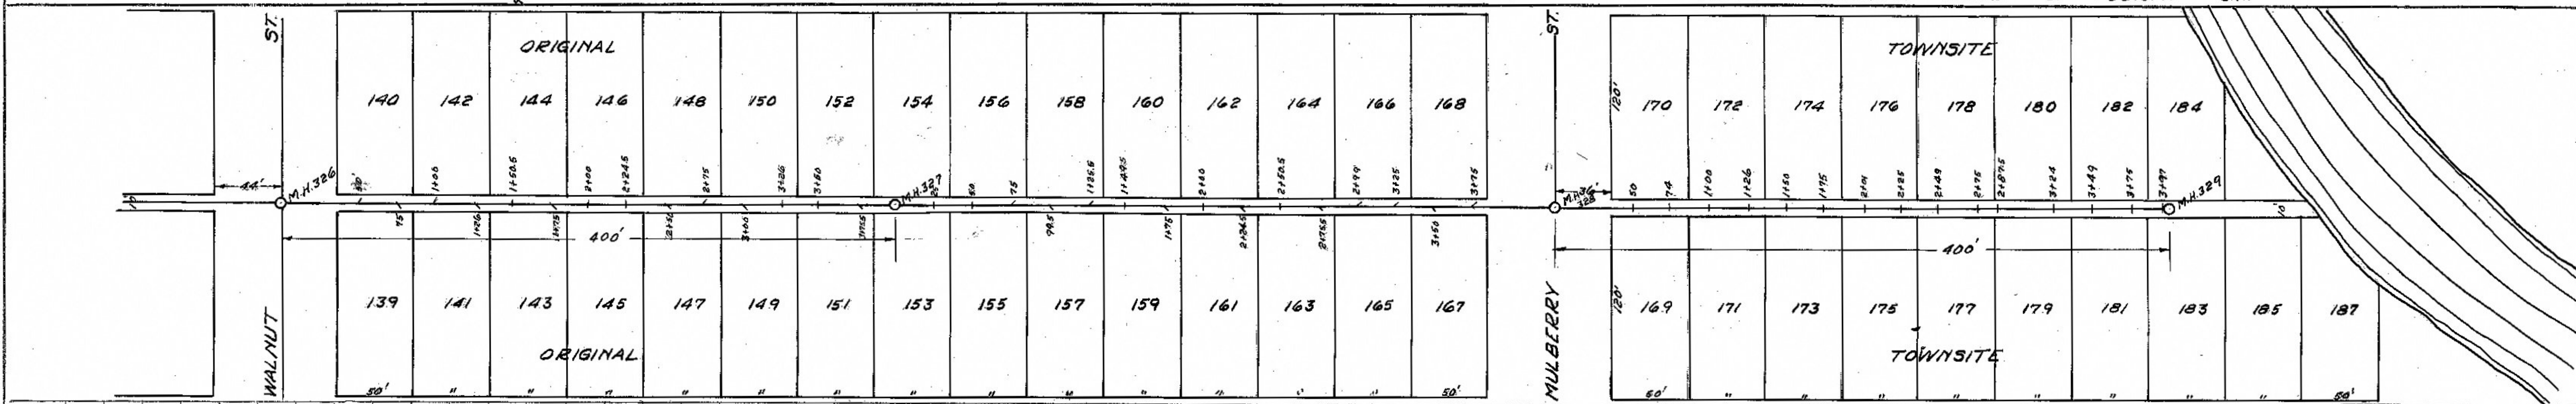

CONSTRUCTED - 1908  
 CONTRACTOR - CHAIN & CO.  
 ENGINEER - P.G. WAKENHUT

CONSTRUCTED - 1920  
 CONTRACTORS - AMMERMAN & SNYDER  
 ENGINEER - P.G. WAKENHUT