
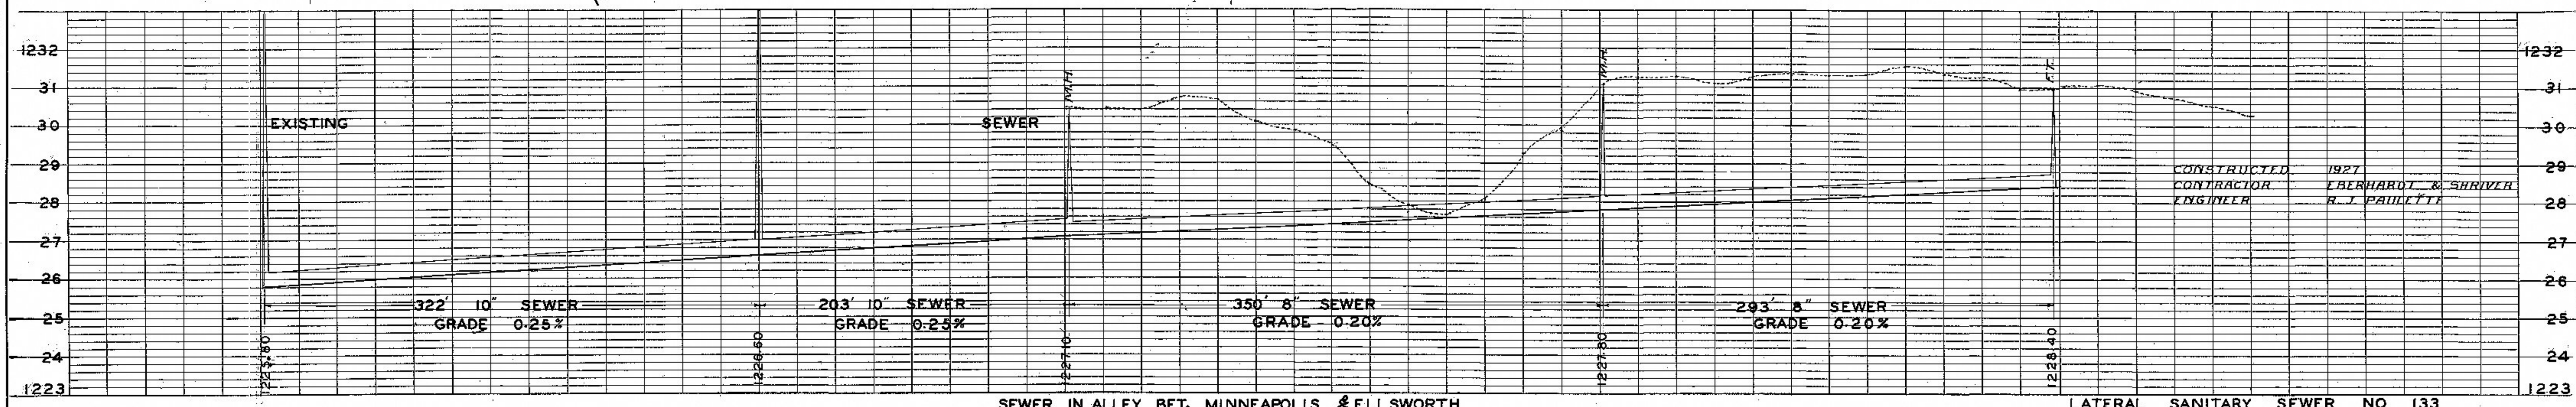


PLAN	NO.
SUPERVISED	DATE
PLOTTED	
ALIGNMENT CHECKED	
RT. OF WAY CHECKED	

B.M. "M" ON HYD. 4TH & MINNEAPOLIS
ELEV. 1234.42 NOTEBOOK NO 28 PAGE 2

PROFILE	DATE
SUPERVISED	
PLOTTED	
GRADES CHECKED	
S.M. NOTED	
STREETS AND NOTATIONS CHECKED	

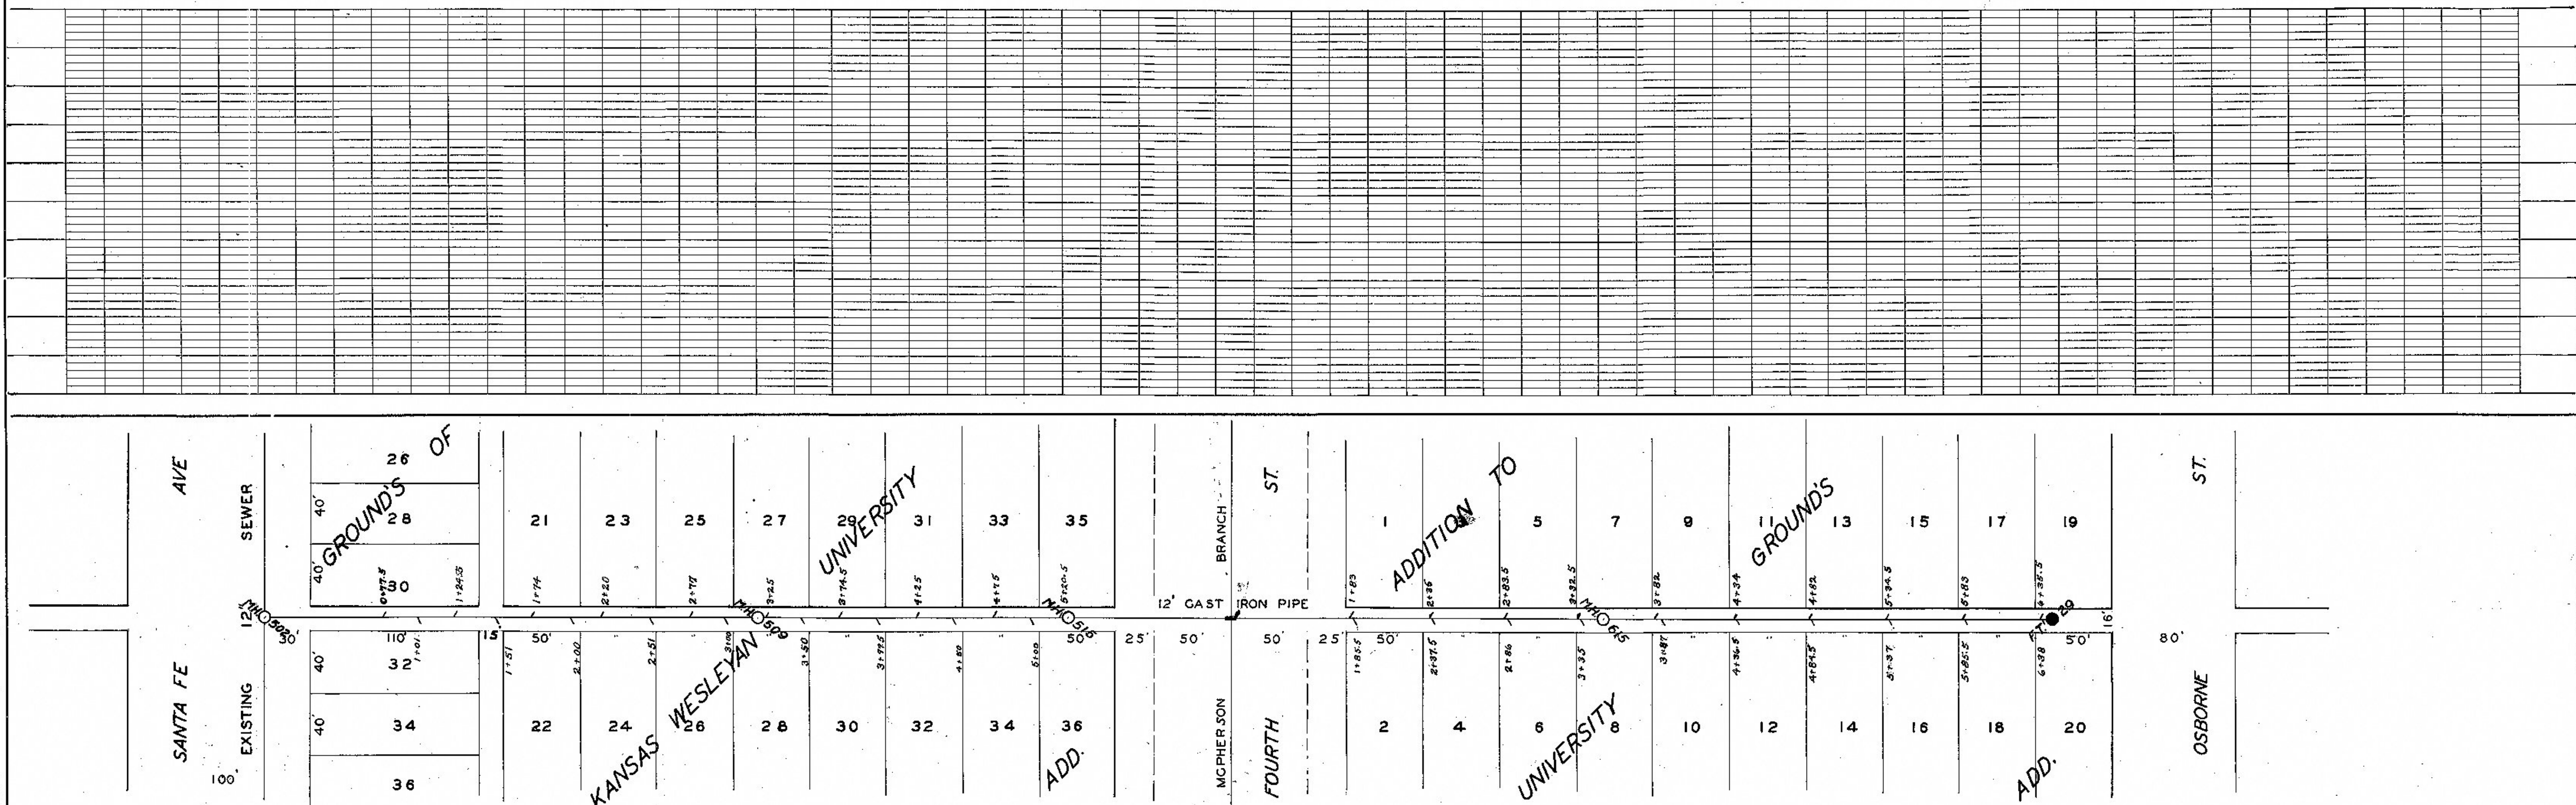

SEWER IN ALLEY BET. MINNEAPOLIS & ELLSWORTH

LATERAL SANITARY SEWER NO 133