
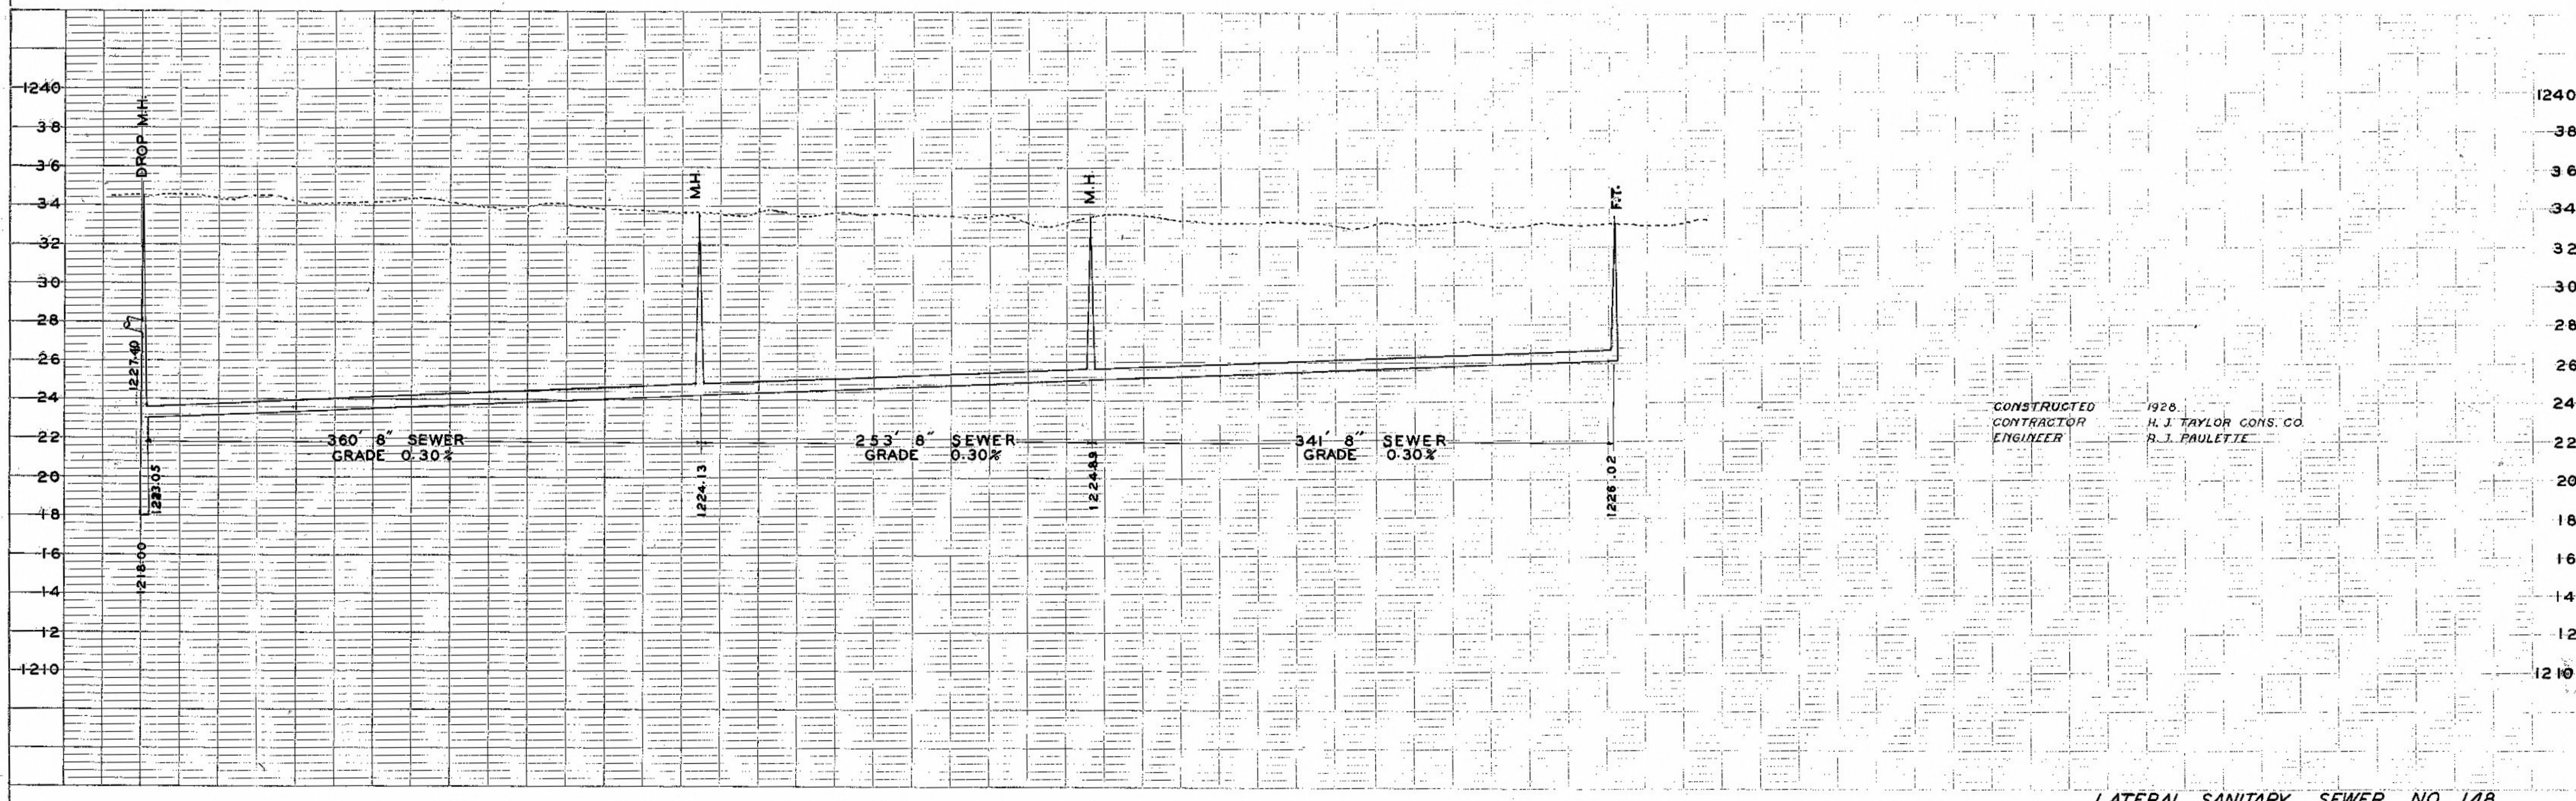


PLAN	SURVEYED	DATE
NOTE BOOK	PLOTTED	BY
ALIGNMENT CHECKED		
PT. OF WAY CHECKED		
NO.		

B.M. - M ON HYD. - SUNSET DRIVE & HIGHLAND CIRCLE ELEV 1235.87

PROFILE	SURVEYED	DATE
NOTE BOOK	PLOTTED	BY
GRADES CHECKED		
STRUCTURE NOTATION CHECKED		
NO. 35		

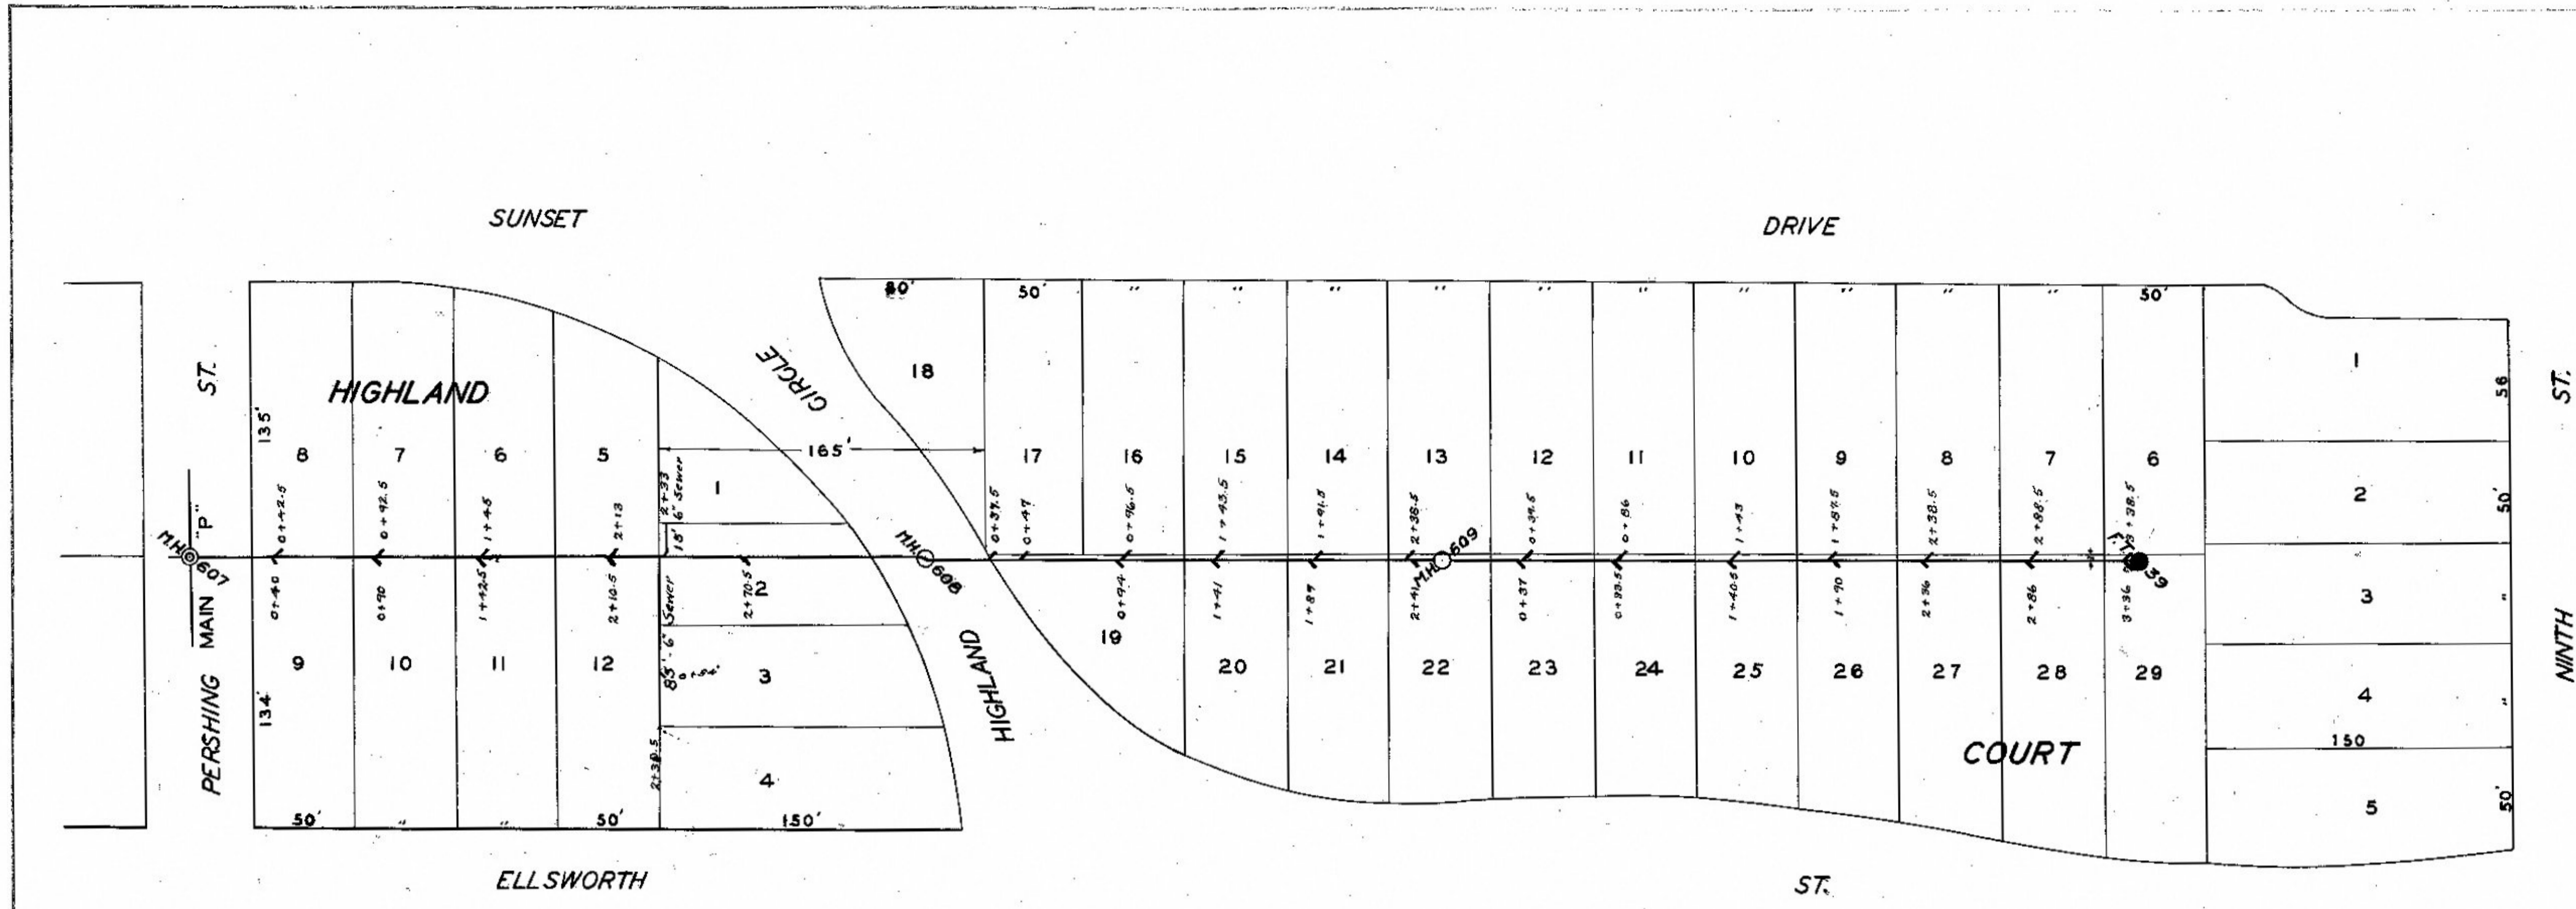

CONSTRUCTED
CONTRACTOR
ENGINEER
1926
H. J. TAYLOR CONS. CO.
R. J. PAULETTE