

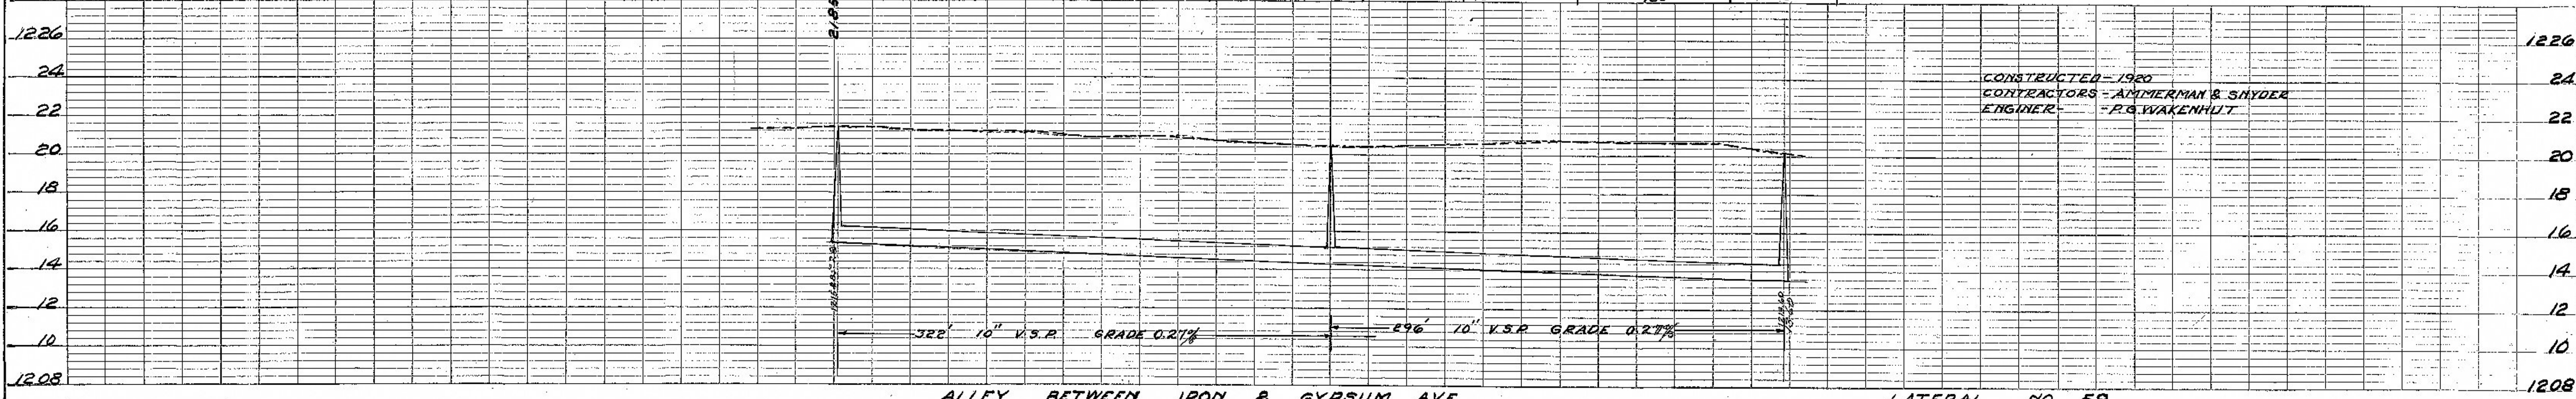
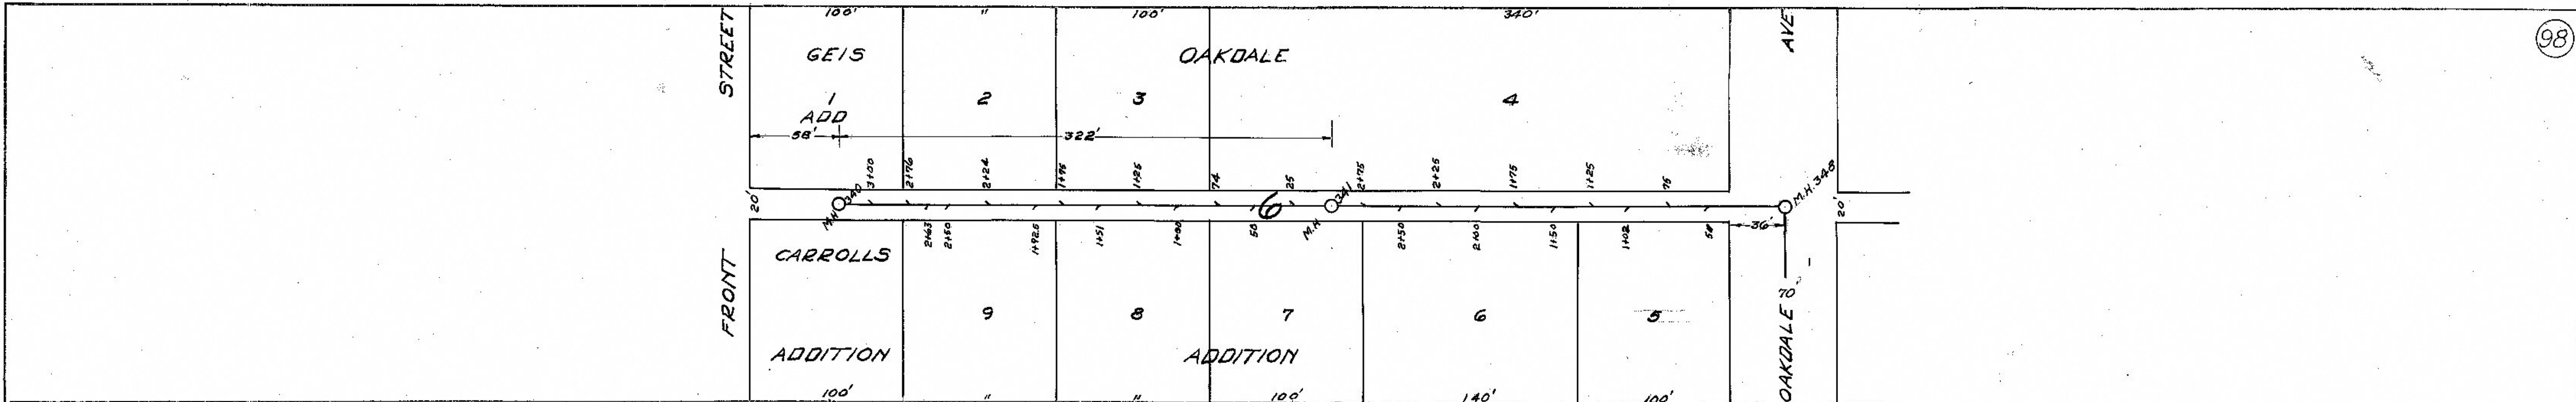


| | |
|-------------------|-----|
| DATE | |
| BY | REN |
| SURVEYED | |
| PLOTTED | |
| ALIGNMENT CHECKED | |
| BY | |
| NOTE BOOK NO. | |
| PLAN | |

| | |
|----------------|-----|
| DATE | |
| BY | REN |
| SURVEYED | |
| PLOTTED | |
| GRADES CHECKED | |
| BY | |
| NOTE BOOK NO. | |
| PROFILE | |

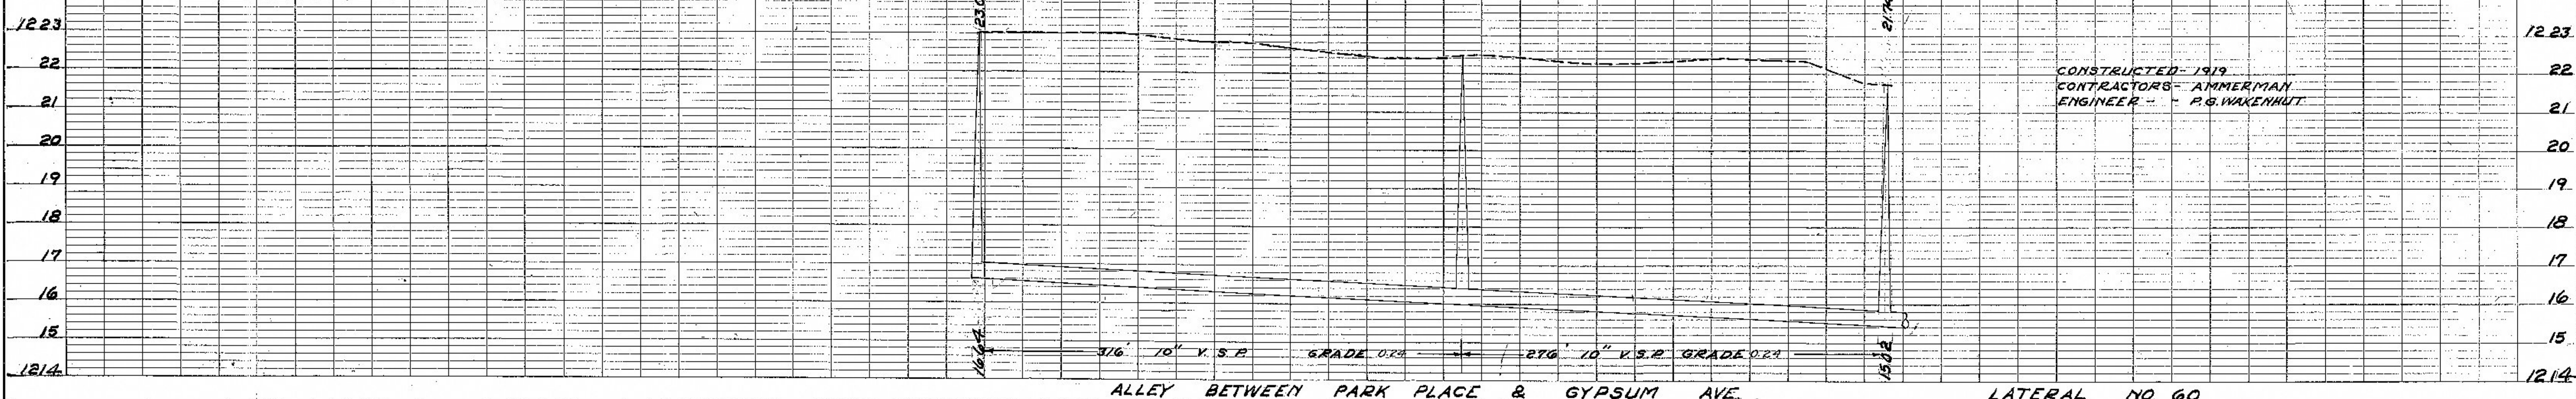

CONSTRUCTED - 1920
 CONTRACTORS - AMMERMAN & SHYDER
 ENGINEER - P.G. WAKENHUT

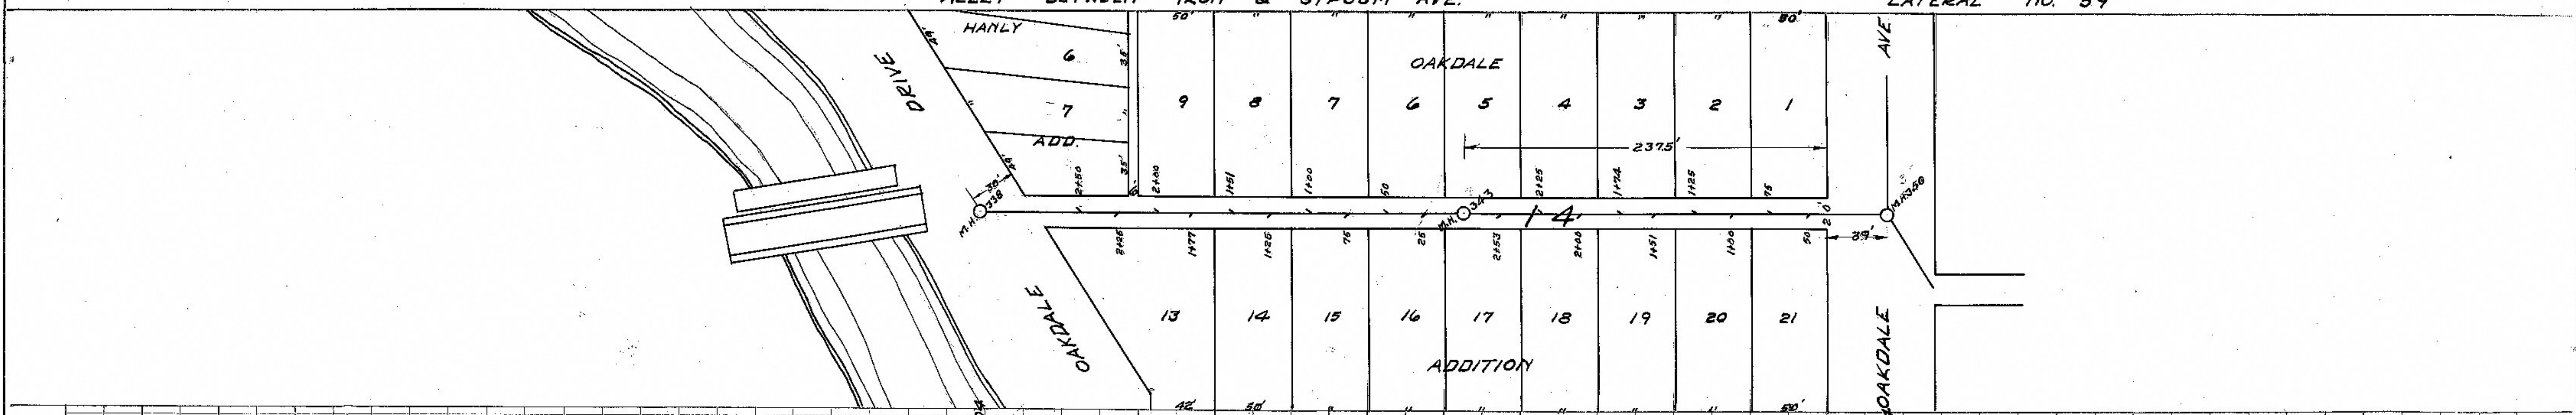

CONSTRUCTED - 1919
 CONTRACTORS - AMMERMAN
 ENGINEER - P.G. WAKENHUT