


PLAN
 SURVEYED
 NOTE ROCK ALIGNMENT CHECKED
 NO. 101
 HEB



PROFILE
 SURVEYED
 NOTE ROCK GRADES OBTAINED
 B.M.S. NOTED
 STRUCTURE NOTED
 NO. 101
 HEB

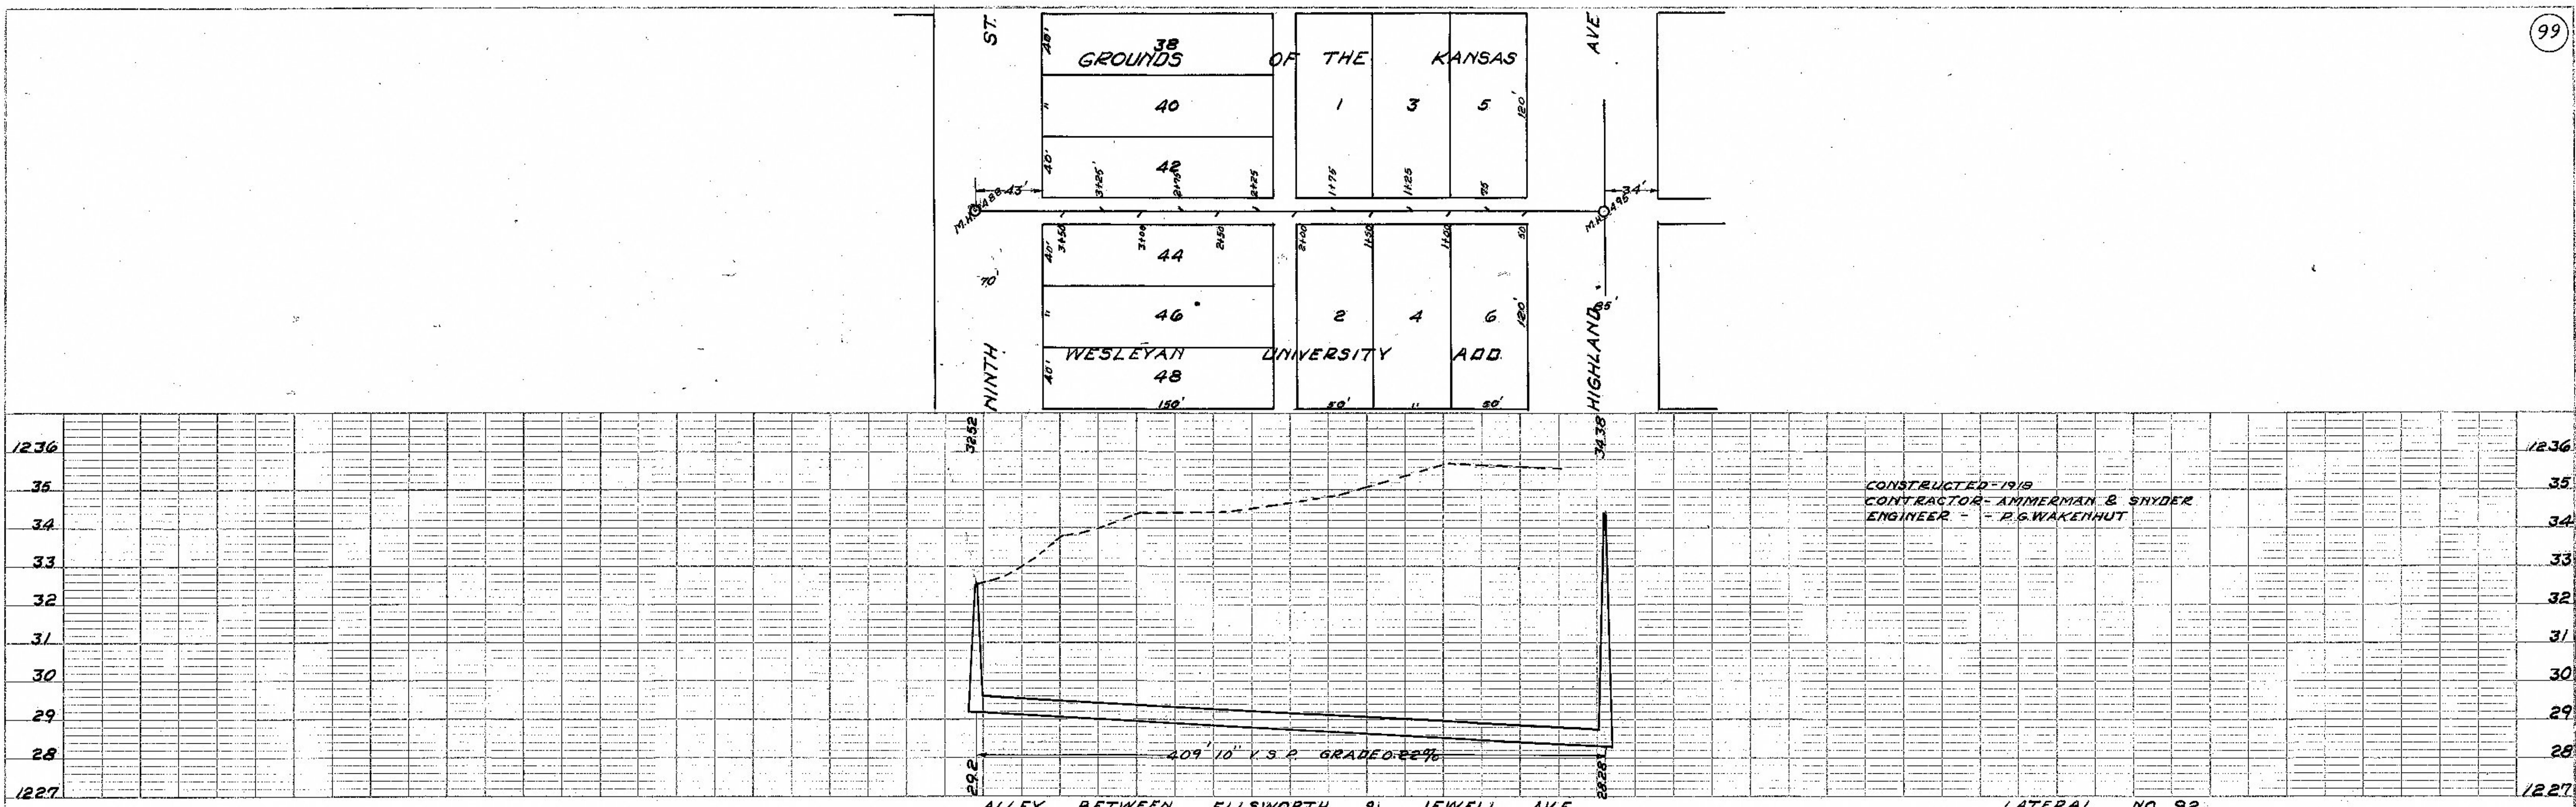