

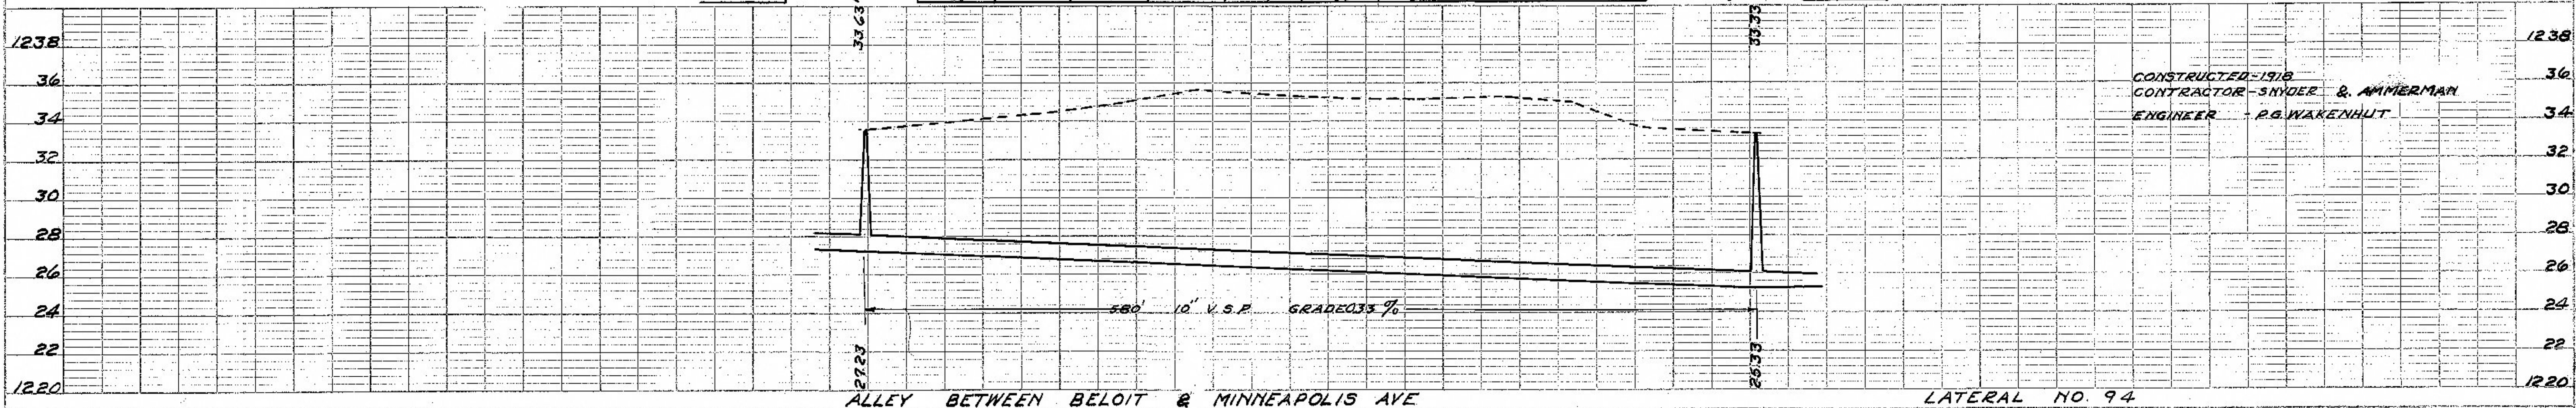
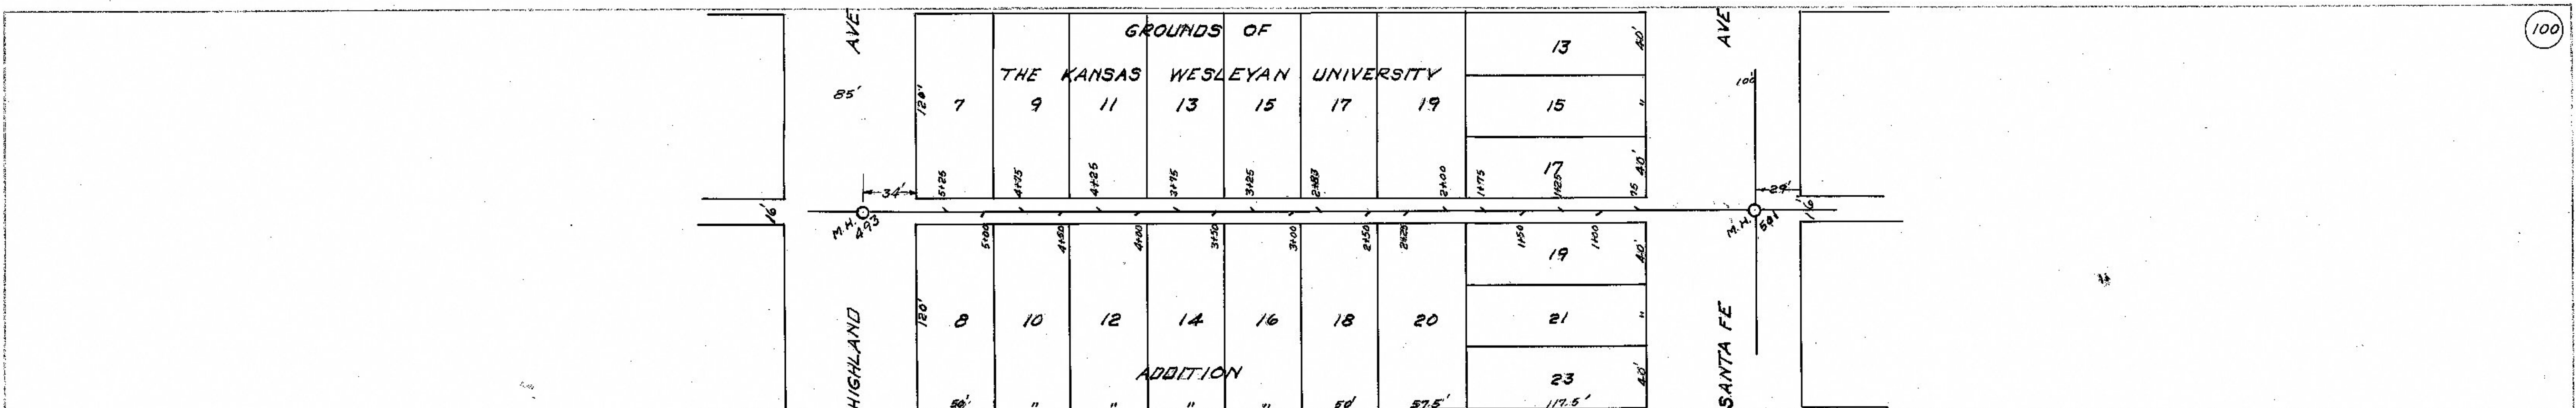


PLAN
SURVEYED BY
NOTE BOOK NO.
ALIGNED CHECKED
RT. OF WAY CHECKED

PROJECT
SURVEYED BY
NOTE BOOK NO.
S.M.E. NOTED
SPECIALTY BOARD NO. C.

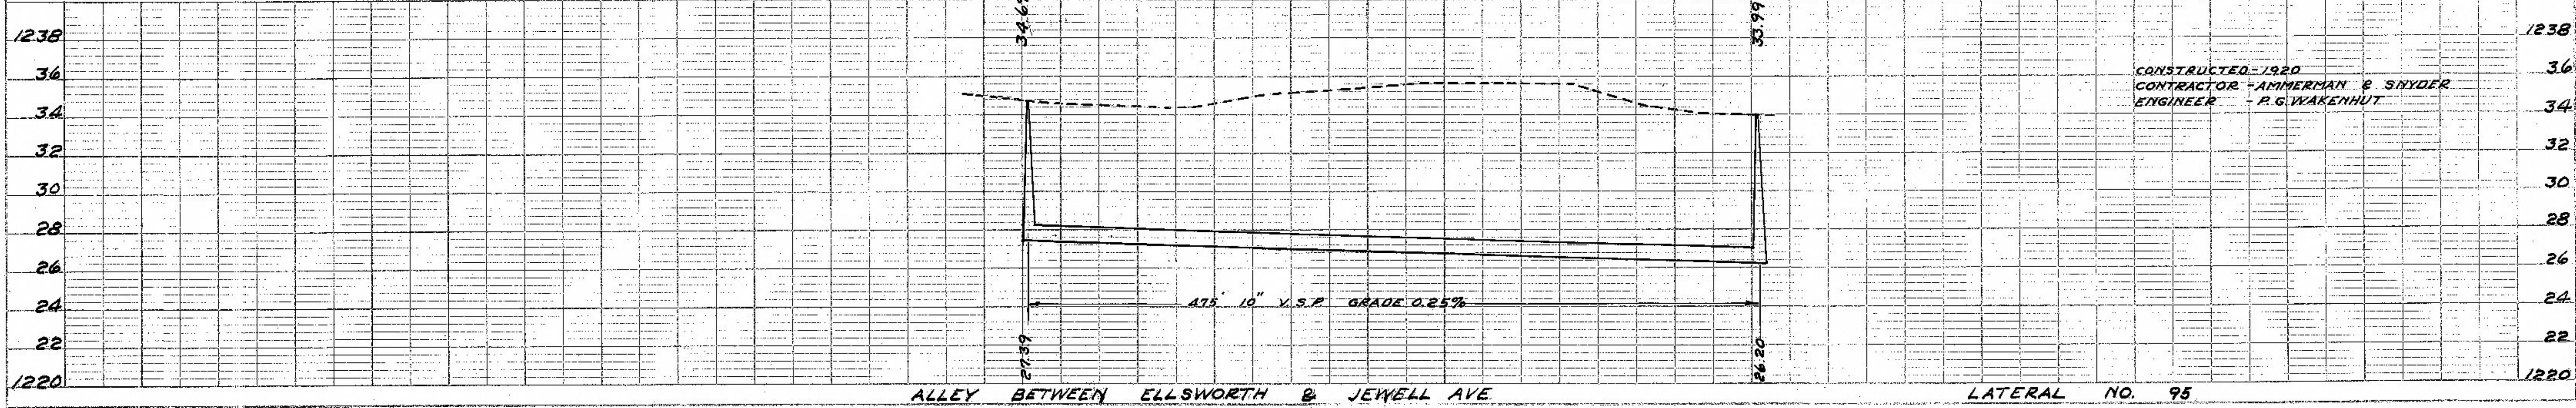

CONSTRUCTED-1918
CONTRACTOR-SNYDER & AMMERMAN
ENGINEER - P.G. WAKENHUT

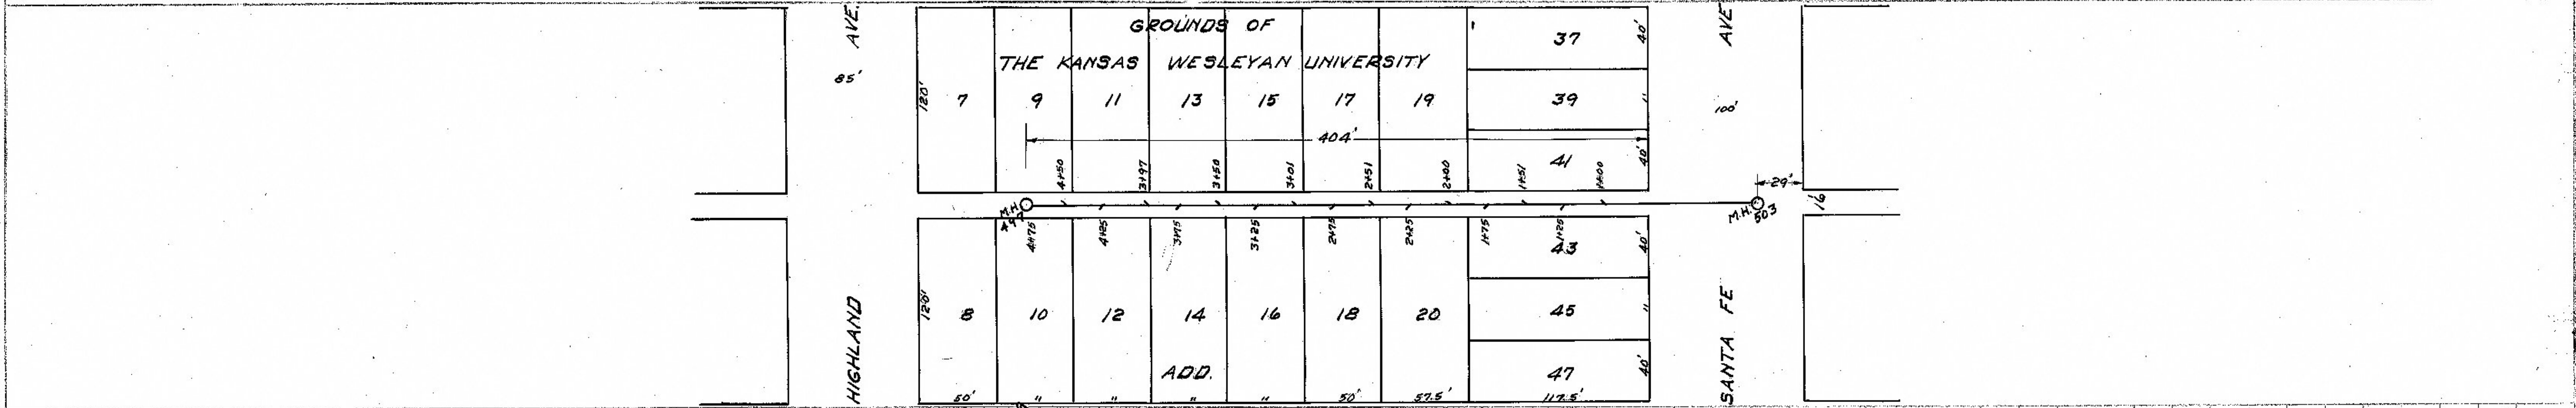

CONSTRUCTED-1920
CONTRACTOR-AMMERMAN & SNYDER
ENGINEER - P.G. WAKENHUT