
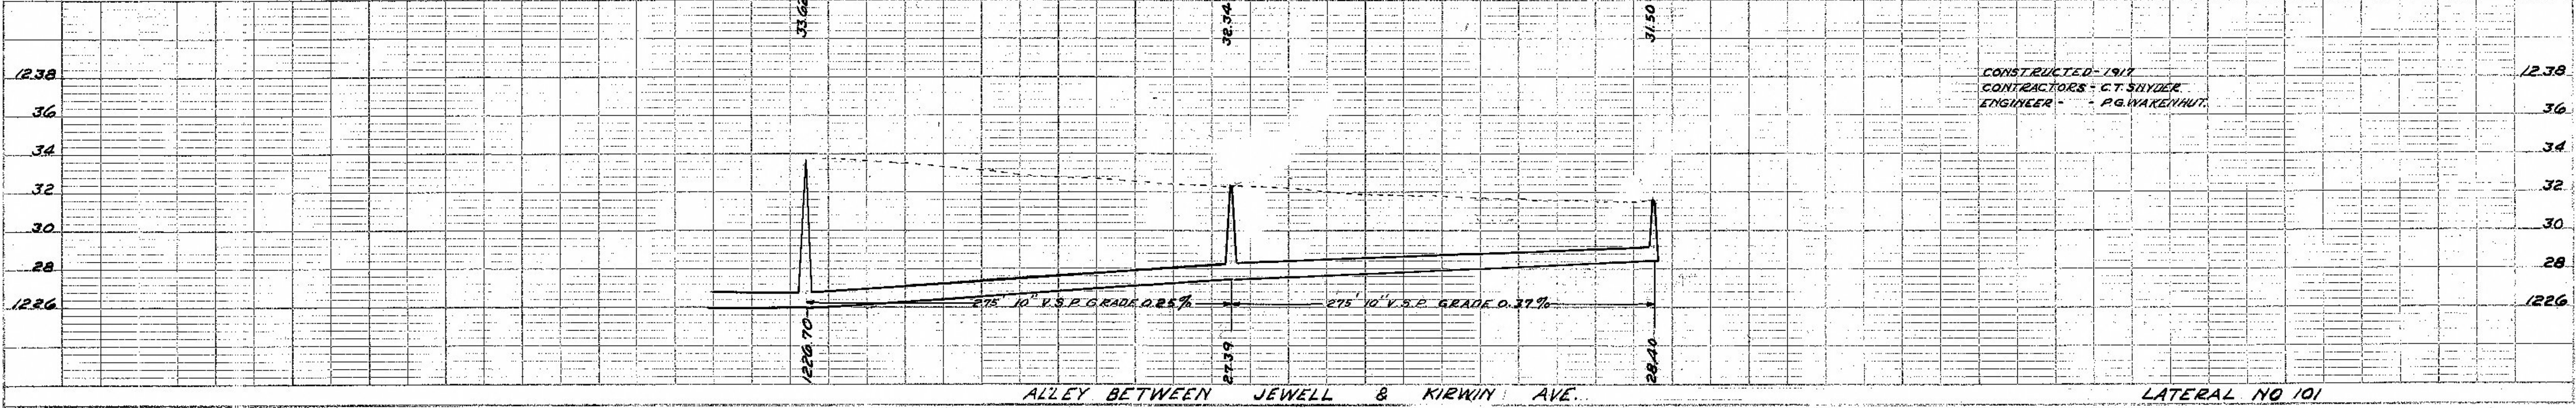
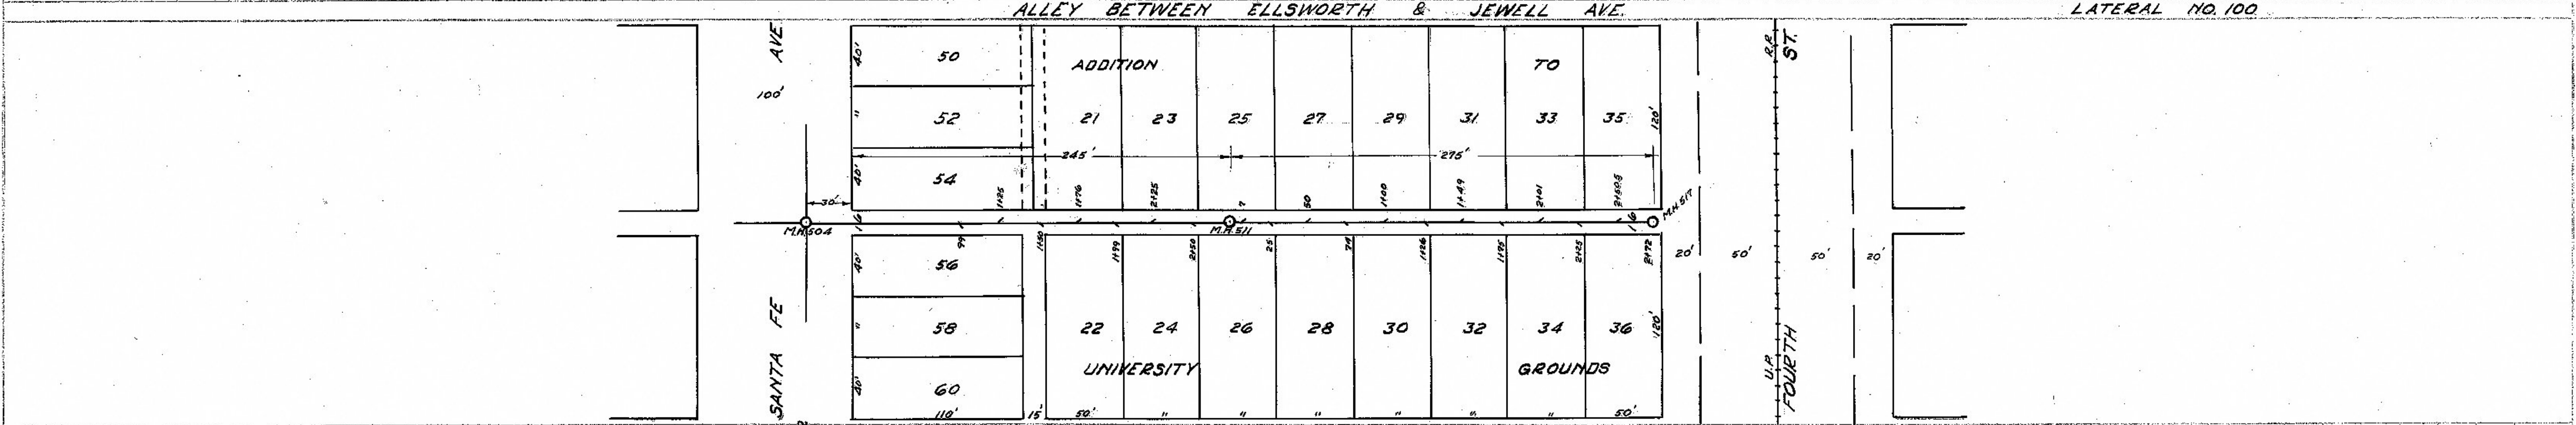
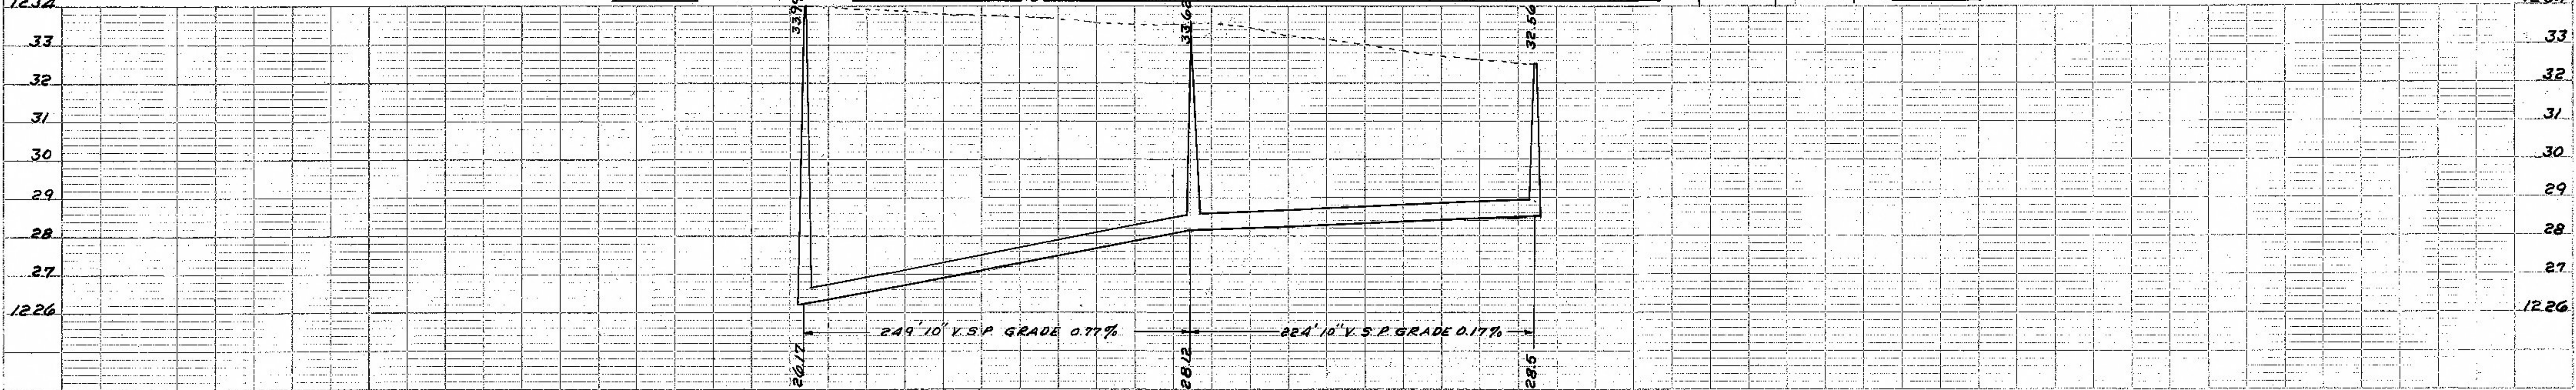


PLAN  
 SURVEYED  
 GRADES CHECKED  
 ALGEBRAICALLY  
 CHECKED  
 RT. OF WAY CHECKED  
 H.E.B.  
 R.E.B.

PROFILE  
 SURVEYED  
 GRADES CHECKED  
 S.M.E. NOTED  
 STR. GRADES AS SHOWN  
 H.E.B.  
 R.E.B.

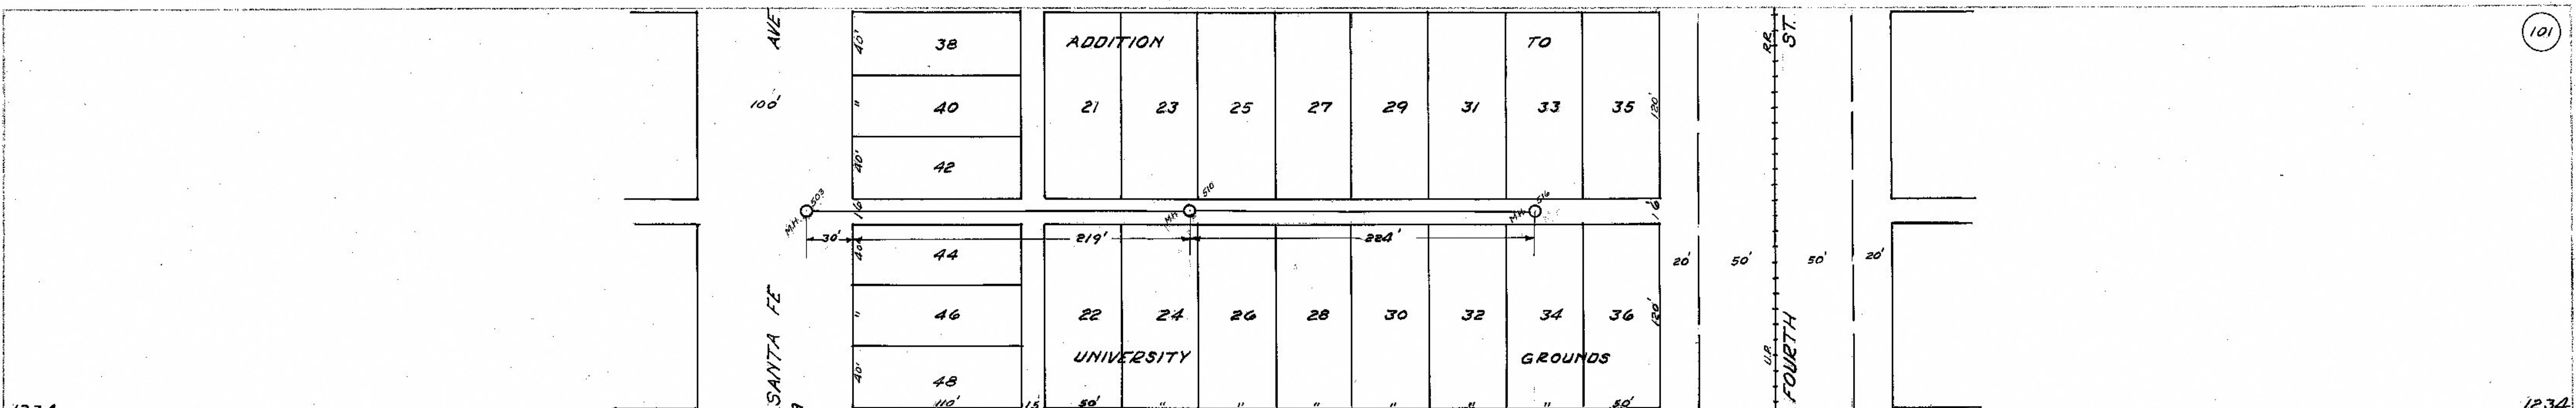

CONSTRUCTED - 1911  
 CONTRACTORS - C.T. SNYDER  
 ENGINEER - P.G. WAKENHUT