
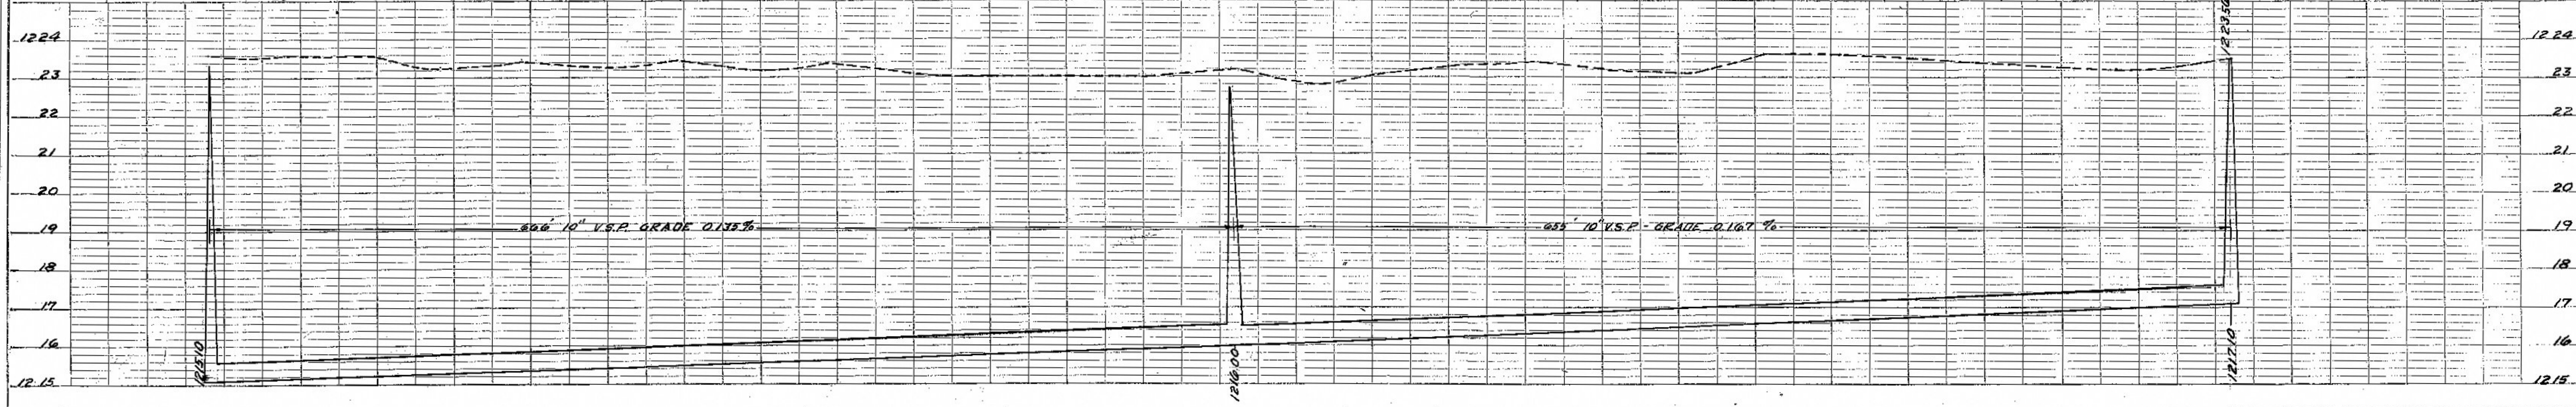




DATE: _____ BY: **R.E.B.**

PLAN
 SURVEY: _____
 NOTE BOOK: _____
 ALIGNMENT CHECKED: _____
 E.T. OF WAY CHECKED: _____
 NO. _____

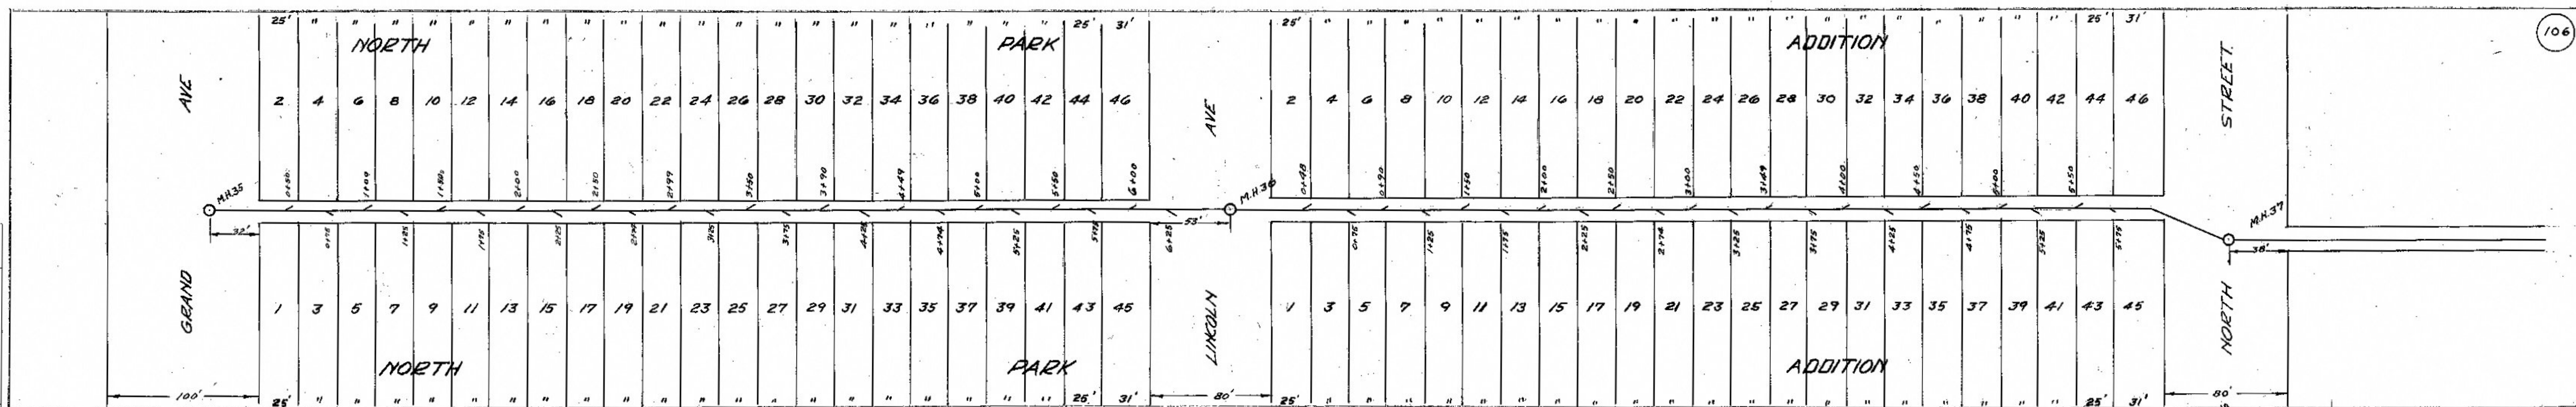

DATE: _____ BY: _____

PROFILE
 SURVEY: _____
 NOTE BOOK: _____
 GRACES CHECKED: _____
 E.T. OF WAY CHECKED: _____
 STRUCTURE NOTATIONS CHKD: _____

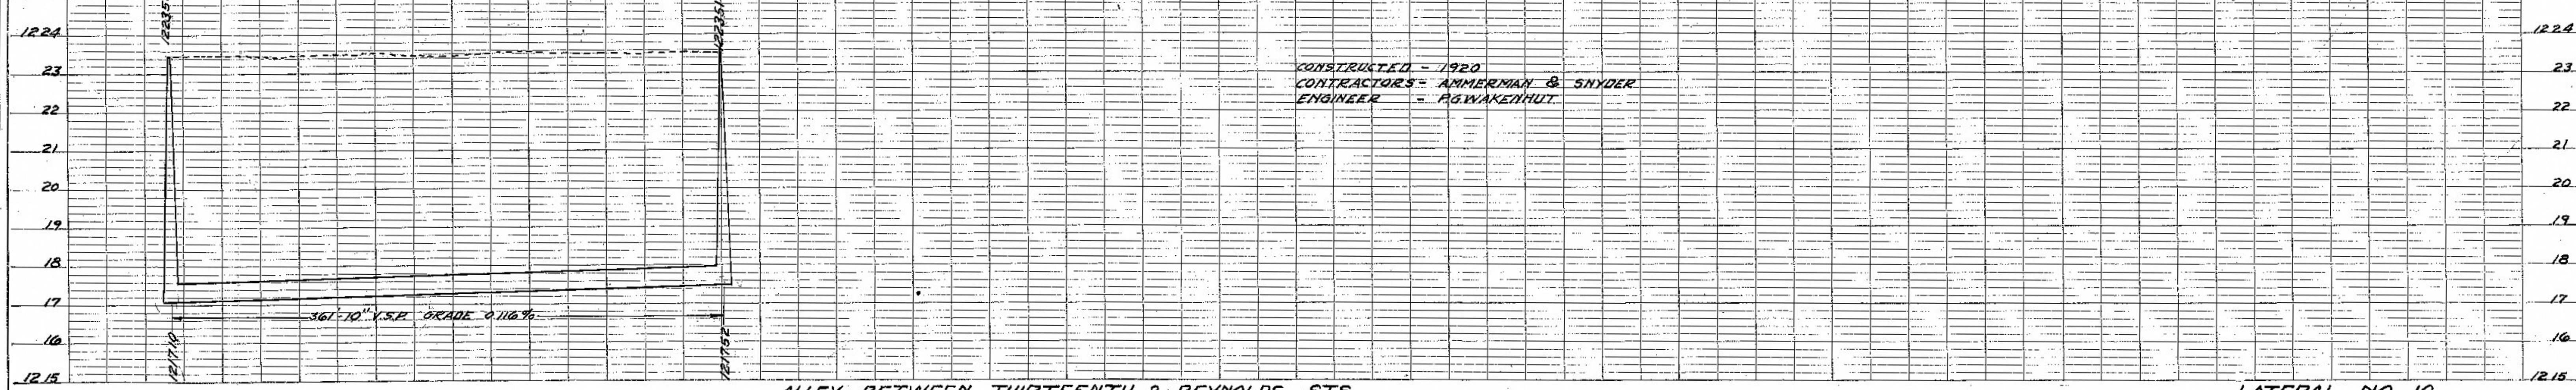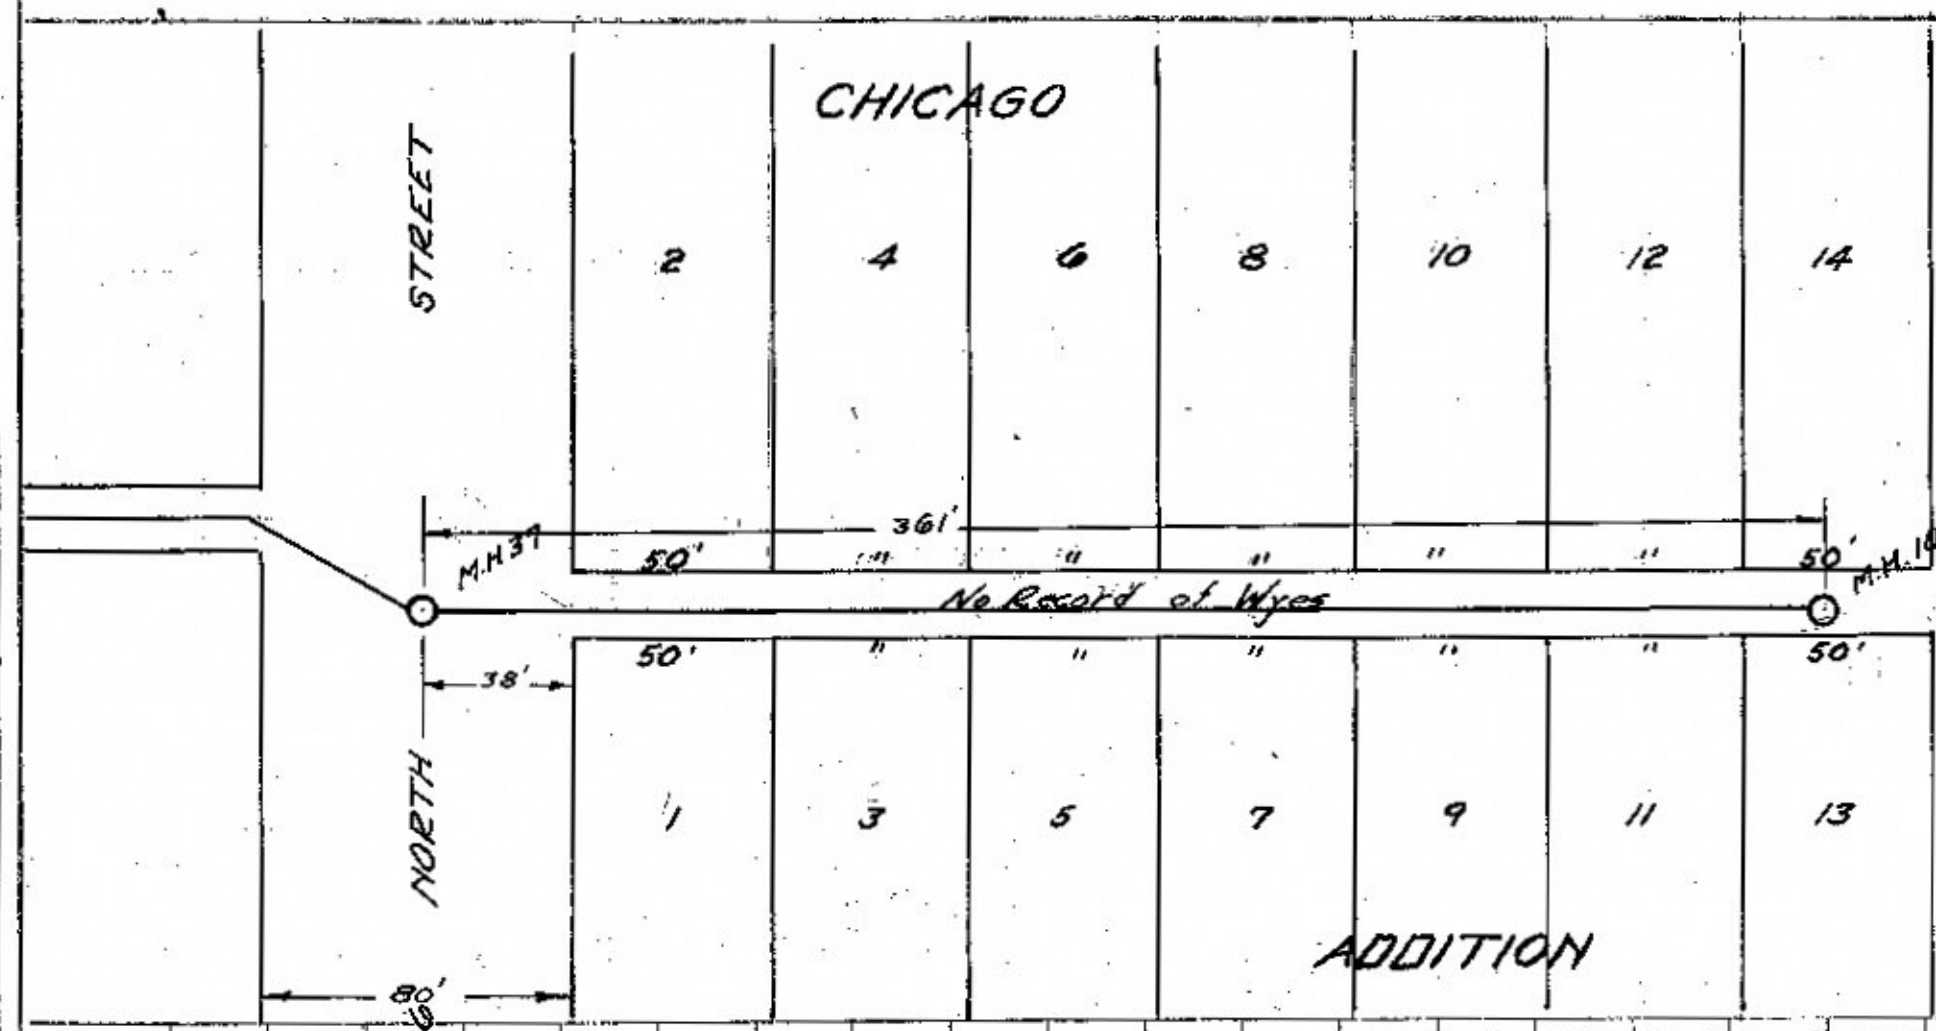

CONSTRUCTED - 1920
 CONTRACTORS - AMMERMAN & SNYDER
 ENGINEER - P.G. WAKENHUT

ALLEY BETWEEN THIRTEENTH & REYNOLDS STS

LATERAL NO 10