
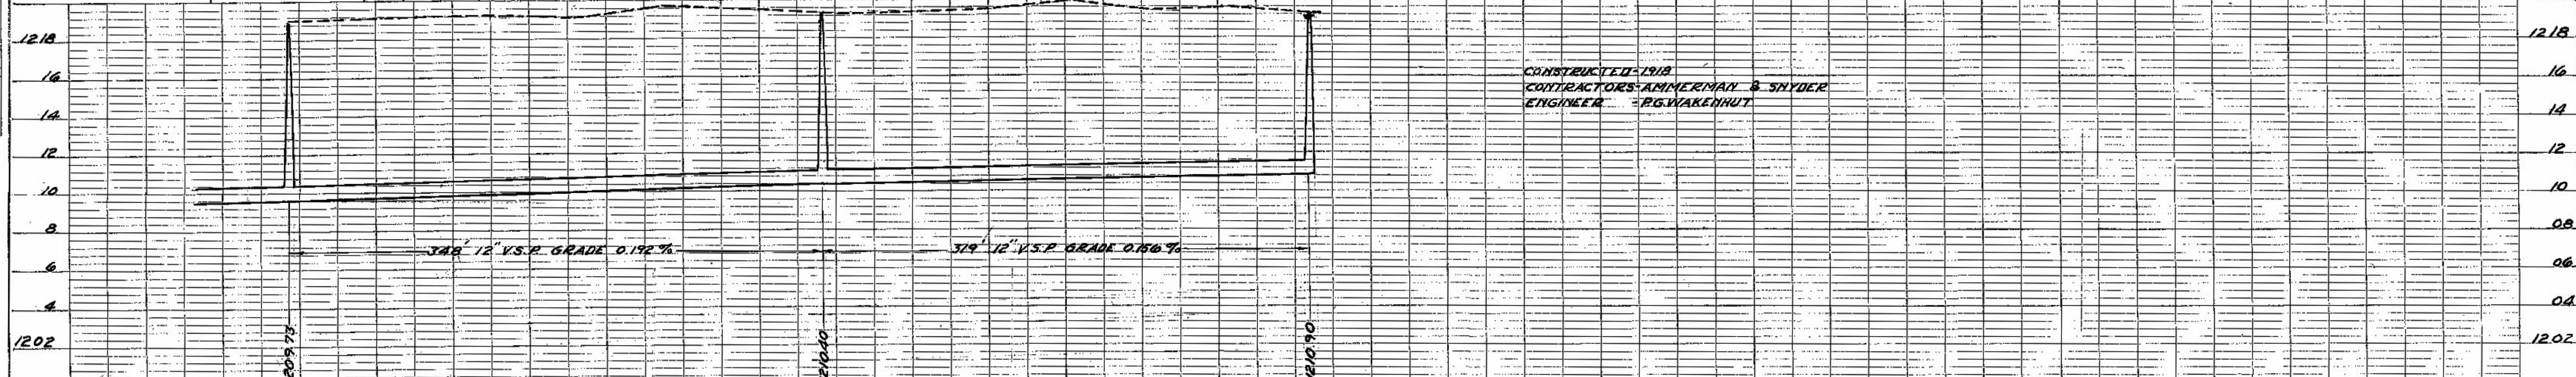
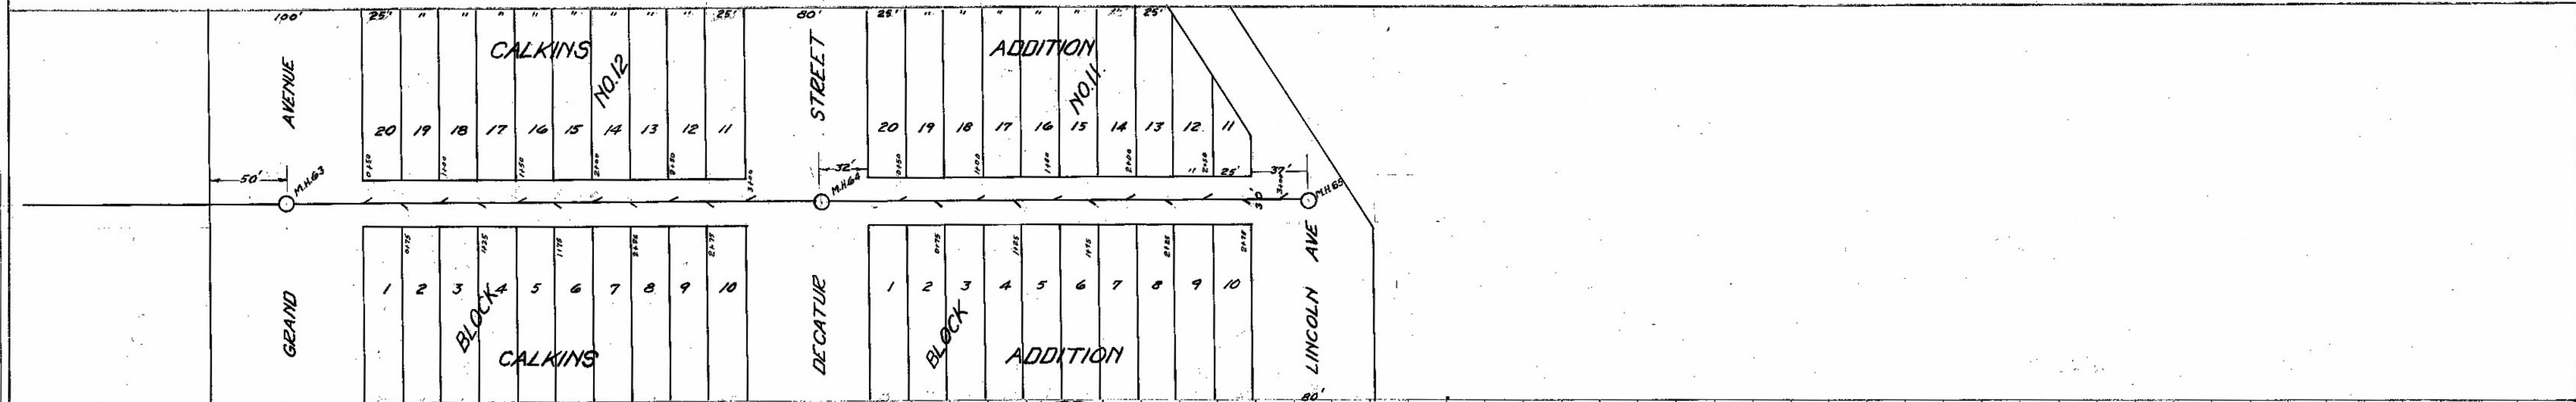
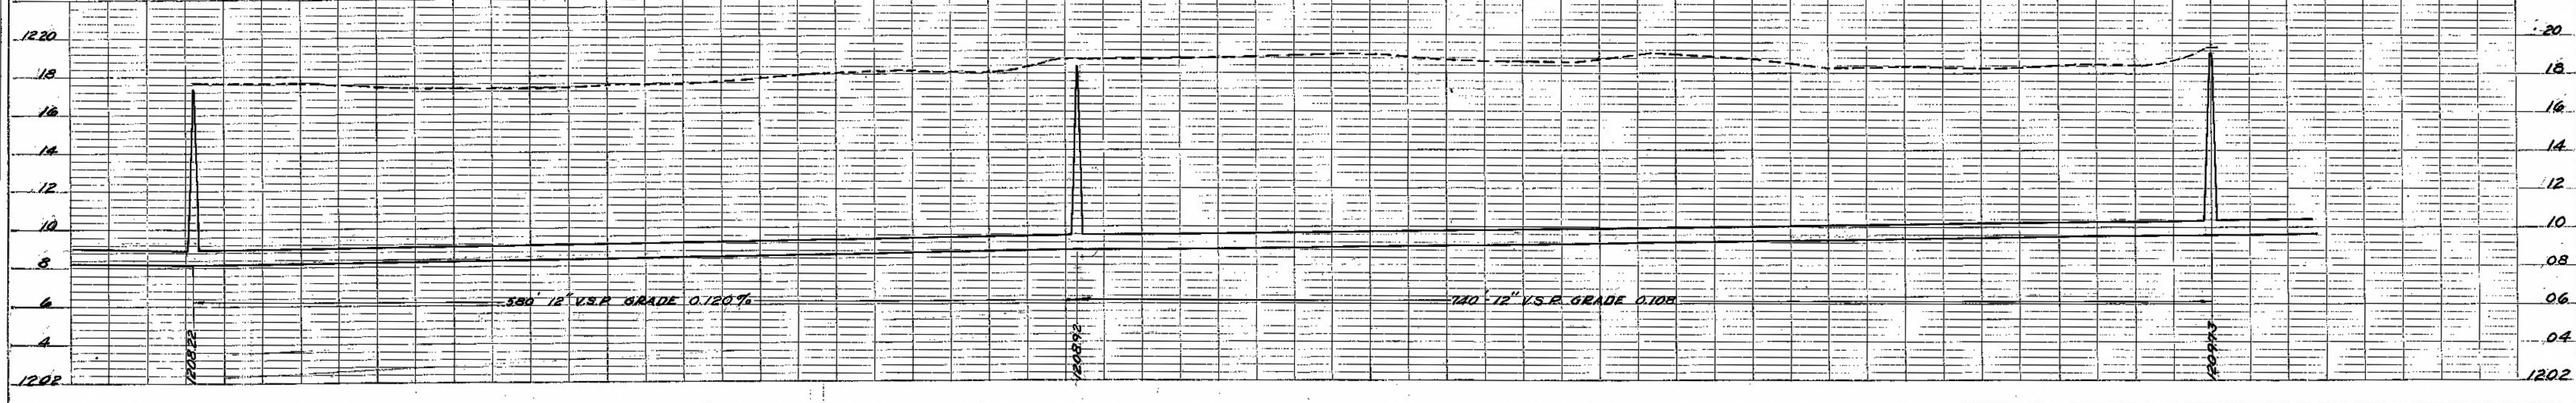


DATE	
BY	
SURVEYED	
PLANNED	
NOTED	
NOTE BOOK	
NO.	

DATE	
BY	
SURVEYED	
PLANNED	
NOTED	
NOTE BOOK	
NO.	

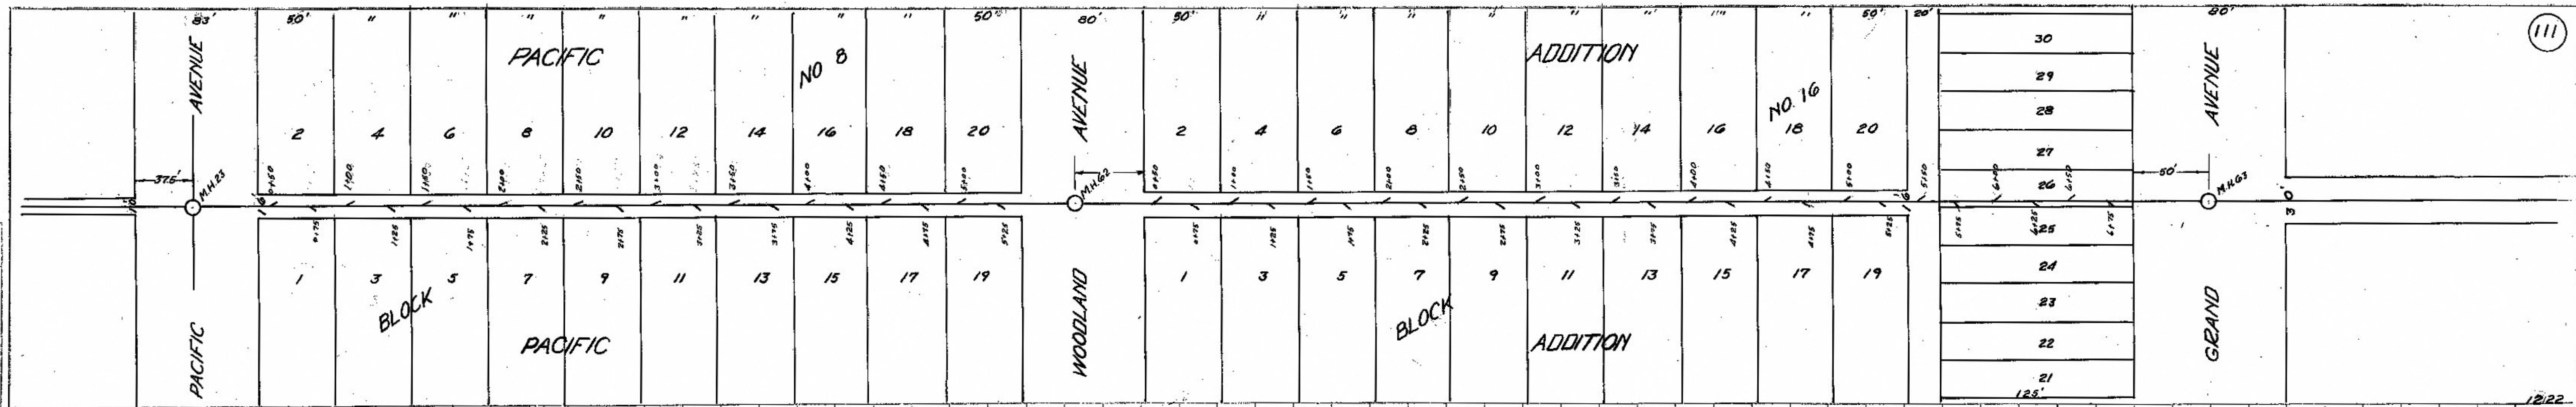

CONSTRUCTED 1918
 CONTRACTORS AMMERMAN & SNYDER
 ENGINEER R.G. WAREHOUT

ALLEY BETWEEN SANTA FE & FIFTH

LATERAL NO 21