



FILED 5-21 1928

DATE 5-21-28
BY L.M.S.
C.M.E.

PLAN SURVEYED, PLOTTED, ALIGNED, CHECKED, RT. OF WAY CHECKED.
NOTE BOOK NO. 36

CITY CLERK
APPROVED BY COMMISSIONERS
5-21-28

PROFILE SURVEYED, PLOTTED, GRADES CHECKED, B.M. NOTED, STRUCTURE NOTATION COR'D

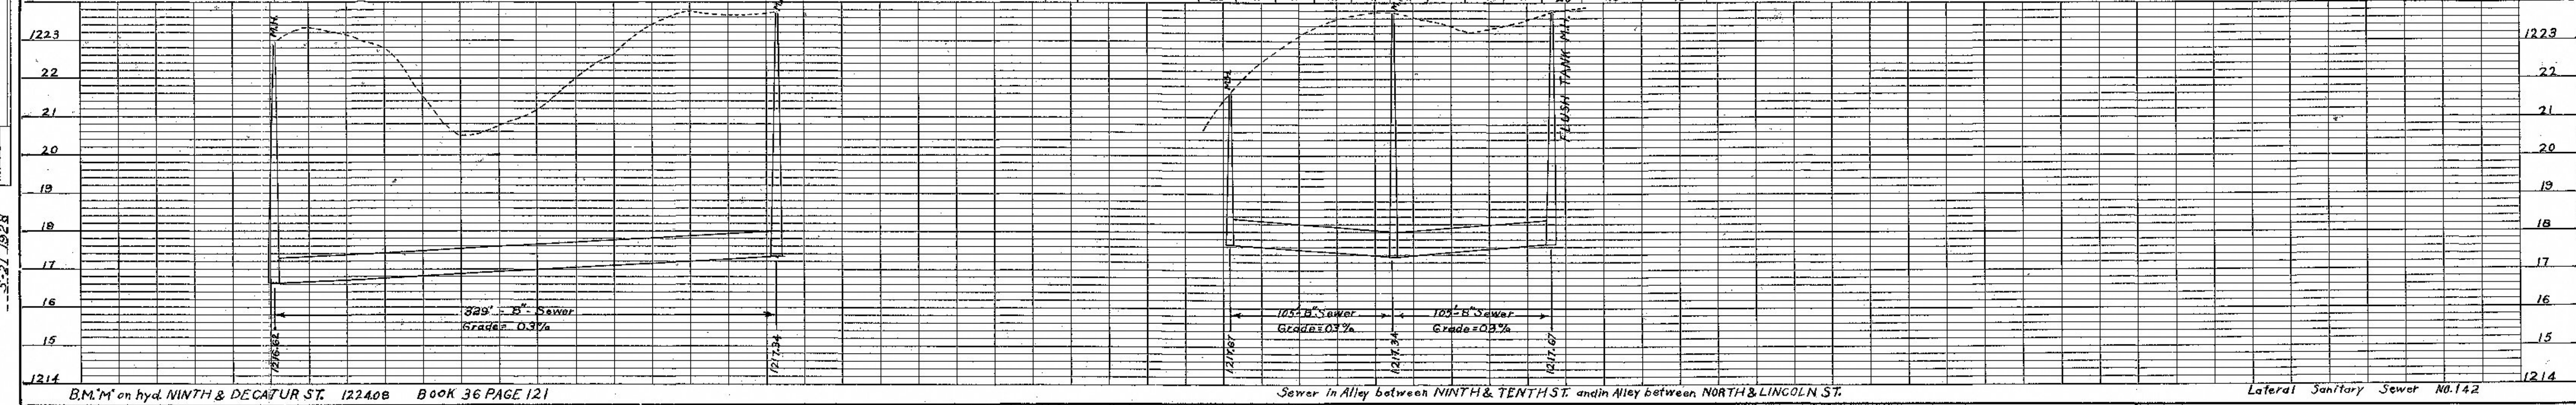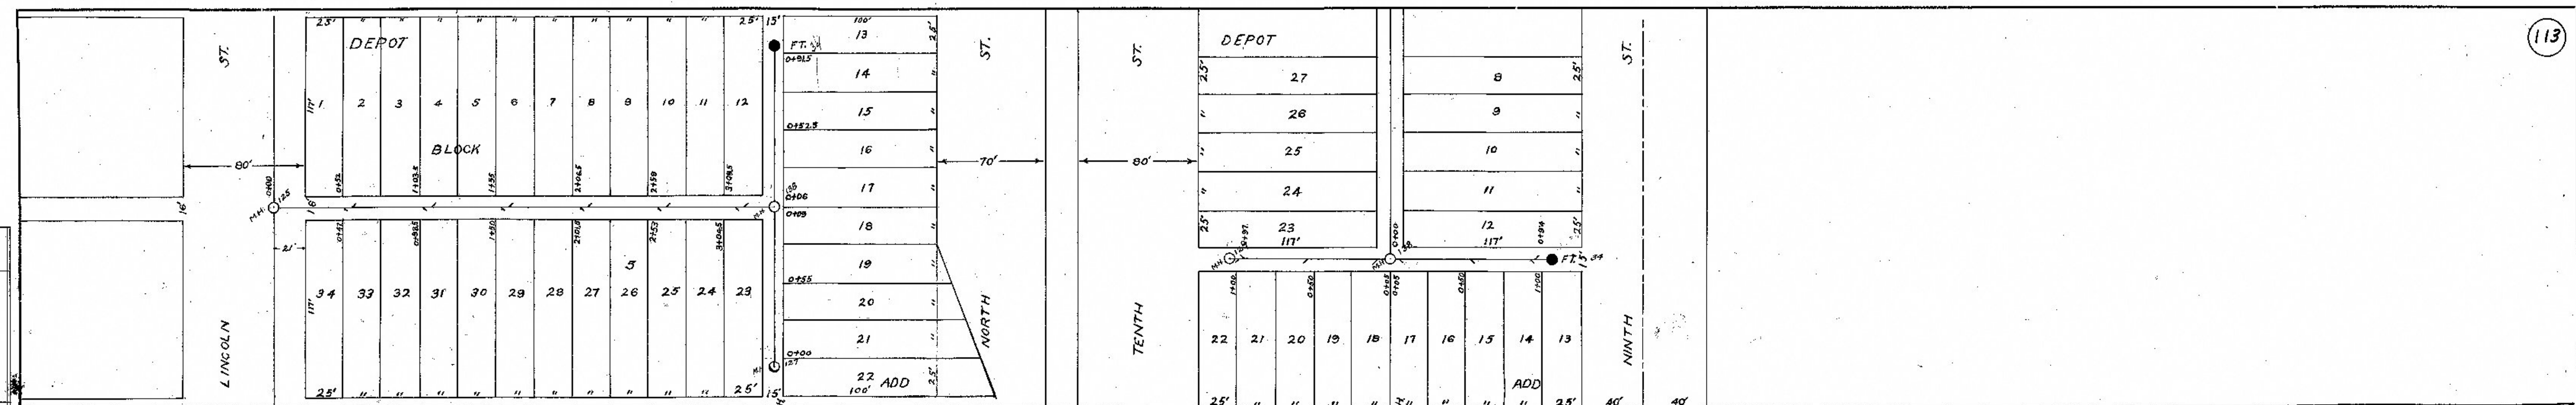

B.M. 'M' on hyd. NINTH & DECATUR ST. 122408 BOOK 36 PAGE 121

Sewer in Alley between NINTH & TENTH ST. and in Alley between NORTH & LINCOLN ST.

Lateral Sanitary Sewer NO. 142