



PLAN
 SURVEYED BY I. M. S.
 PLOTTED BY M. S. G.
 CHECKED BY M. S. G.
 NO. 122
 DATE 1/21/30

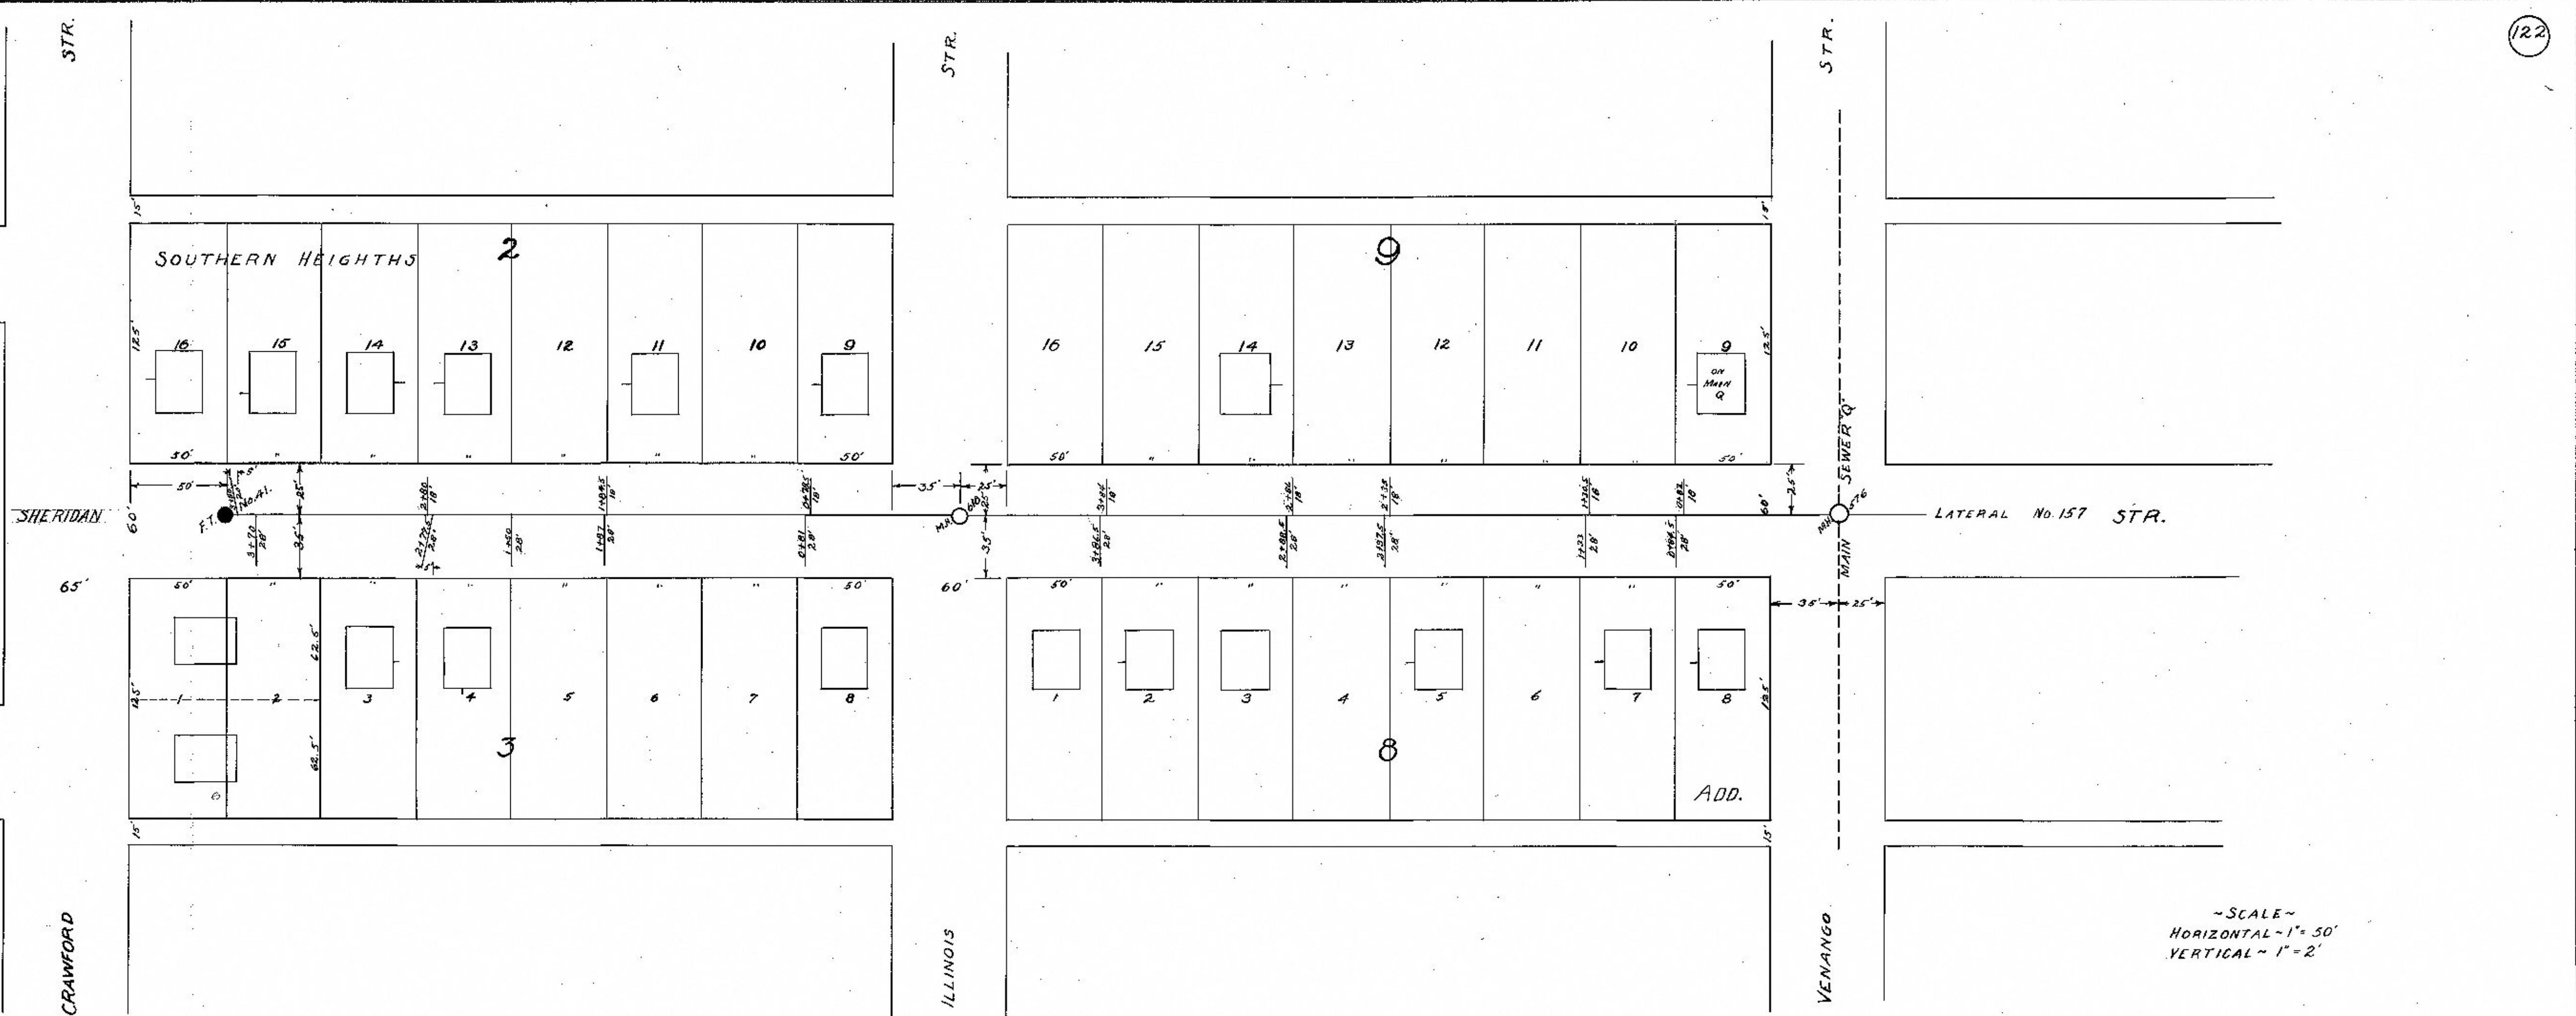

SCALE -
 HORIZONTAL - 1" = 50'
 VERTICAL - 1" = 2'

PROFILE
 SURVEYED BY L. M. SACK
 PLOTTED BY M. S. GOODWIN
 CHECKED BY M. S. GOODWIN
 NO. 122
 DATE 6/12/30

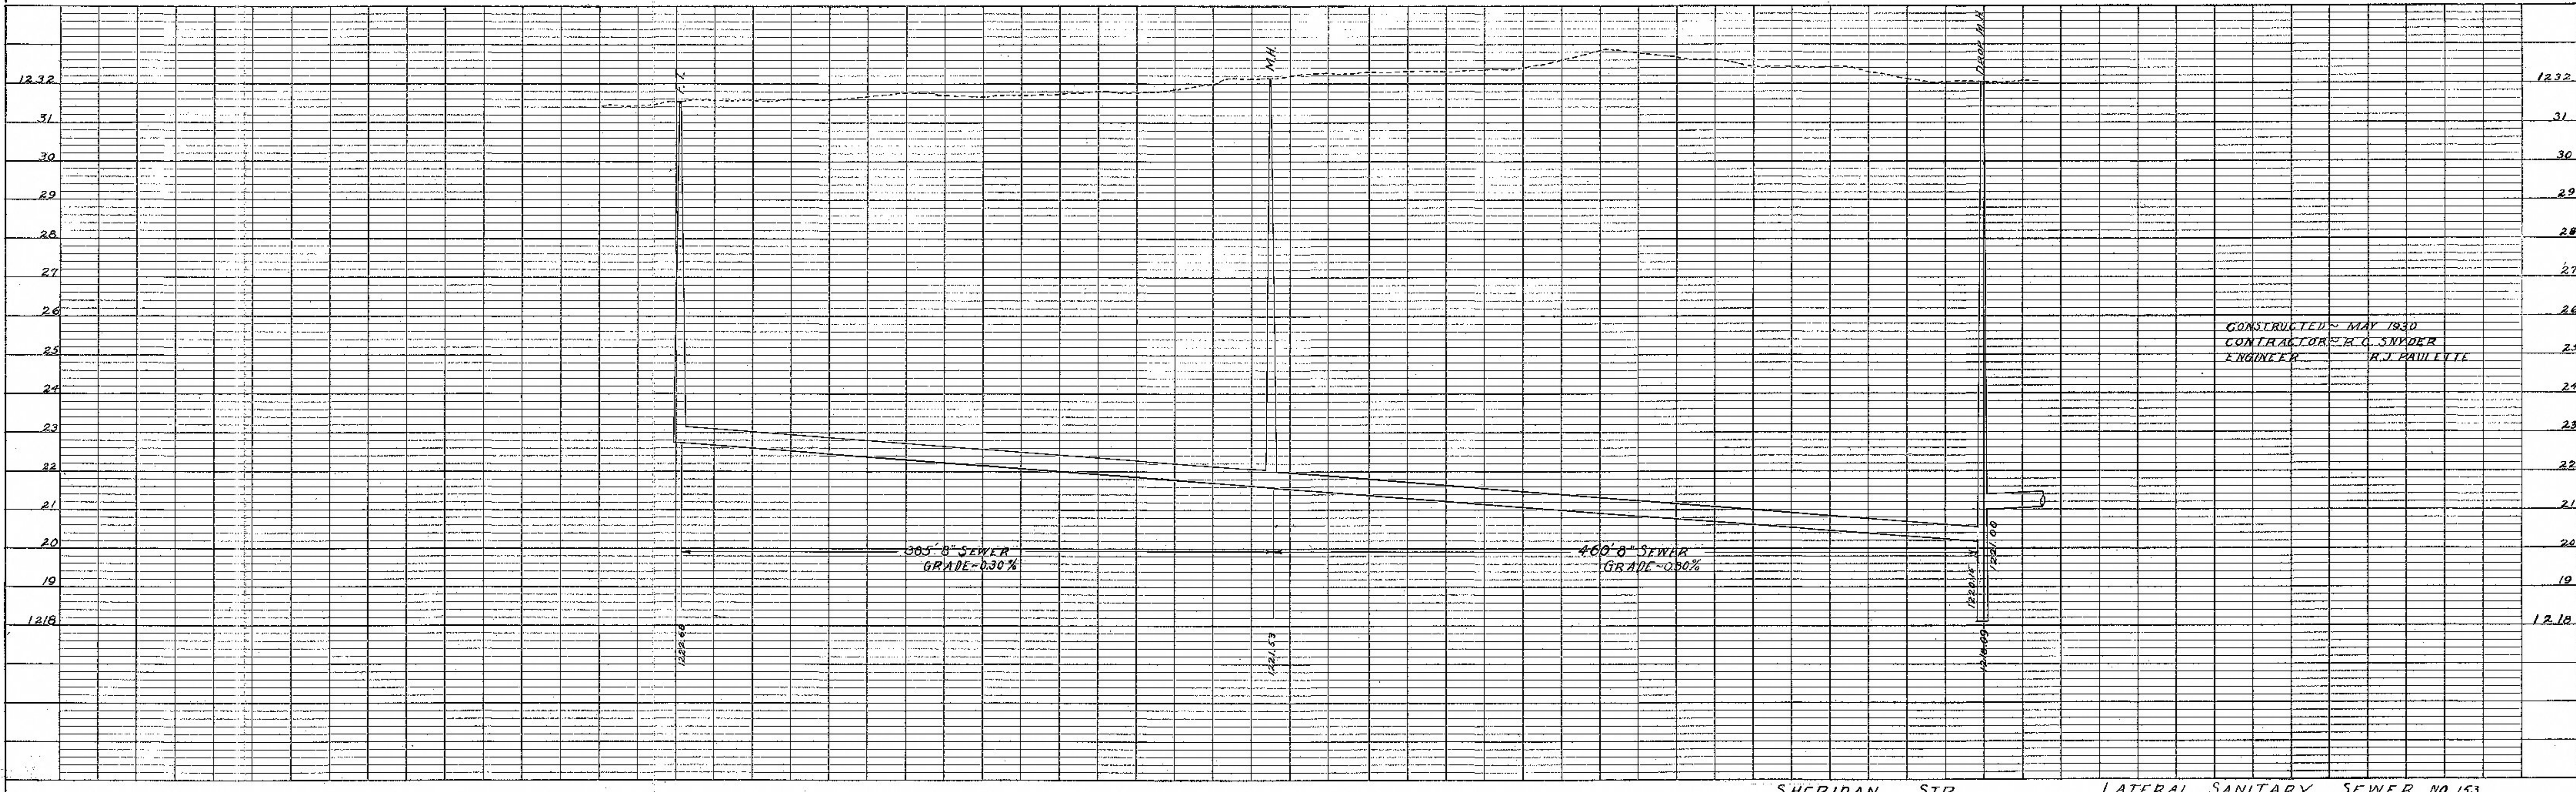

CONSTRUCTED - MAY 1930
 CONTRACTOR - E. C. SNYDER
 ENGINEER - R. J. PAULYTT