
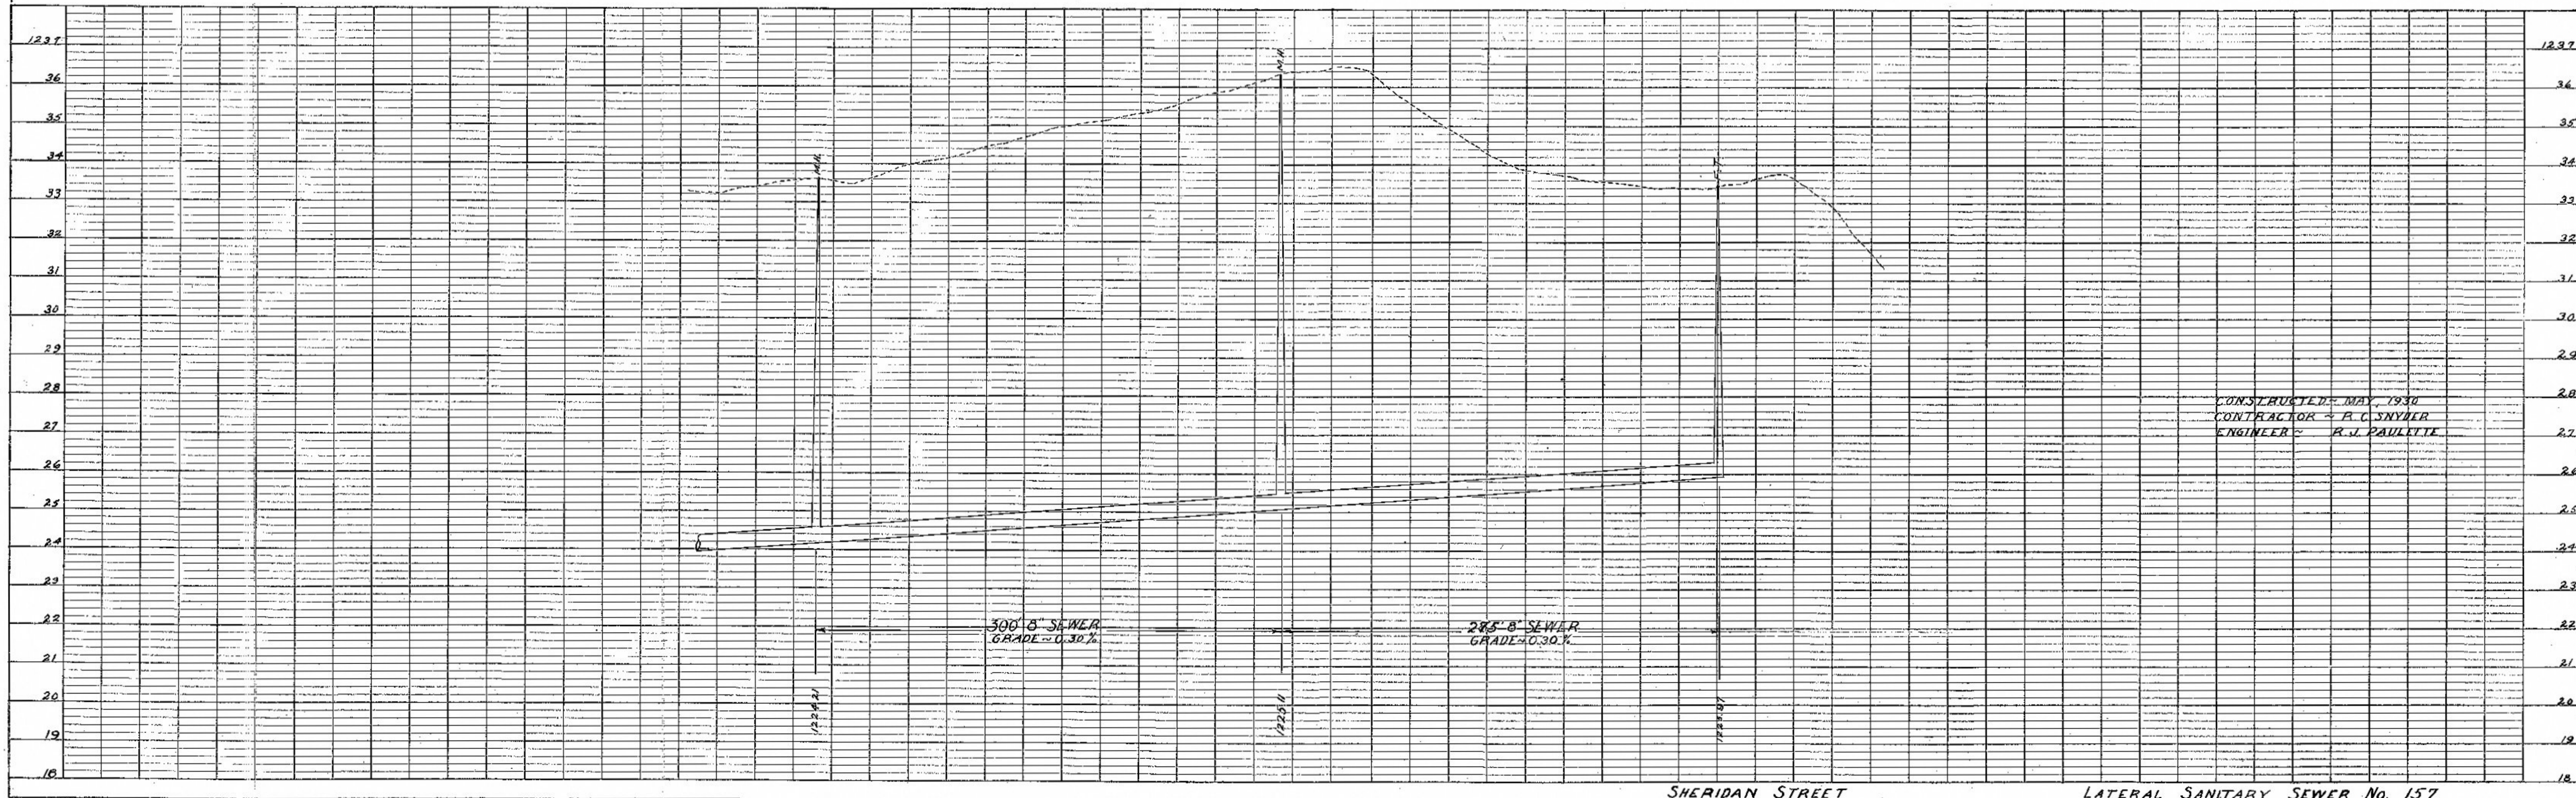


DATE: _____
 SURVEYED BY: _____
 PLAN NO. _____
 NOTE BOOK _____
 ALIGNMENT CHECKED _____
 RT. OF WAY CHECKED _____
 Page 12

DATE: 5/15/30
 SURVEYED BY: L. M. SPACK
 PROFILE NO. _____
 NOTE BOOK _____
 GRADES CHECKED _____
 STRUCTURE NOTATIONS: _____

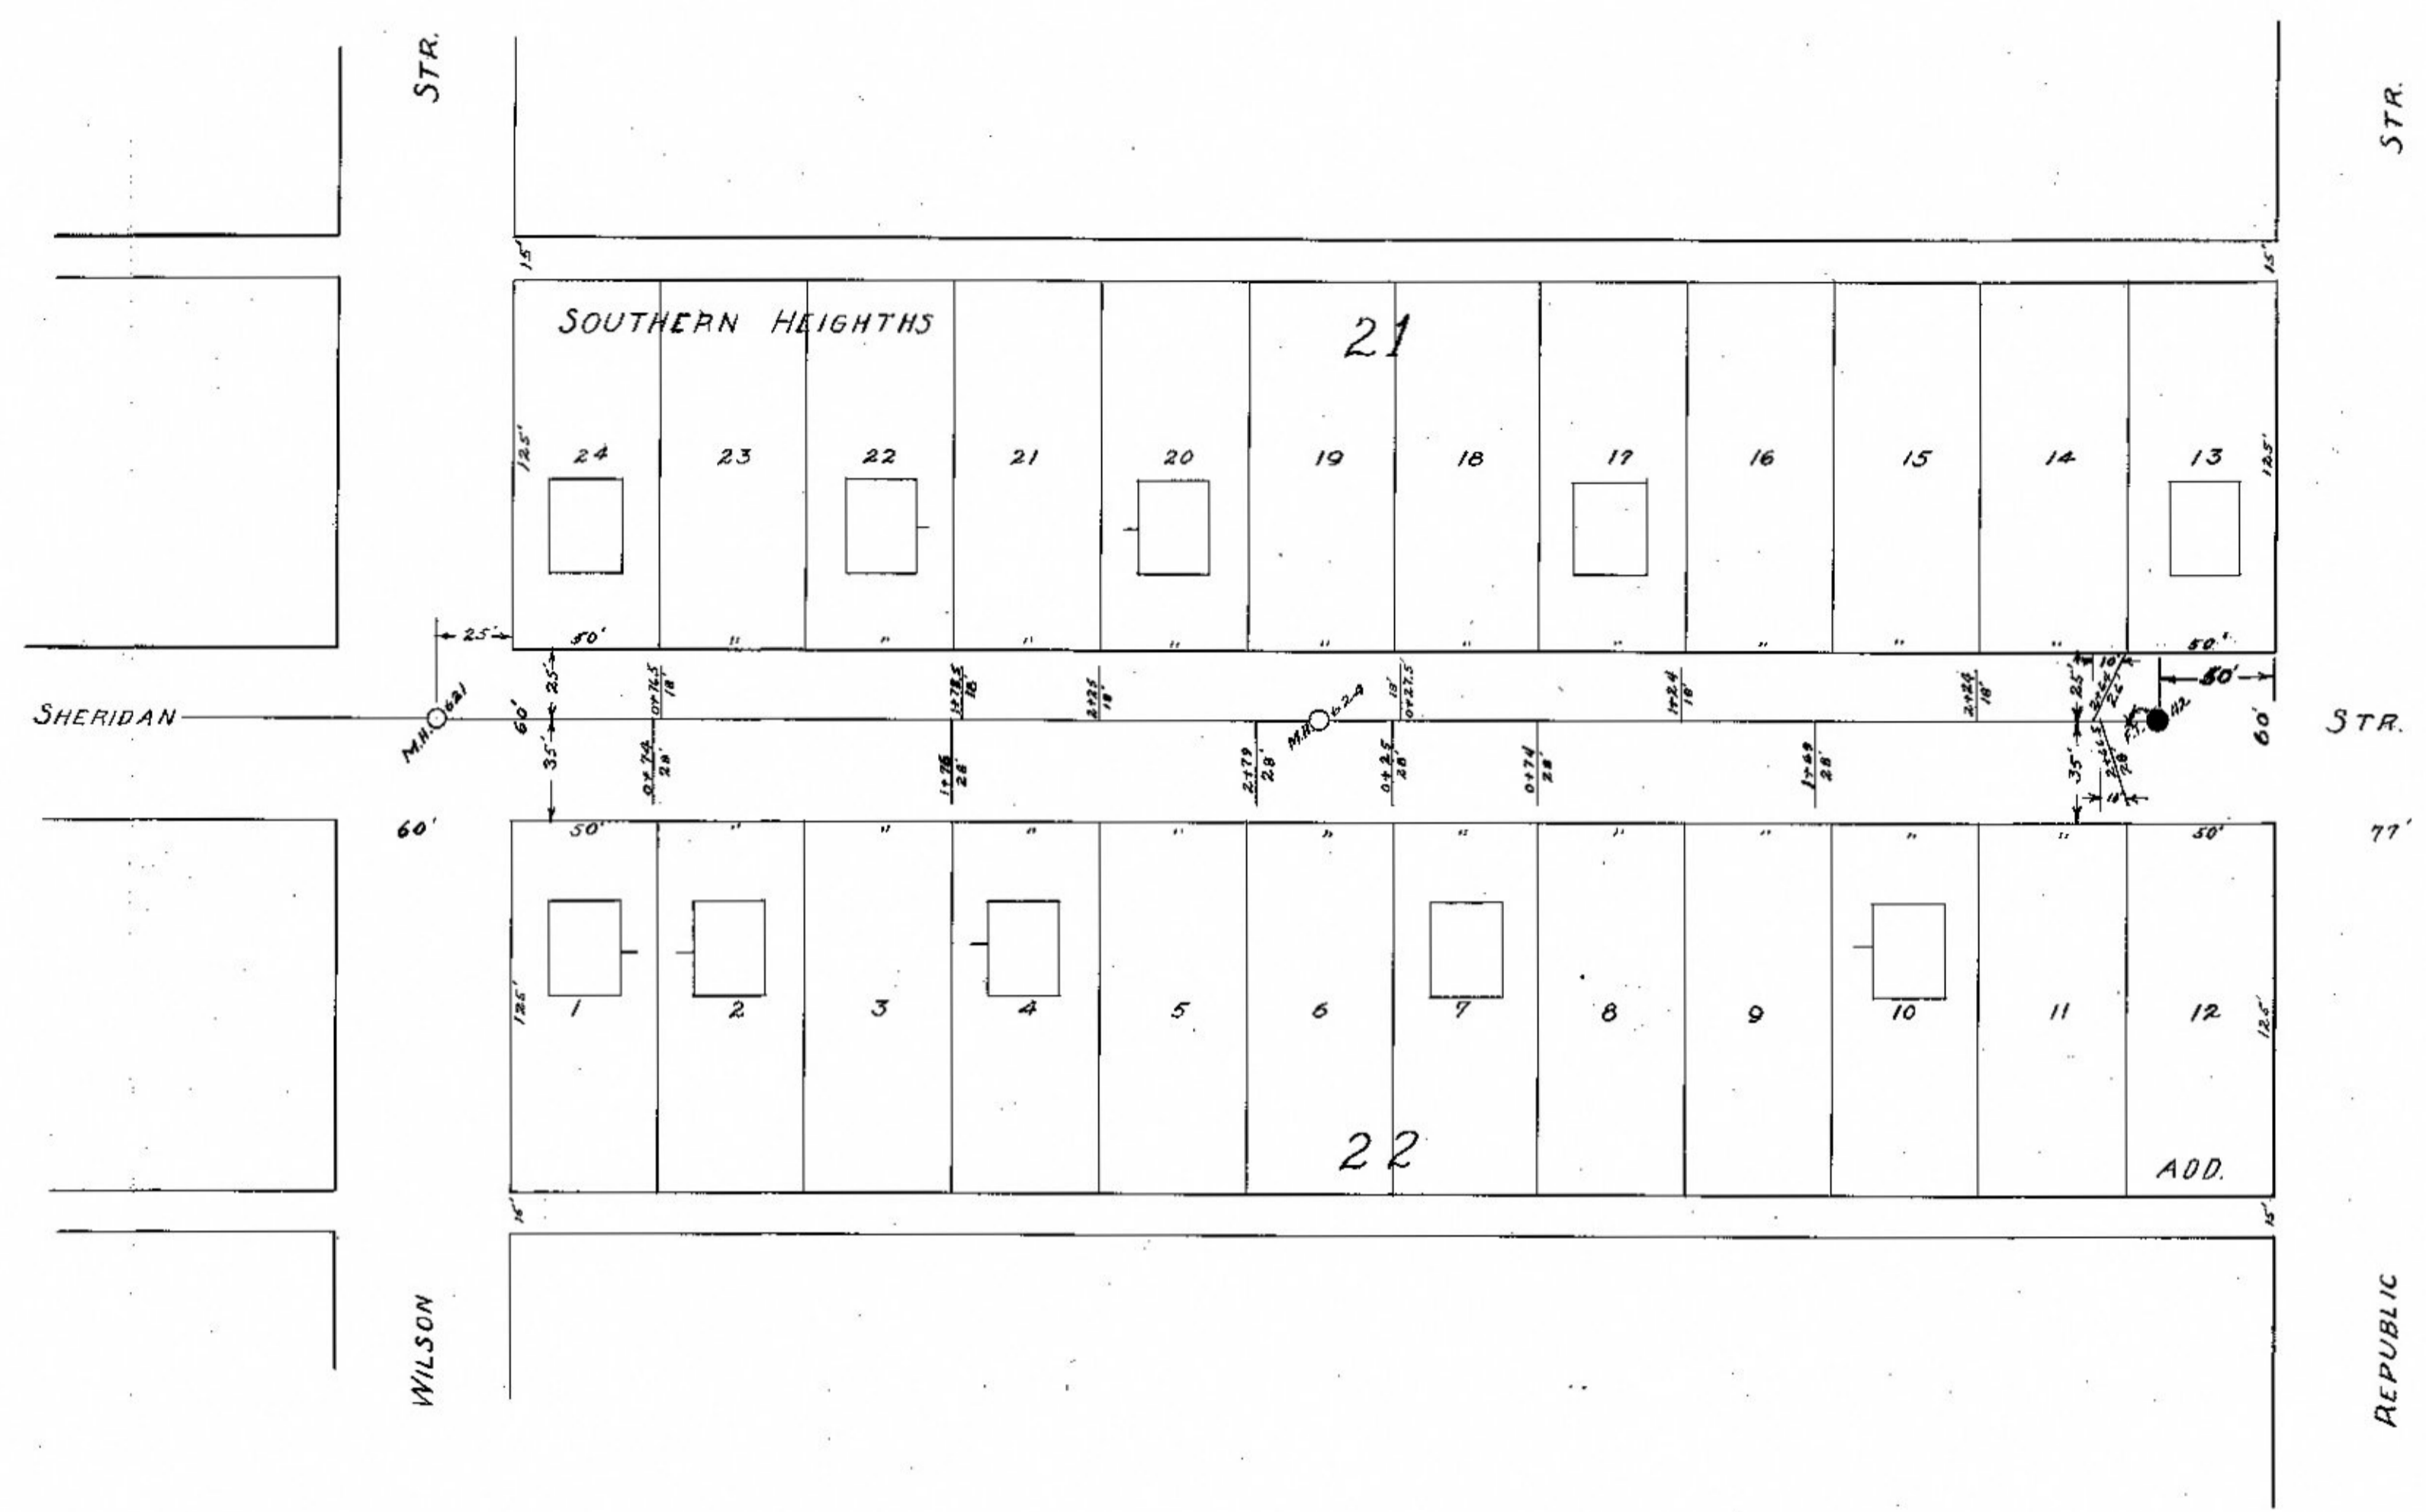

CONSTRUCTED: MAY, 1930
 CONTRACTOR: P. C. SNYDER
 ENGINEER: R. J. PAULITTE

SHERIDAN STREET

LATERAL SANITARY SEWER No. 157